
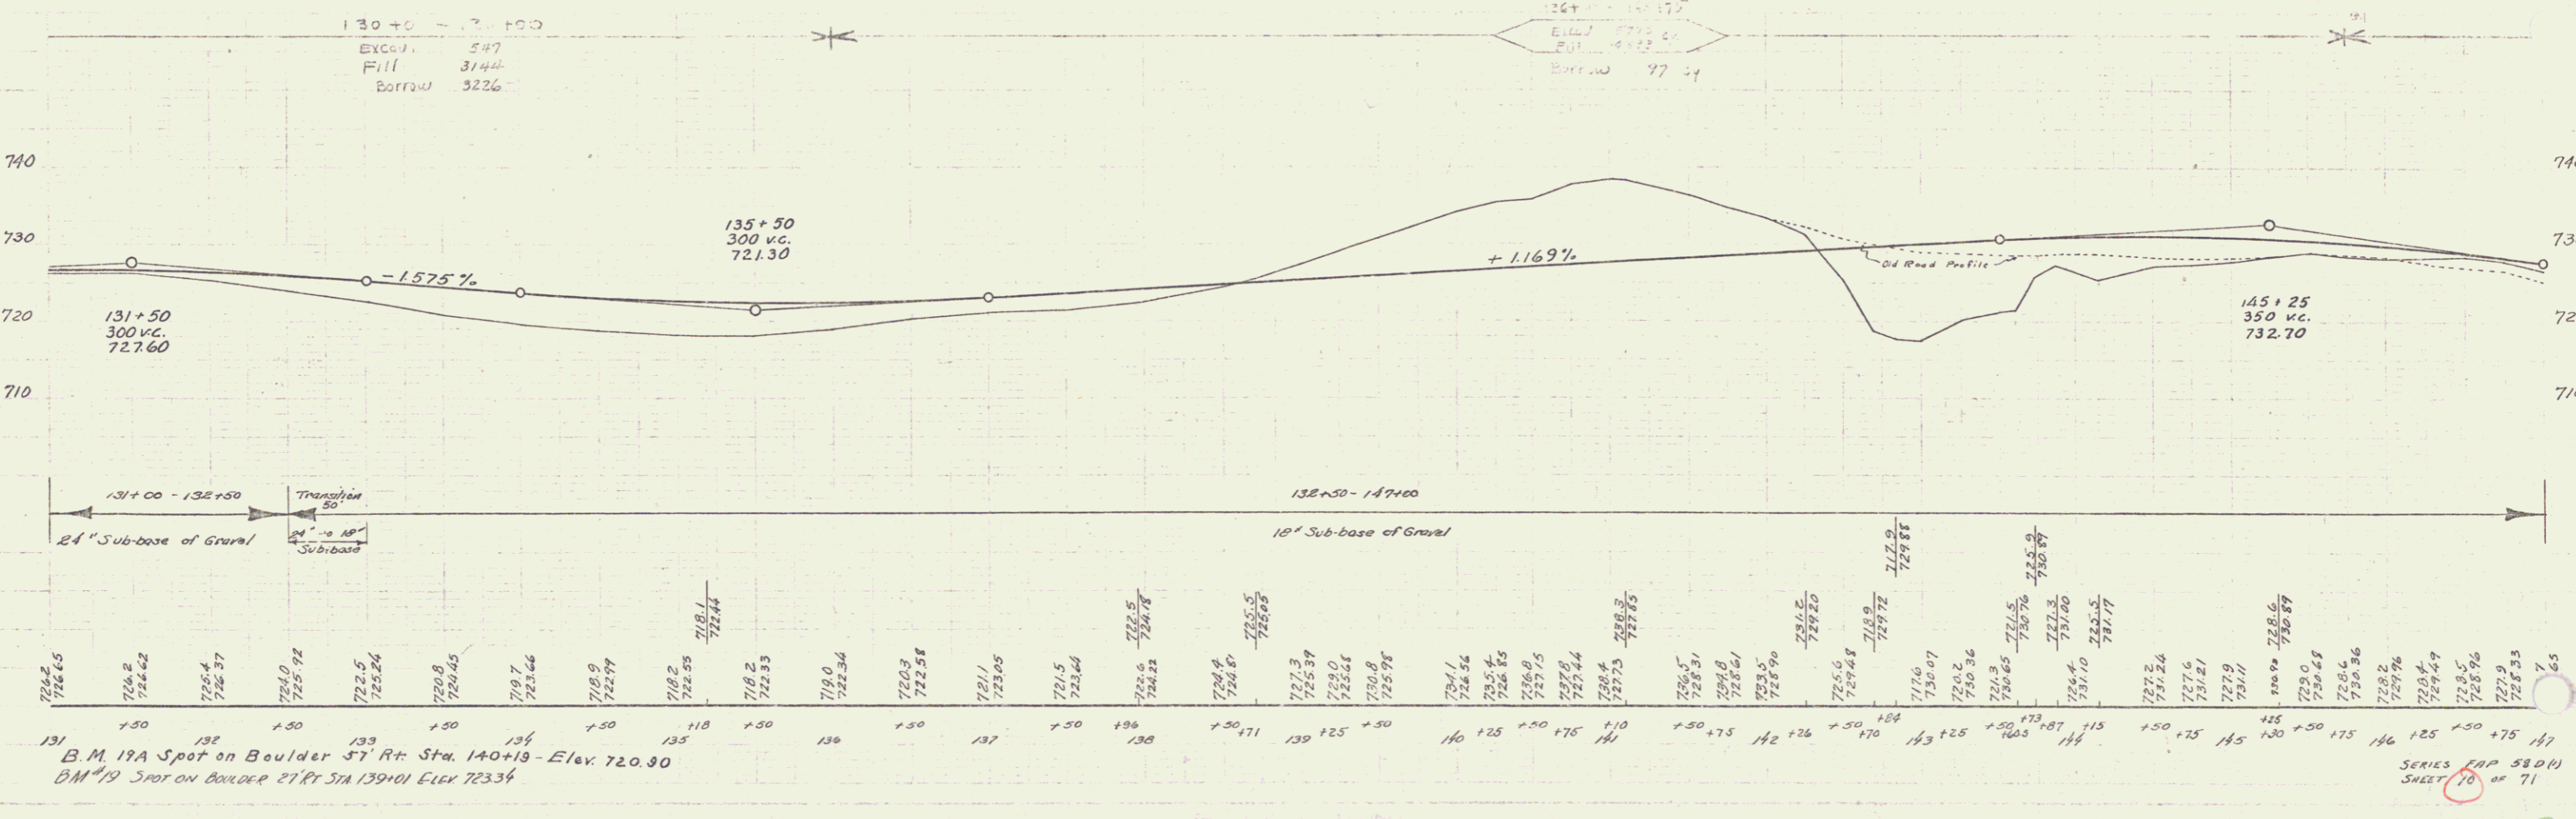


PARCEL INSTRUMENT DATE GRANTOR GRANTEE RECORDED REMARKS
 R.B. W.D.G.E. 9-18-40 WILLIAM & FANNIE PROLOVEY ST OF HT MT HOLLY BOOK PAGE DATE
 25 170-1 9-27-40

Δ 19° 13' 11"
 D 2'-30"
 R 2292.0
 T 303.0
 L 768.7
 E 32.6

5800 1940 10 71
 5800 1941 10 71

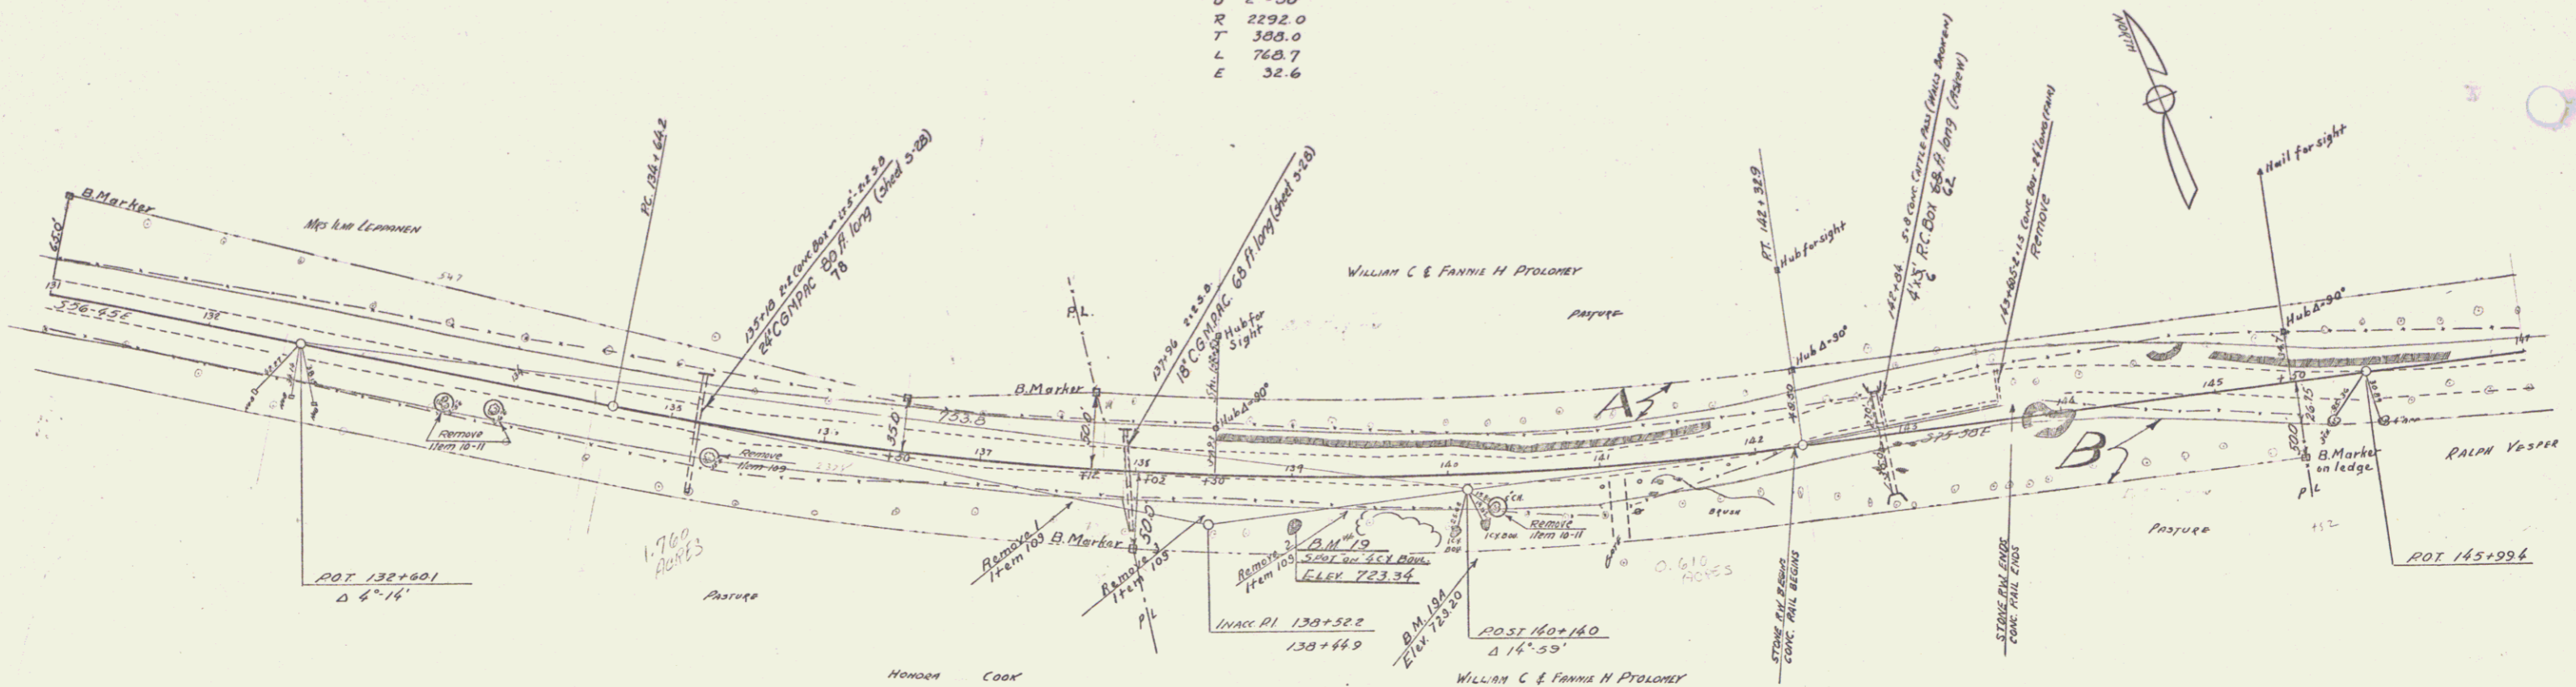

131 B.M. 19A Spot on Boulder 57' Rt. Sta. 140+19 - Elev 720.90
 B.M. 19 Spot on Boulder 27' Rt. Sta. 139+01 Elev 723.34
 SERIES MAP 5800
 SHEET 10 of 71