


Note: Attention of the Engineer is called to details of construction for side road approaches as shown on cross-section at sta. 153+70 LL & R.

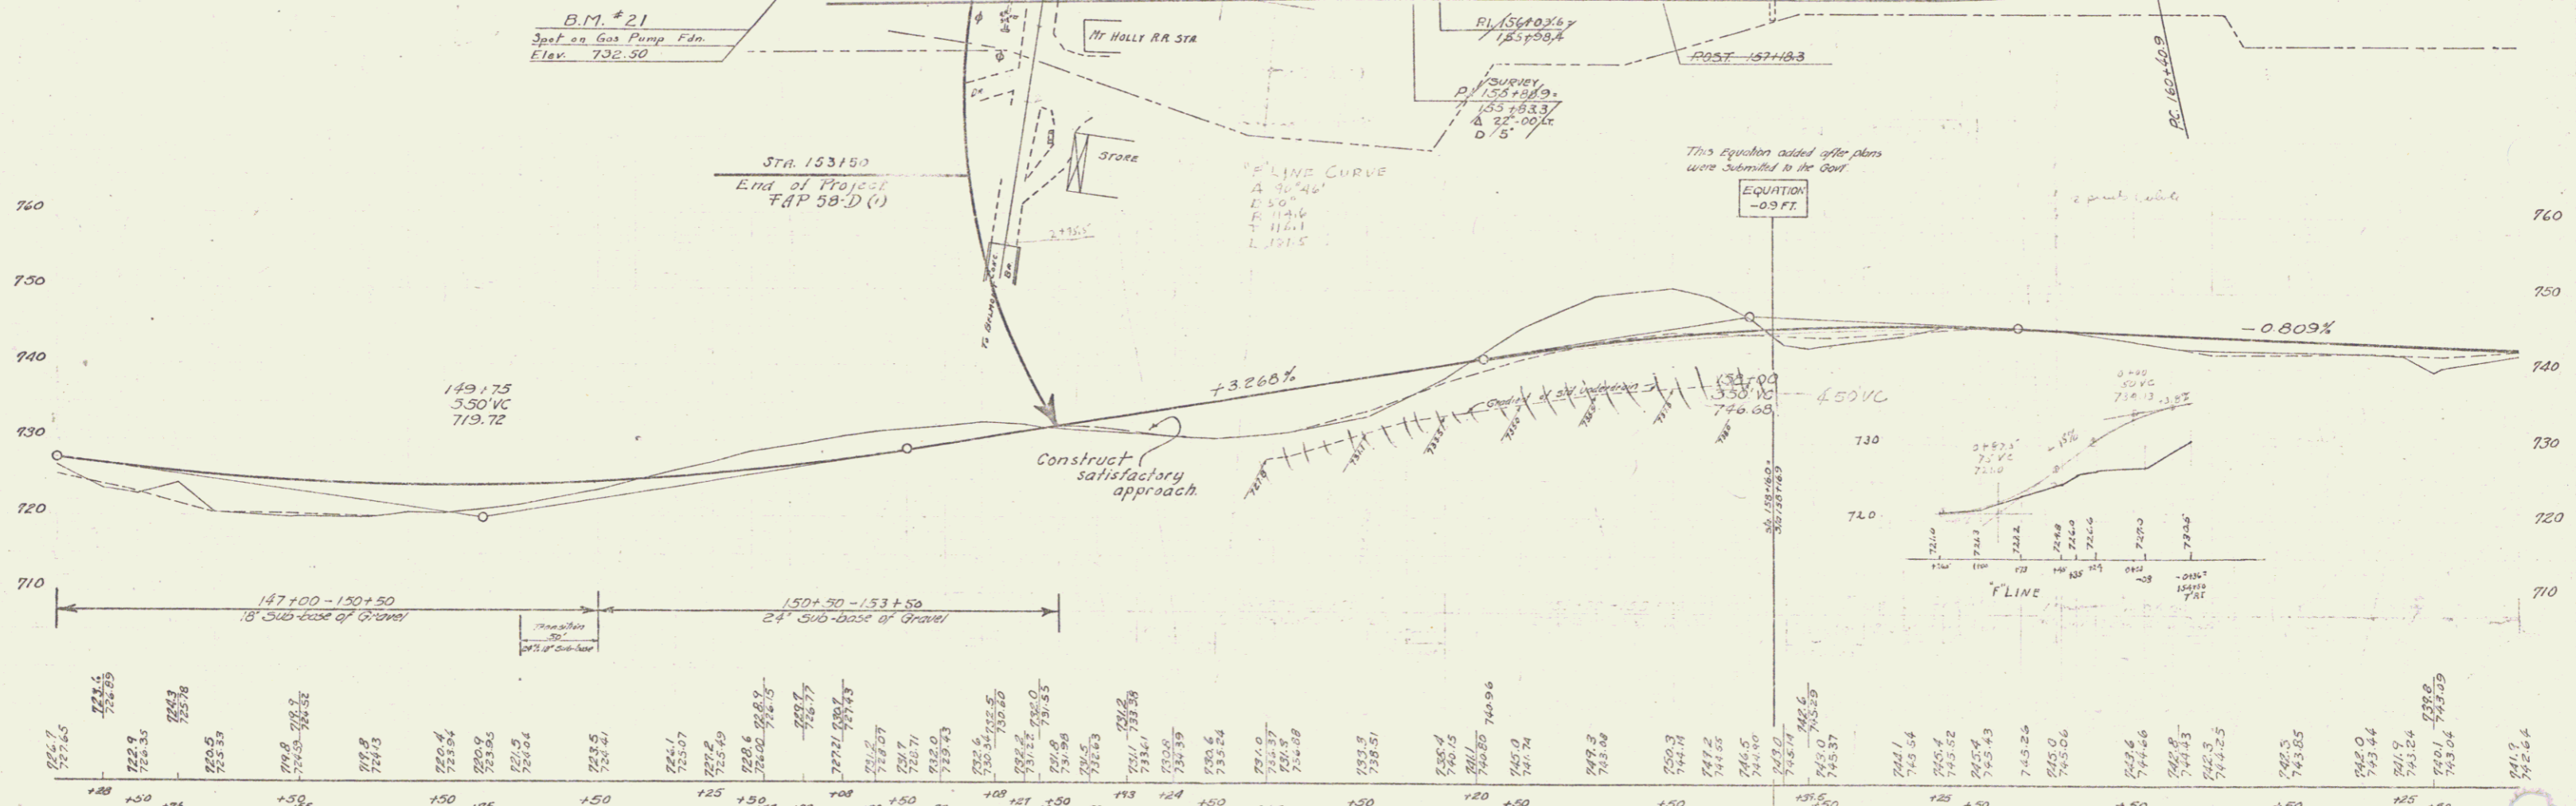

147	148	149	150	151	152	153	154	155	156	157	158	159	160	161	162	163
726.1	726.5	726.8	727.1	727.4	727.7	728.0	728.3	728.6	728.9	729.2	729.5	729.8	730.1	730.4	730.7	731.0

B.M. 20 Spot on Ledge 21' Lt. Sta. 147+71. Elev. 726.00
 B.M. 21 Spot on Gas Pump Fdn. 13.5' Rt. Sta. 153+05 Elev. 732.50.
 B.M. 22 Spot on Boulder 400' Lt. Sta. 160+63 Elev. 746.17
 B.M. 20A Spot on Boulder 80' Lt. Sta. 149+20 Elev. 725.33
 B.M. 21A Top Ret. Wall Sta. 154+ Elev. 732.94
 B.M. 21B S.I.R. 36" Elm Lt. Sta. 154+00 Elev. 734.25

SERIES FAP 58-D (1)
Sheet 11 of 71
See Next Sheet