


The area of inlet of the brook to be treated off a slope of swamp.

Note: Buildings to be moved, as per right of way agreement, by the property owner.

Note: This area to be leveled off so as to eliminate water pockets between the main road and the approach road.

Note: Muck that is removed through the section Sta. 29+00 to Sta. 30+00, this material is to be used as far as necessary to fill the swamp area right of the 30+00; this material to be leveled off satisfactory to the Engineer and any muck material not used at this location is to be used on the flattening of slopes as directed by the Engineer.

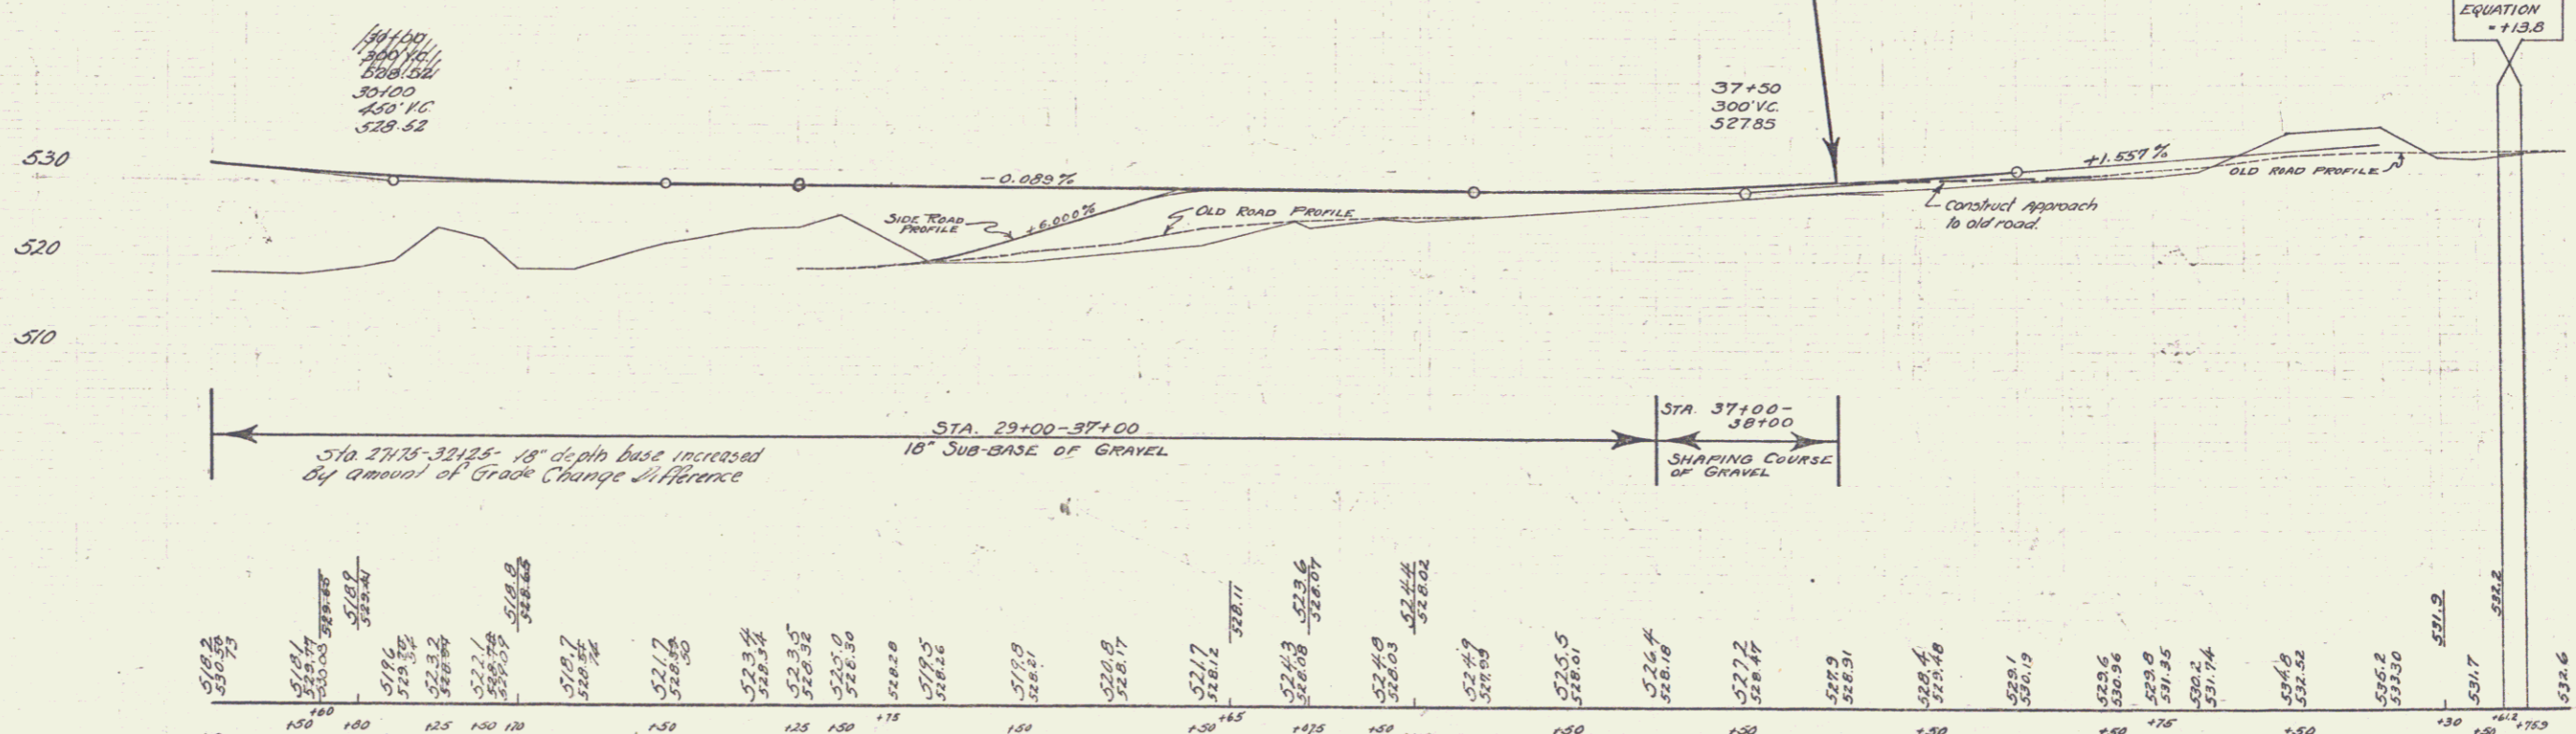

Sta. 29+00-37+00
 10" SUB-BASE OF GRAVEL

Sta. 37+00-38+100
 SHAPING COURSE OF GRAVEL

Station	Elevation
29+00	528.75
29+10	528.75
29+20	528.75
