
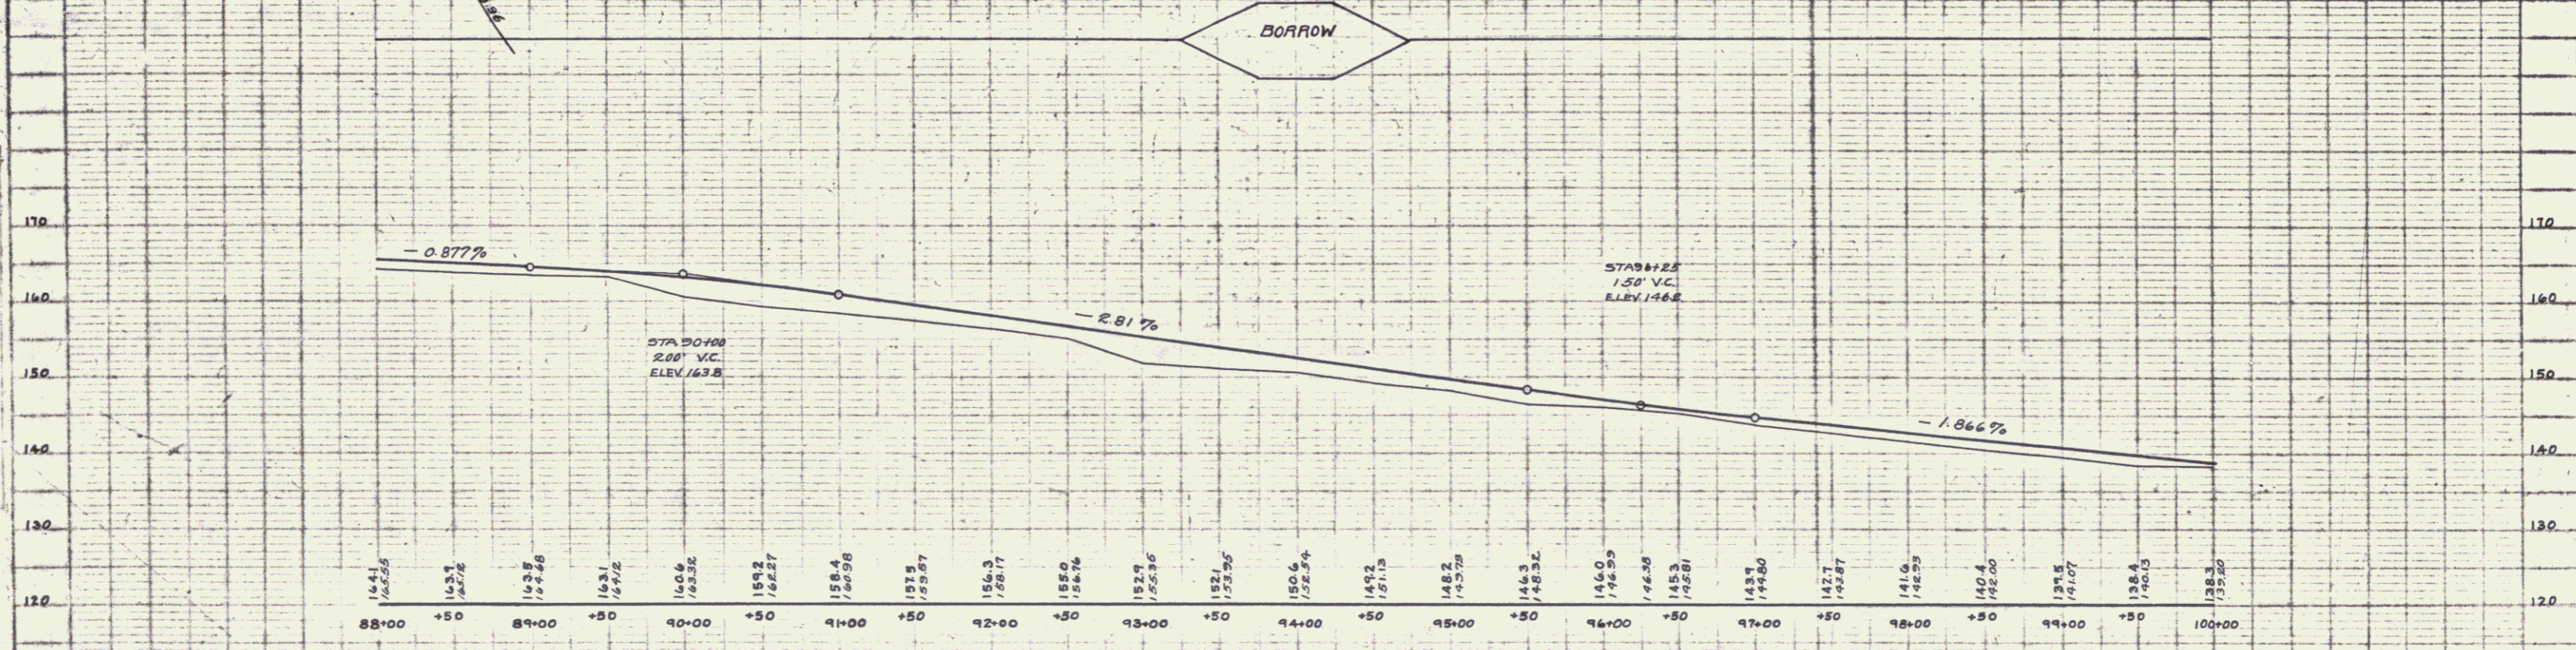


PLAN  
 PUTNAM  
 ADWOOD

ELEVATION  
 ADWOOD

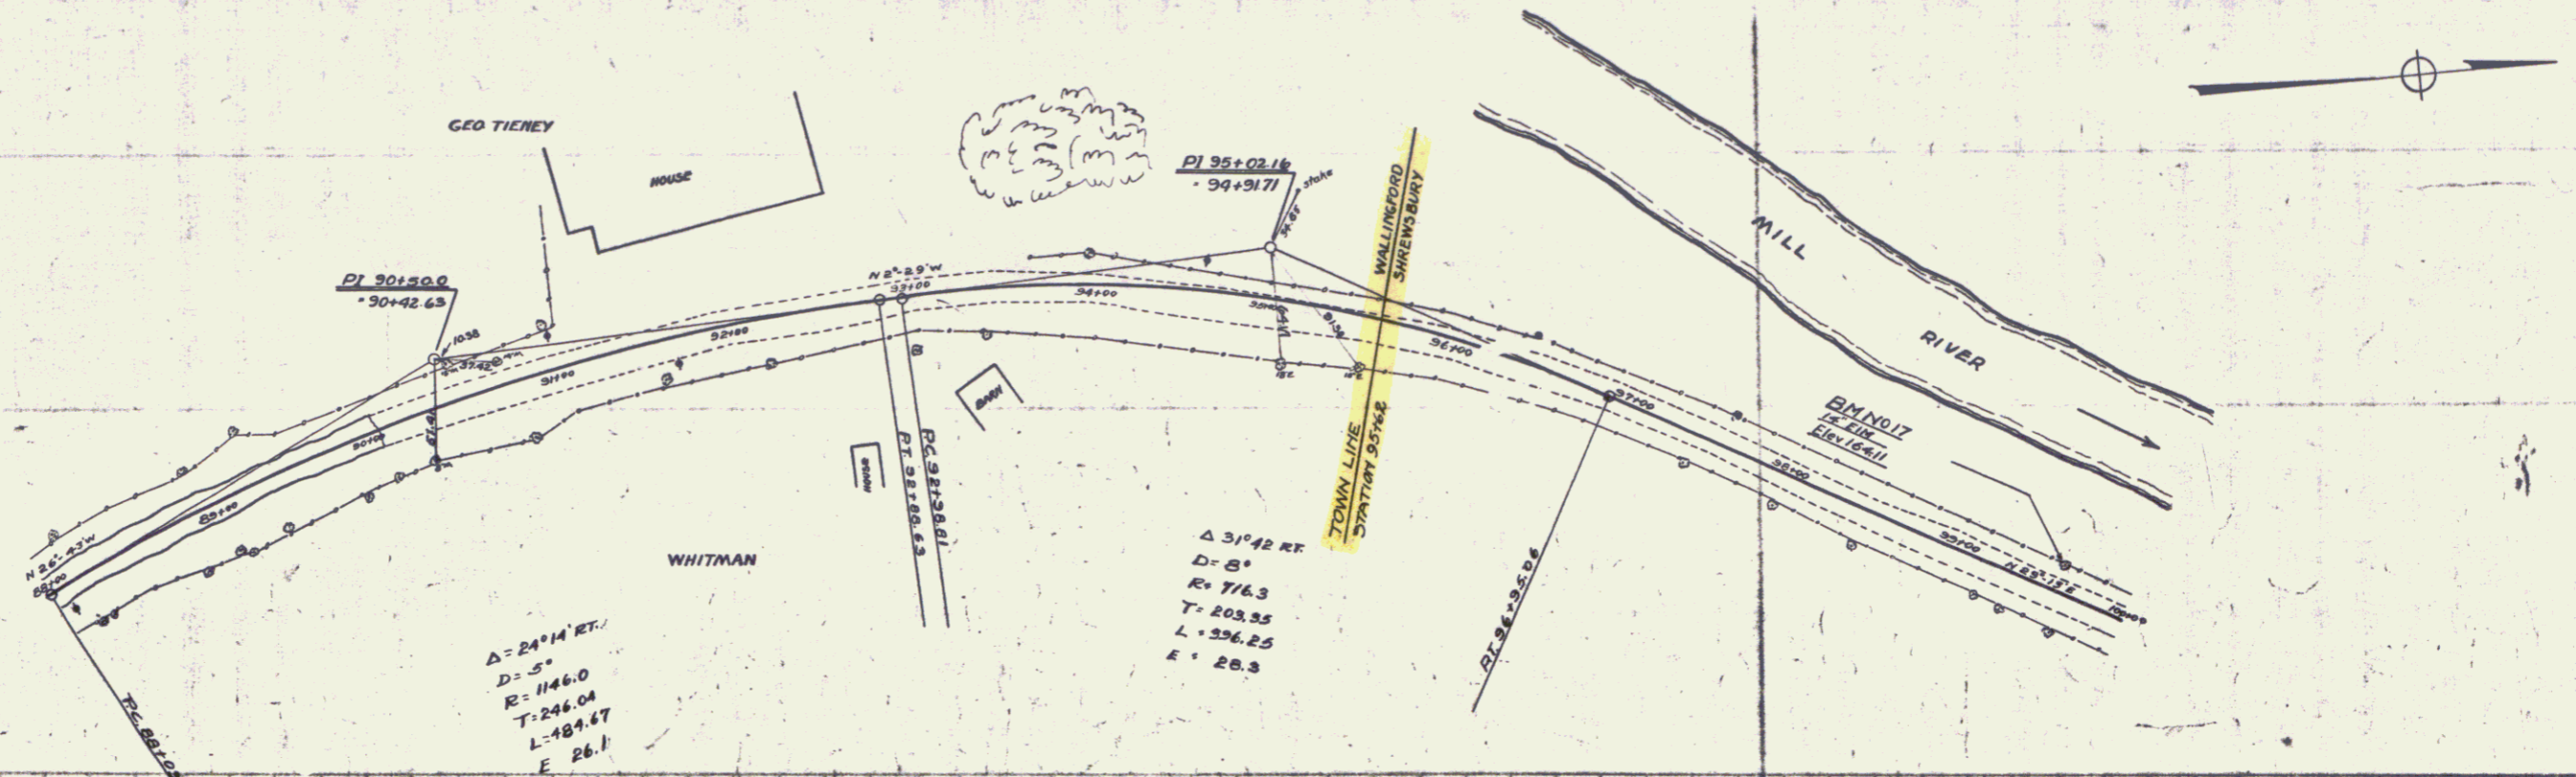

B.M. NO 17 Spike in 14" Elm West of Sta 99+59 Elev 164.11 50' South of Nickols & Barney Sign