

WOOD GUARD RAIL REQUIRED

ON LEFT

STA 124+00 - 124+100 LENGTH 2+00

ON RIGHT

STA 124+100 - 124+200 LENGTH 2+00

CABLE GUARD RAIL REQUIRED

ON LEFT

Sta 113+50 - 114+25 Length 70 FC.


NEW CULVERTS REQUIRED

Sta 122+50 New 15" Reinforced Concrete Pipe Length 40 ft.
One Joint with 400-Grate
Concrete Class A (1-2-4)
S (1-2-4)
Reinforcing Steel
1.6 Curbs
2.8 Curbs
131 Angles

FED. ROAD DIST. NO.	PLATE	FED. PROJ. NO.	FISCAL YEAR	SHEET NO.	TOTAL SHEETS
110A	1928	11	64		

REVISIONS

NO.	DATE	DESCRIPTION
1	1928	AS SHOWN

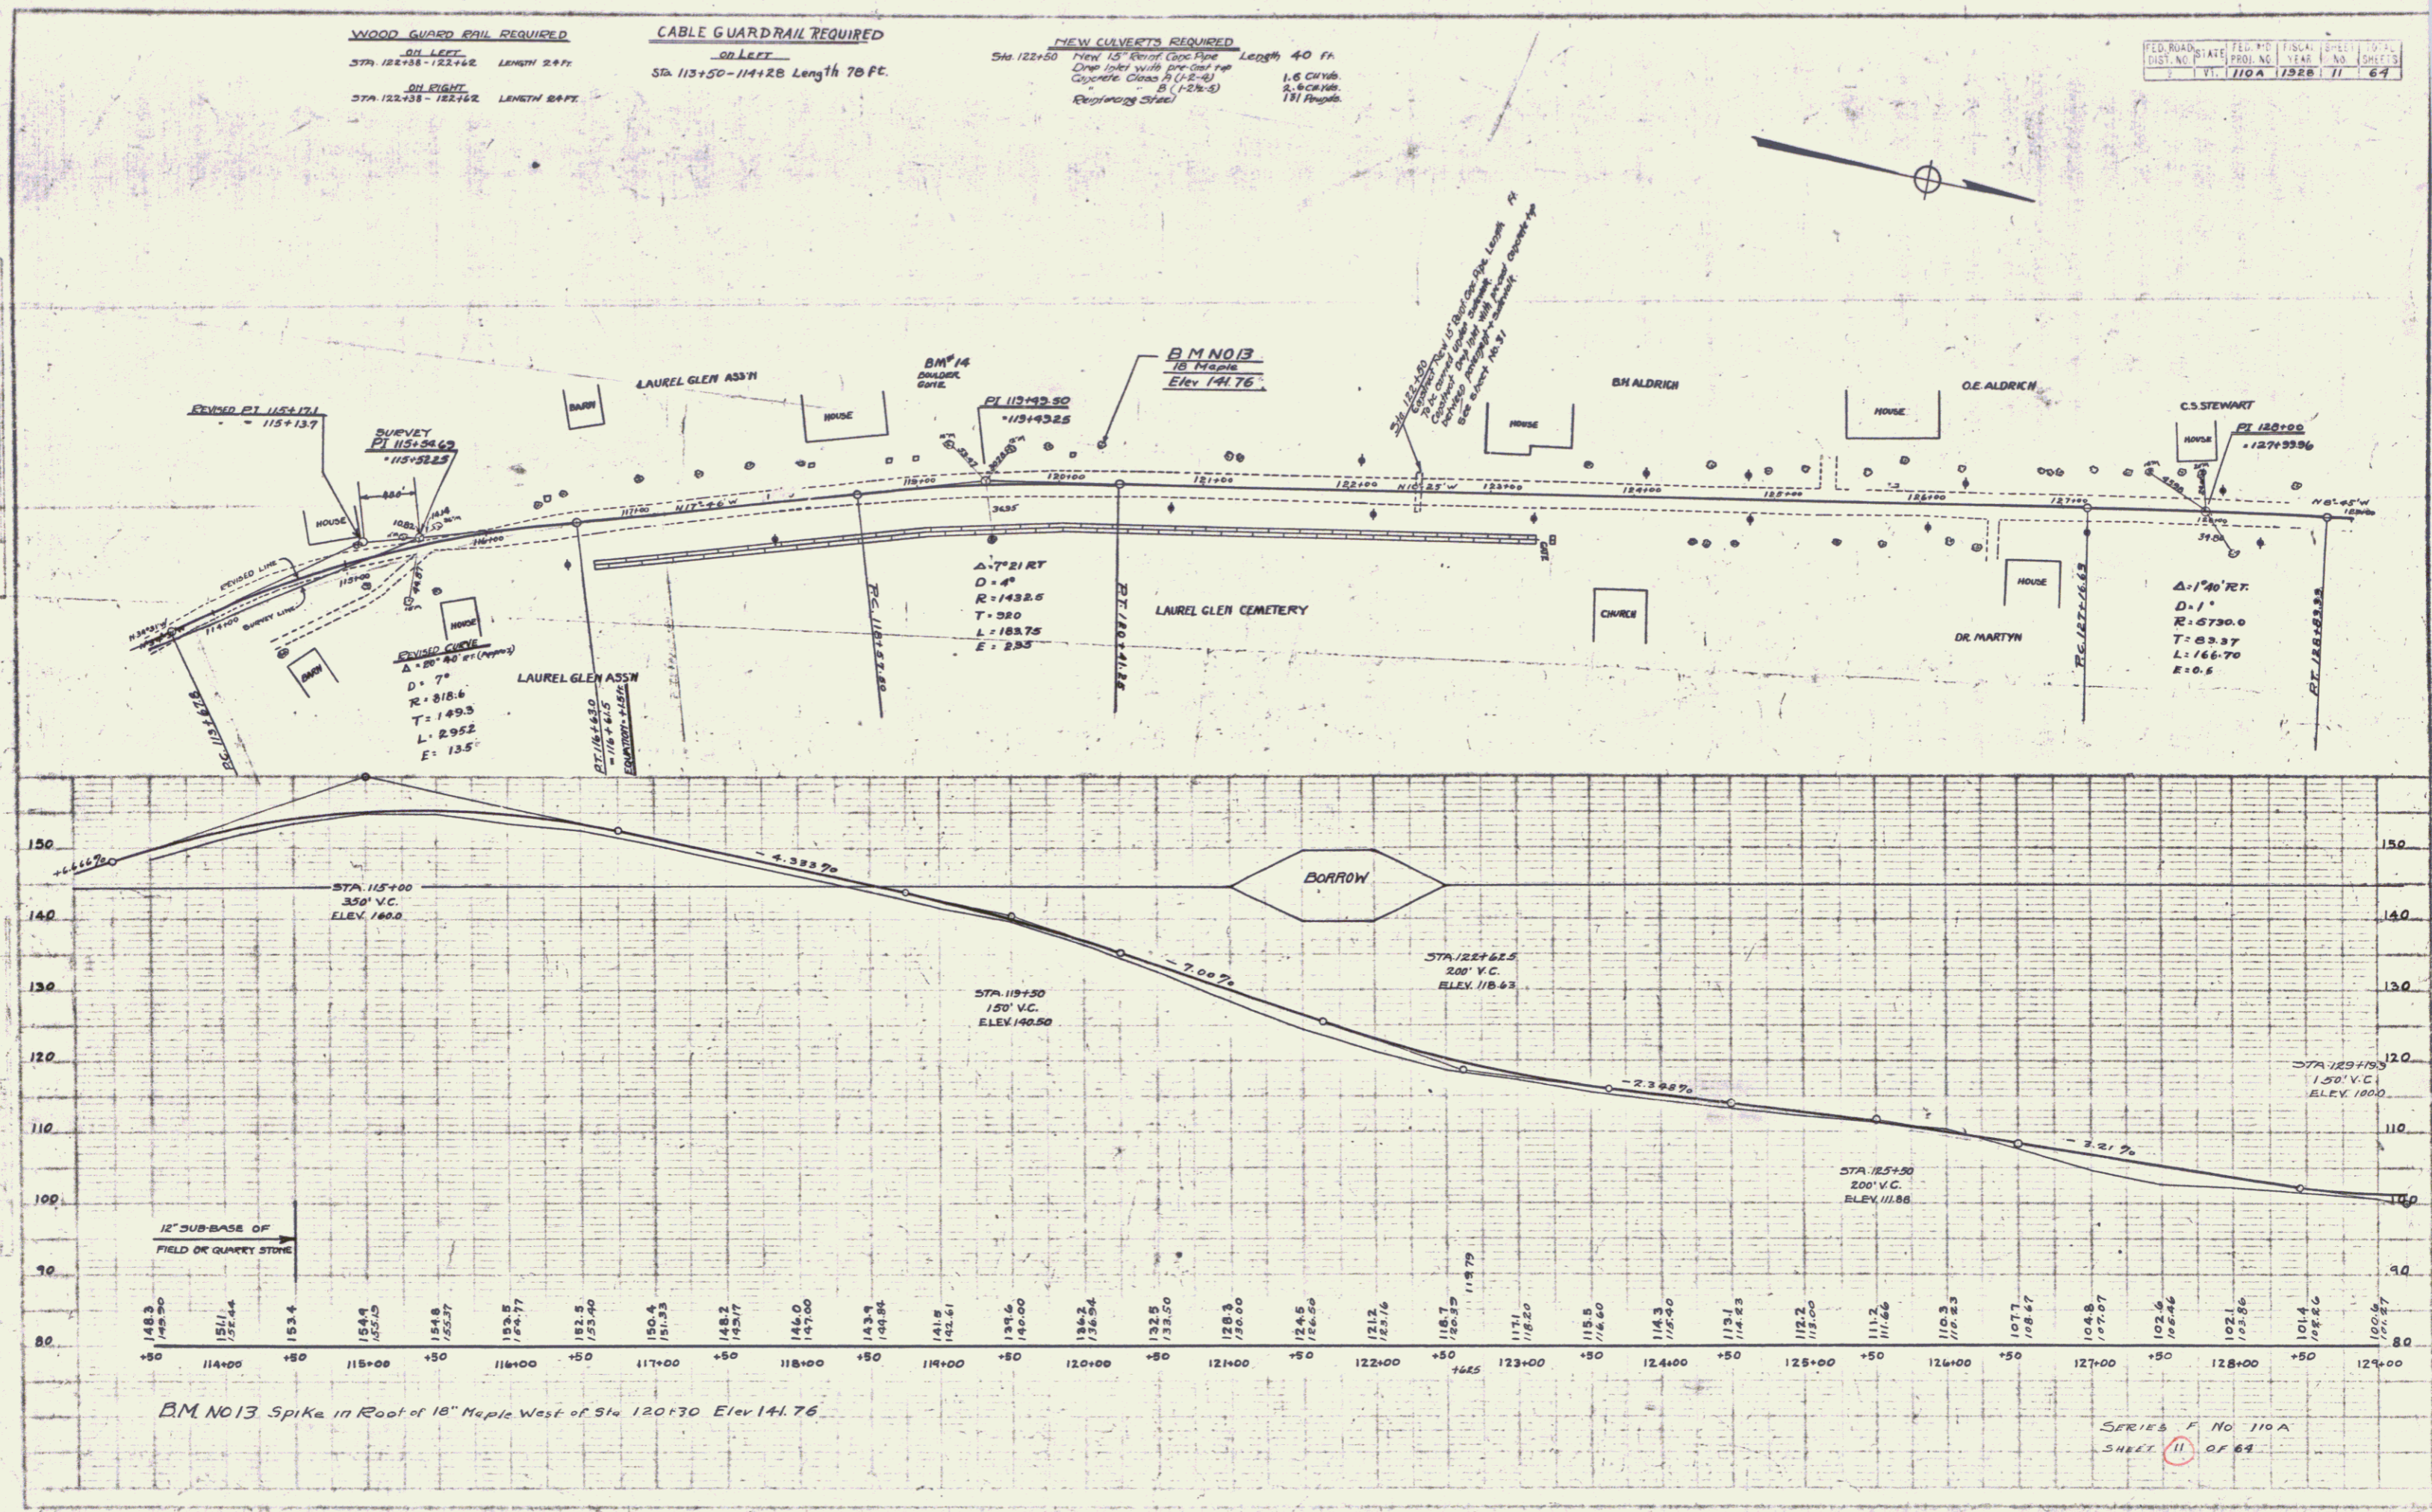

BM NO 13 Spike in Root of 18" Maple West of Sta 120+30 Elev 141.76

SERIES F NO 110 A SHEET 11 OF 64

10