


CONSTRUCT DRIVES	
LEFT	RIGHT
Sta 48+00	Sta 51+50
	25

LIMITS OF CLEARING & GRUBBING		POST WAR F A PRIMARY
STA. TO STA.	Pos.	
42+00-45+00	Rt.	
42+62-47+00	Lt.	
47+00-49+00	Lt.	

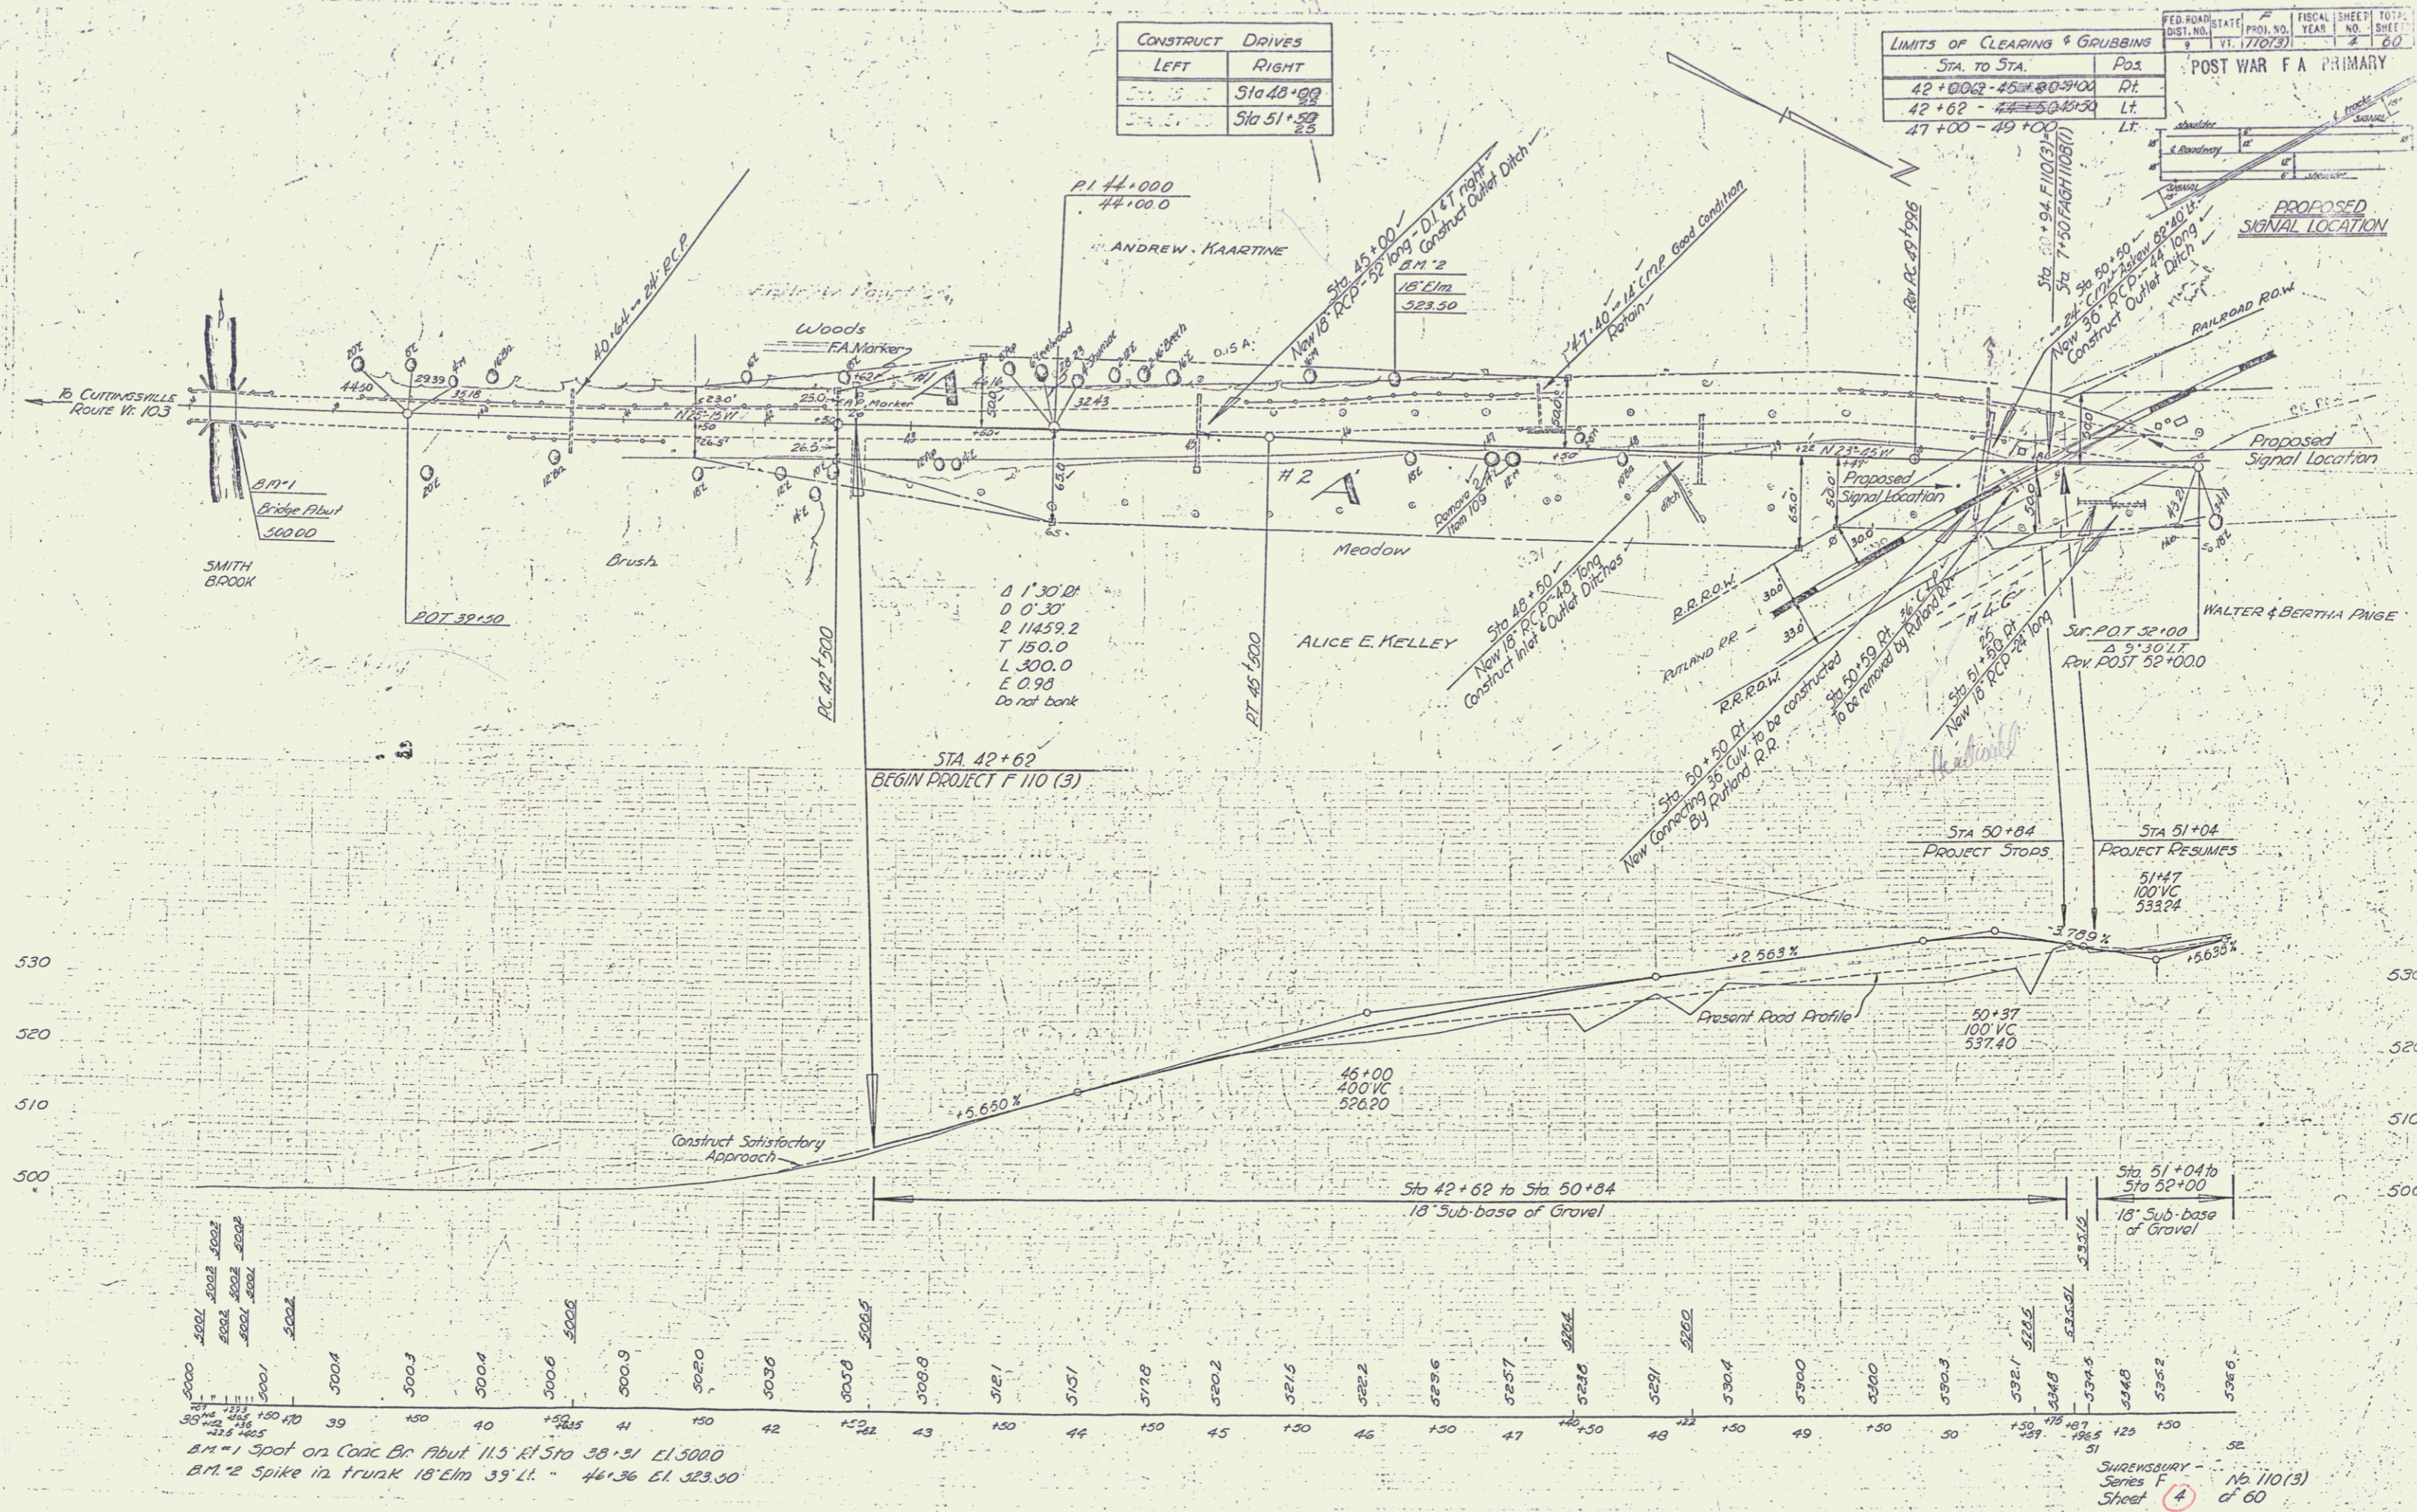

B.M. #1 Spot on Conc Br Abut 11.5 R1 Sta 38+31 LI 5000
 B.M. #2 Spike in trunk 18' Elm 39' LI 46+36 EI 523.50

SURESBURY -
 Series F -
 Sheet 4 of 60