


CONSTRUCT DRIVES	
LEFT	RIGHT
	.67+00

LIMITS OF CLEARING & GRUBBING		
STA TO STA	POS	
53+00 - 55+00	RT	-
57+00 - 67+00	LT	-

PARCEL INSTRUMENT DATE GRANTOR GRANTEE

PARCEL	INSTRUMENT	DATE	GRANTOR	GRANTEE	RECORDED SHREWSBURY BOOK	REMARKS
1	51-084	1-28-48	ANDREW MARTINE	ST OF VT	17	622
2	51-099	3-23-48	WALTER & BERTHA PAIGE	ST OF VT	17	654

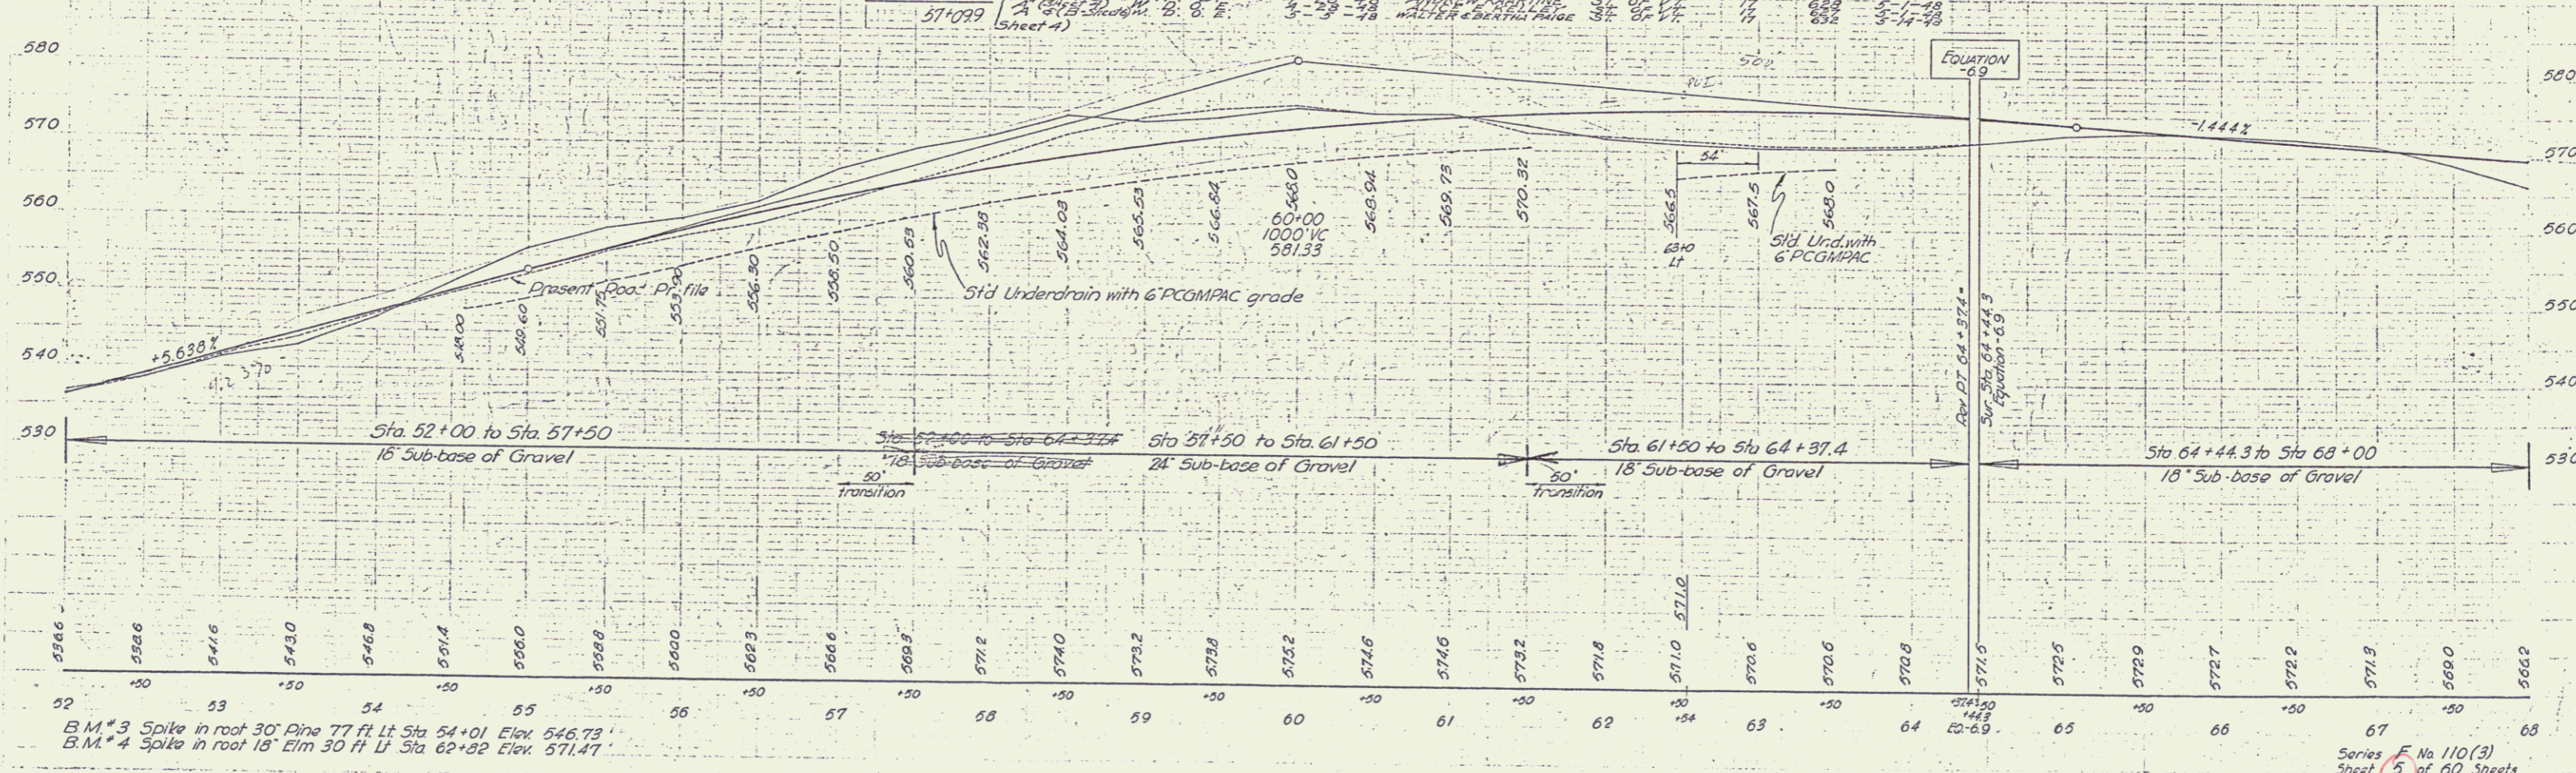

B.M. #3 Spike in root 30' Pine 77 ft Lt Sta 54+01 Elev. 546.73
 B.M. #4 Spike in root 18' Elm 30 ft Lt Sta 62+02 Elev. 571.47