
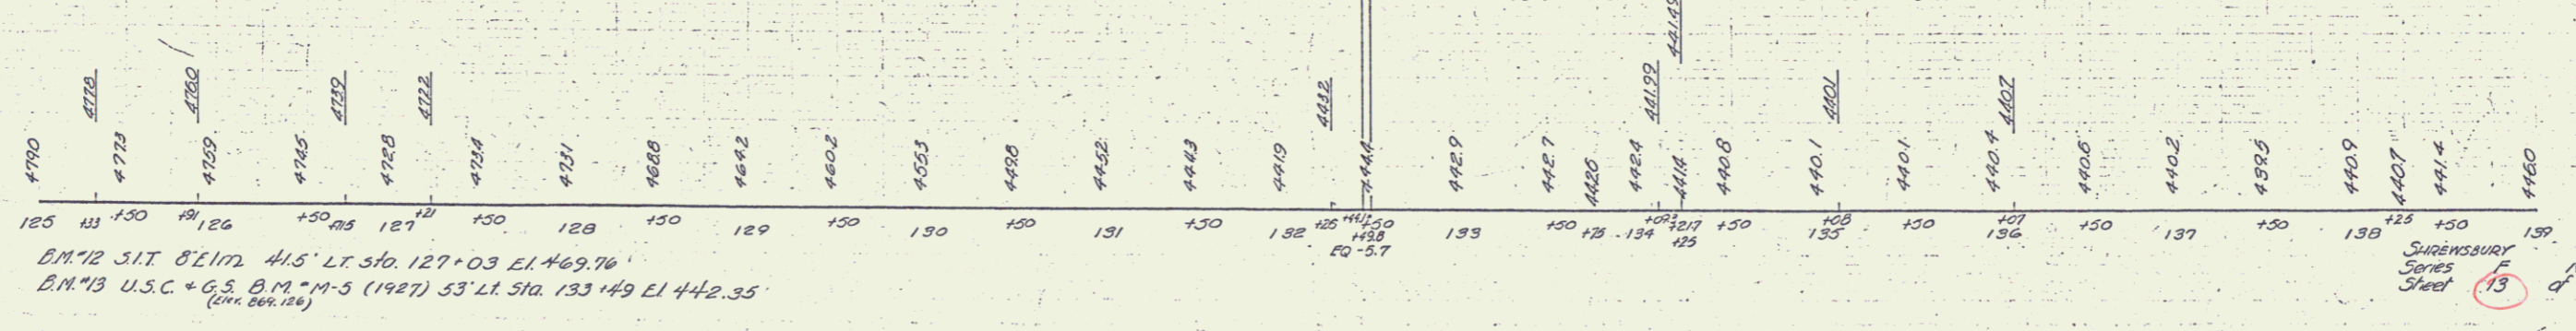


CONSTRUCT DRIVES	
LEFT	RIGHT
136+00	125+33
134+50	127+21
	132+26.00

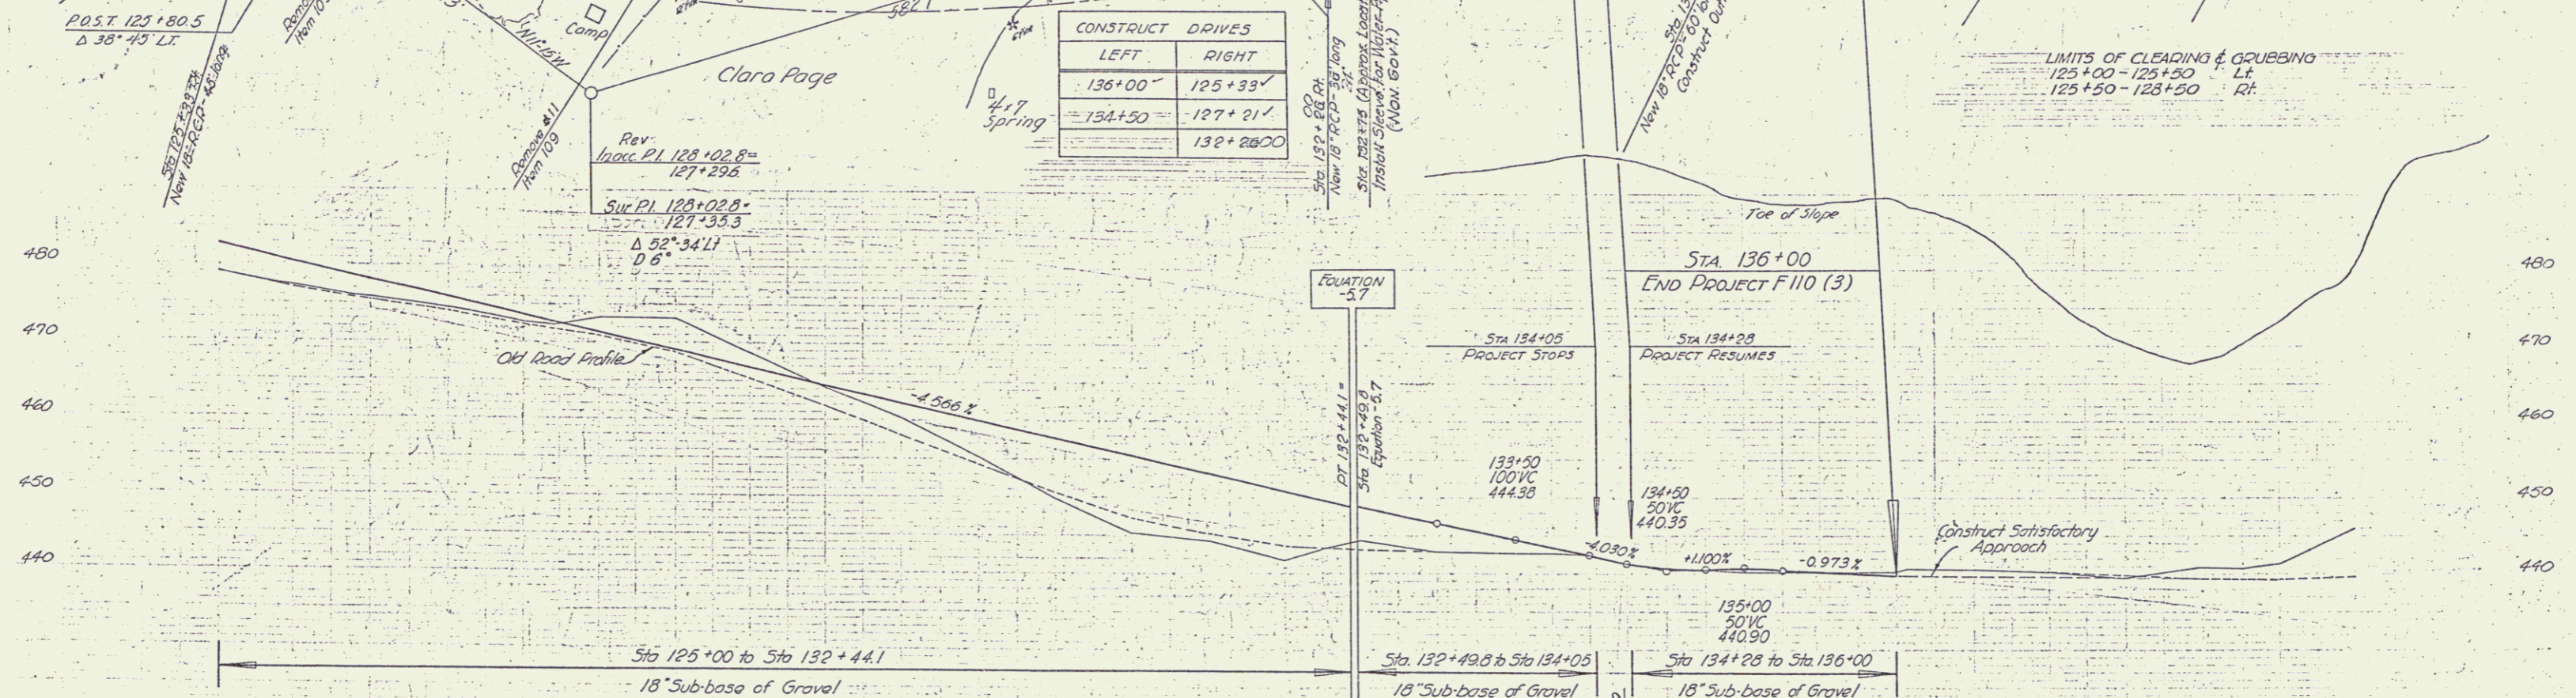

B.M. 12 S.I.T. 8' I.I.M. 4 1/2" L.T. Sta. 127+03 E.L. 469.76
 B.M. 13 U.S.C. + G.S. B.M. - M-5 (1927) 53" L.T. Sta. 133+49 E.L. 442.35
 SURREYSBURY Survey Sheet 13 of 60 No. 110(3)