
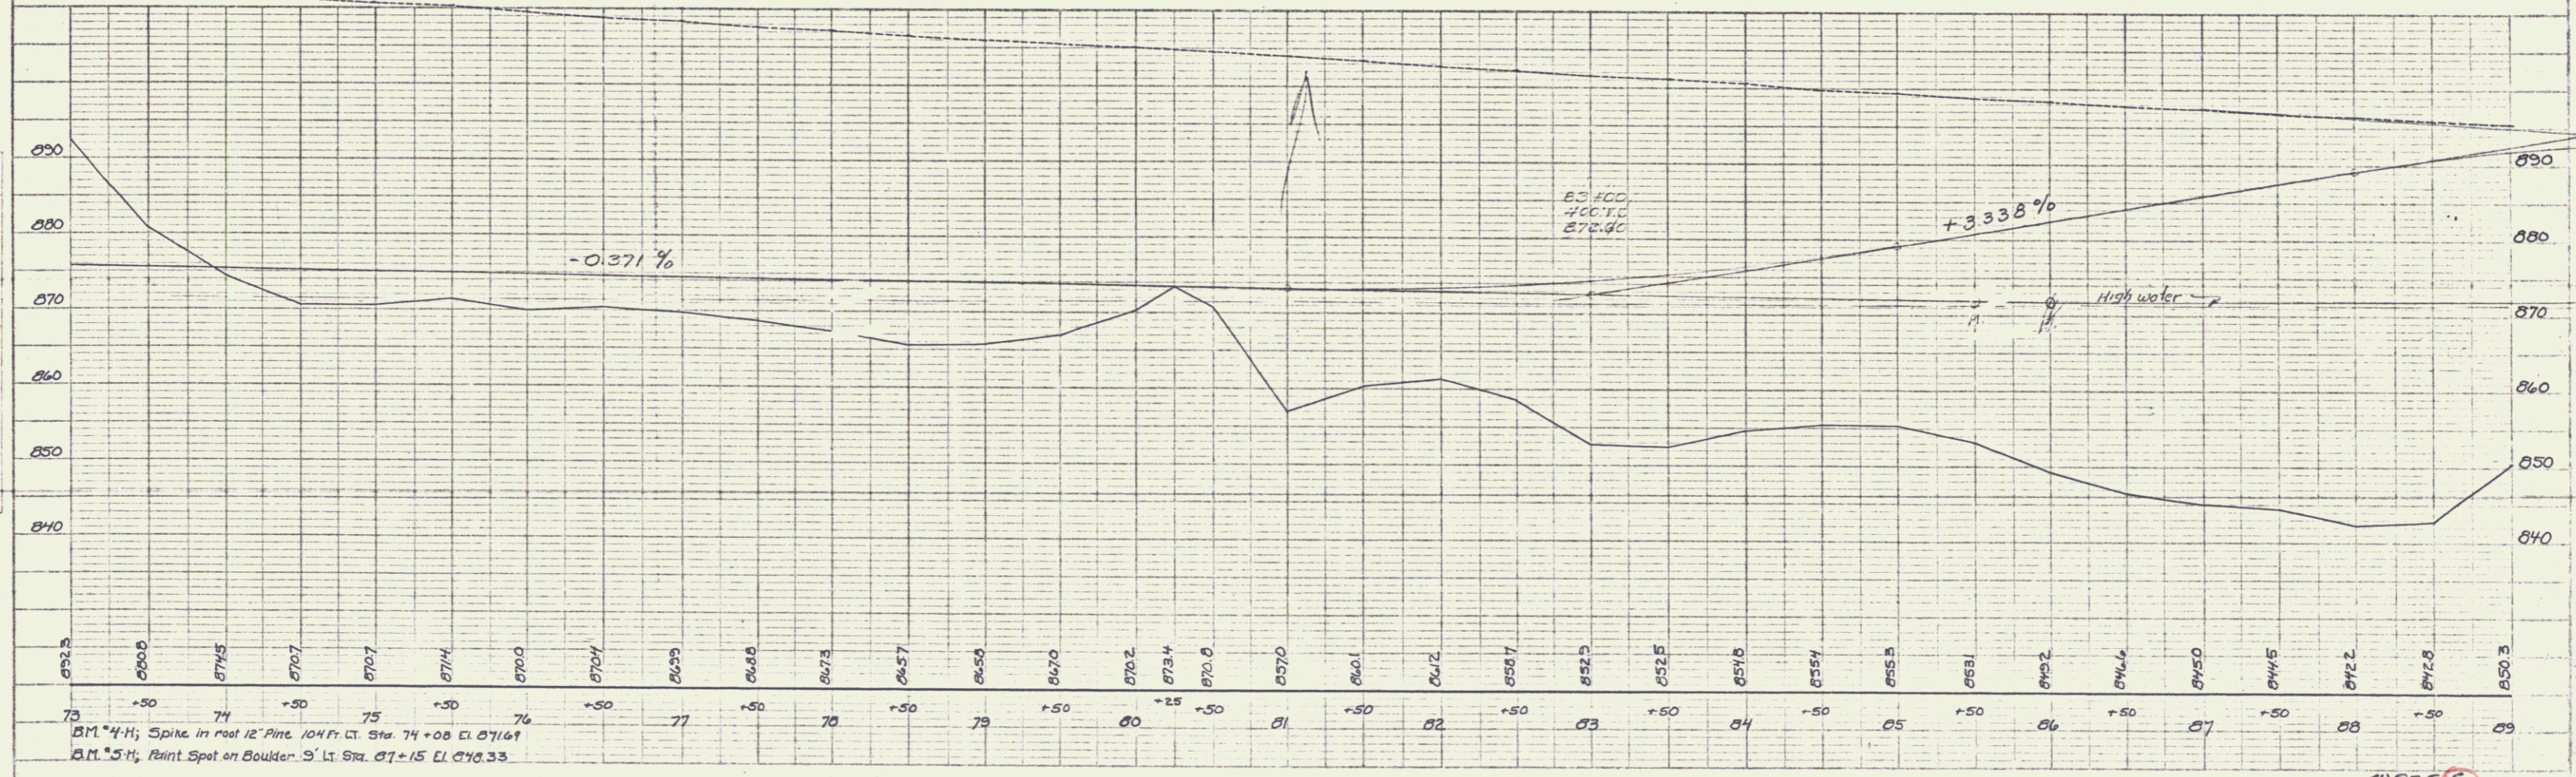


PLAN  
 DRAWN BY  
 DATE  
 CHECKED BY  
 DATE  
 SCALE  
 1" = 40'

PROFILE  
 DRAWN BY  
 DATE  
 CHECKED BY  
 DATE  
 SCALE  
 1" = 10'

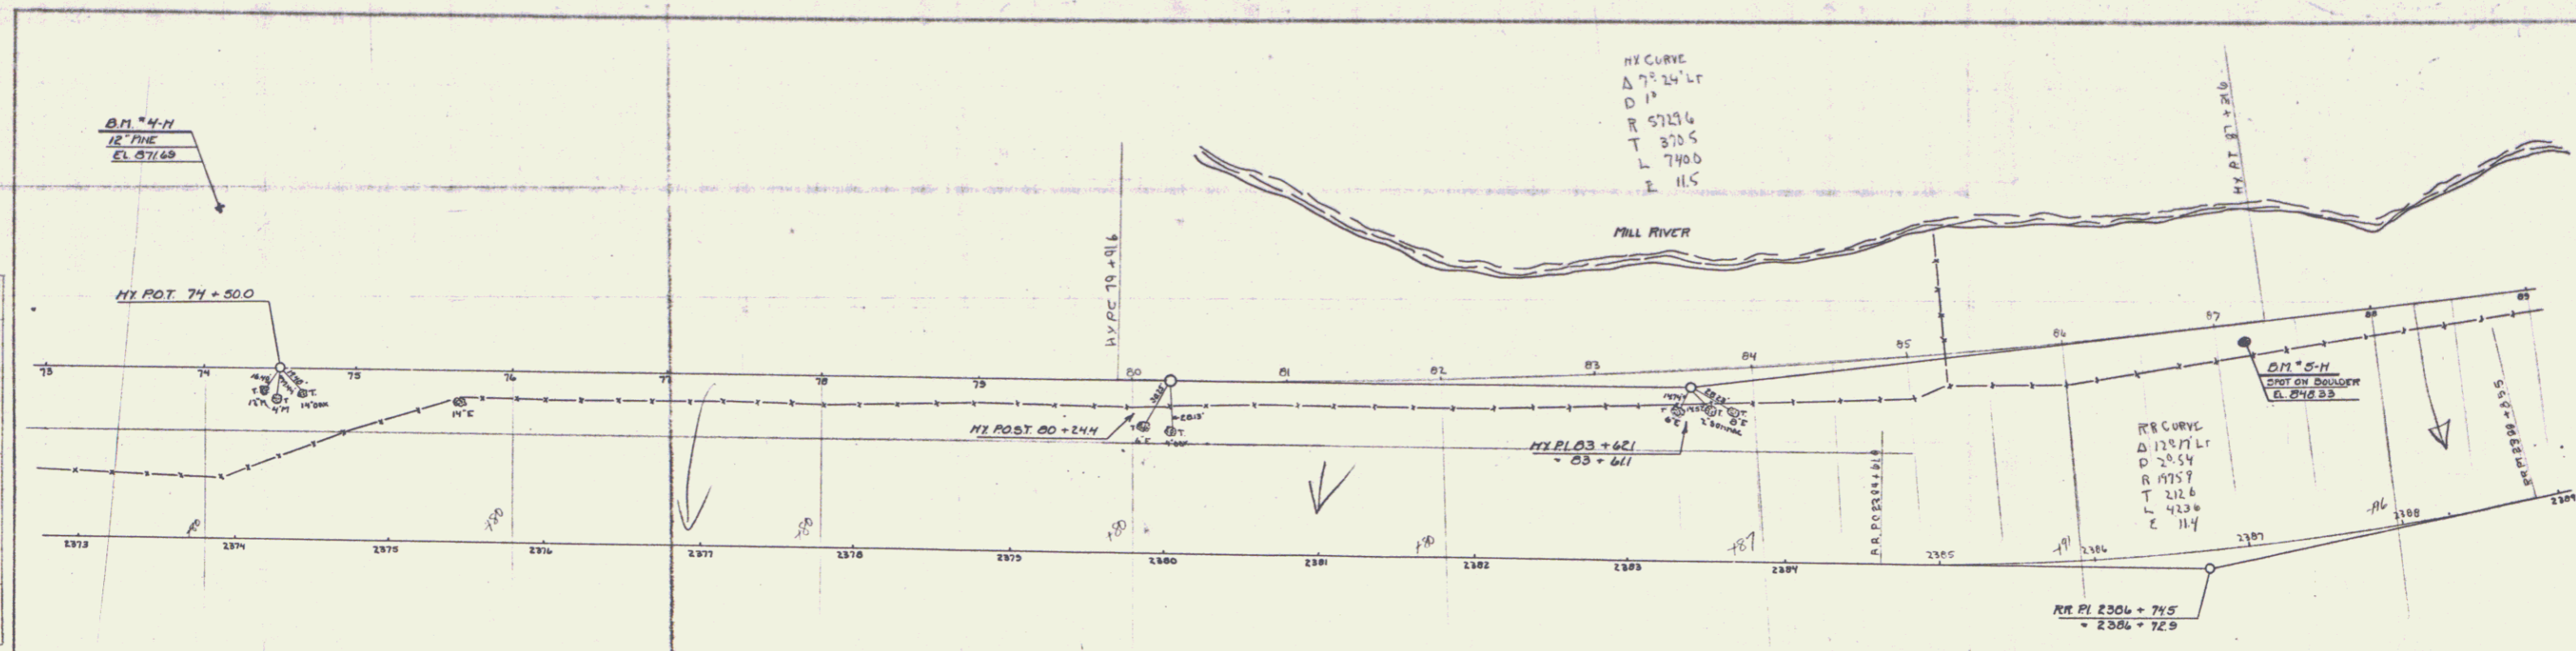

BM 4-H; Spike in root 12" Pine 104 Ft. Lt. Sta. 74 + 00 EL 871.69  
 BM 5-H; Paint Spot on Boulder. 9' Lt. Sta. 87 + 15 EL 876.33

DATE  
 DRAWN BY  
 CHECKED BY

SHEETS 110  
 45