
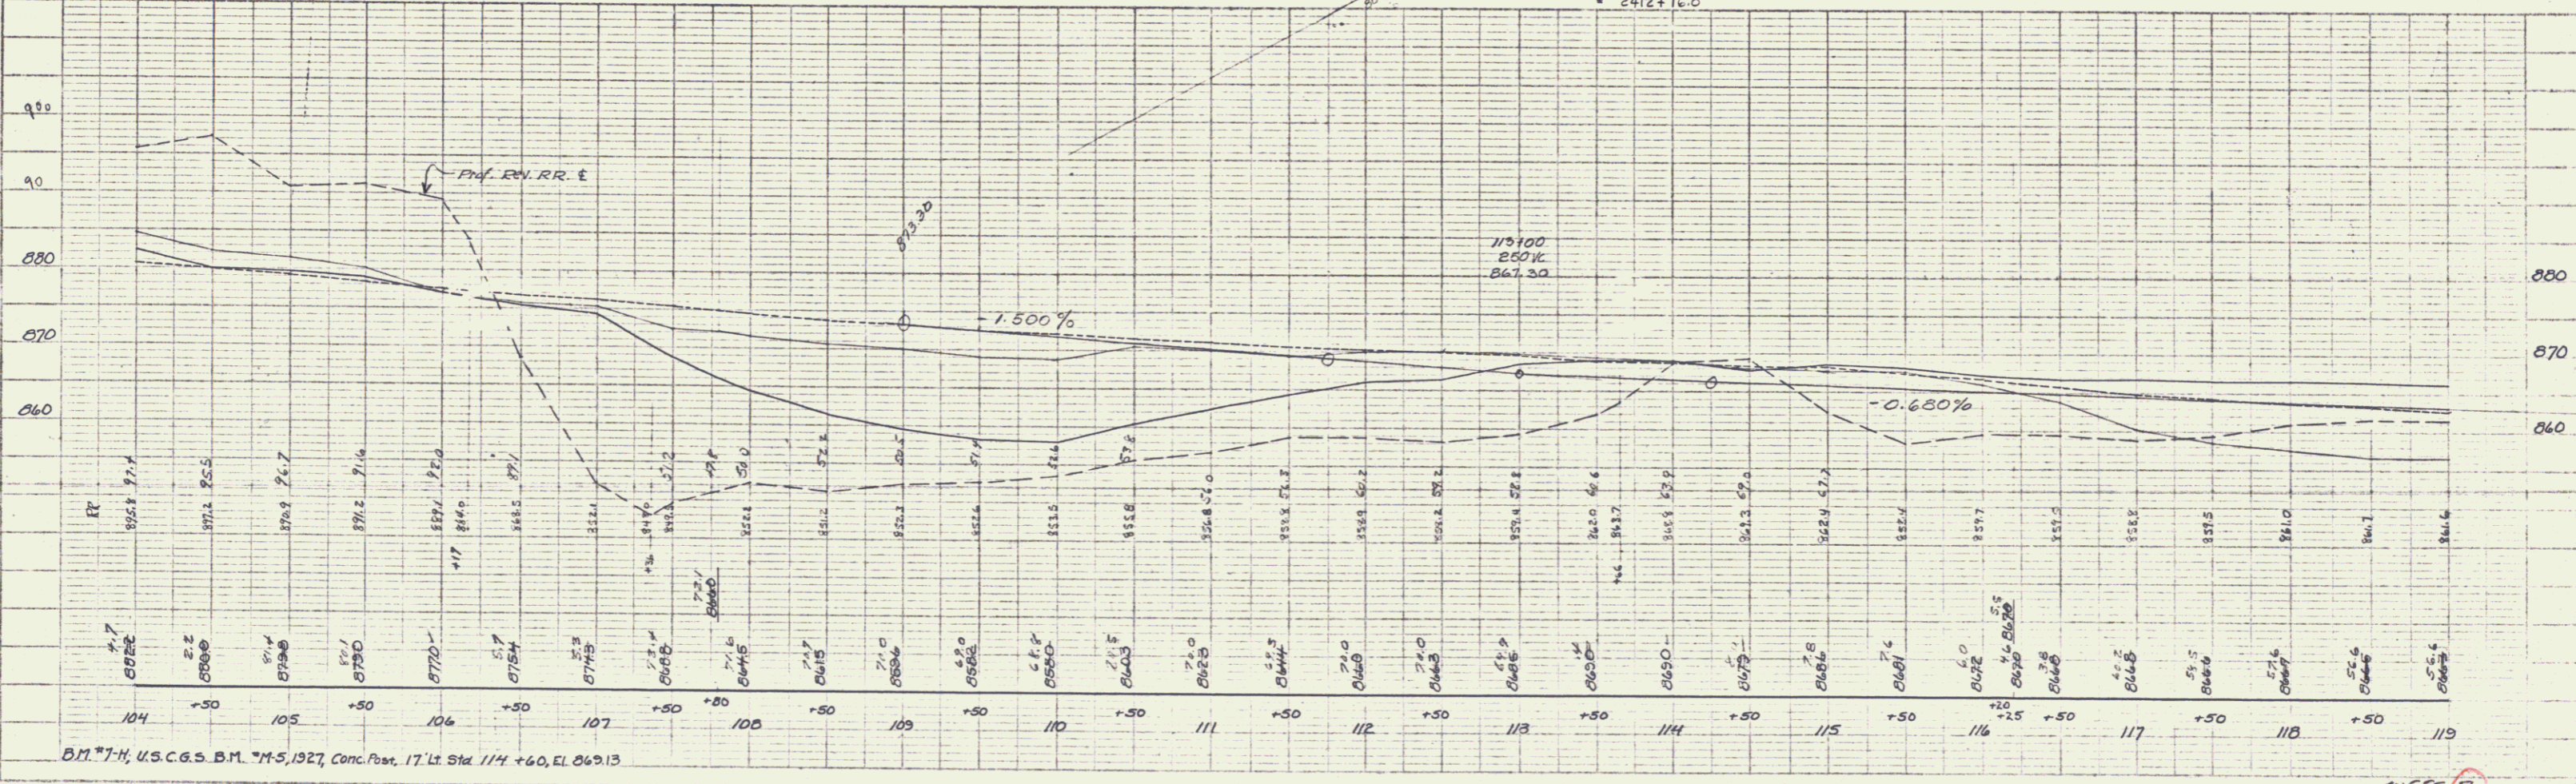


PLAN
 DATE: 3-30-33
 DRAWN BY: J.M. WATKINS
 CHECKED BY: J.M. WATKINS
 NO. 1764-30

PROFILE
 DATE: 3-30-33
 DRAWN BY: J.M. WATKINS
 CHECKED BY: J.M. WATKINS
 NO. 1764-30

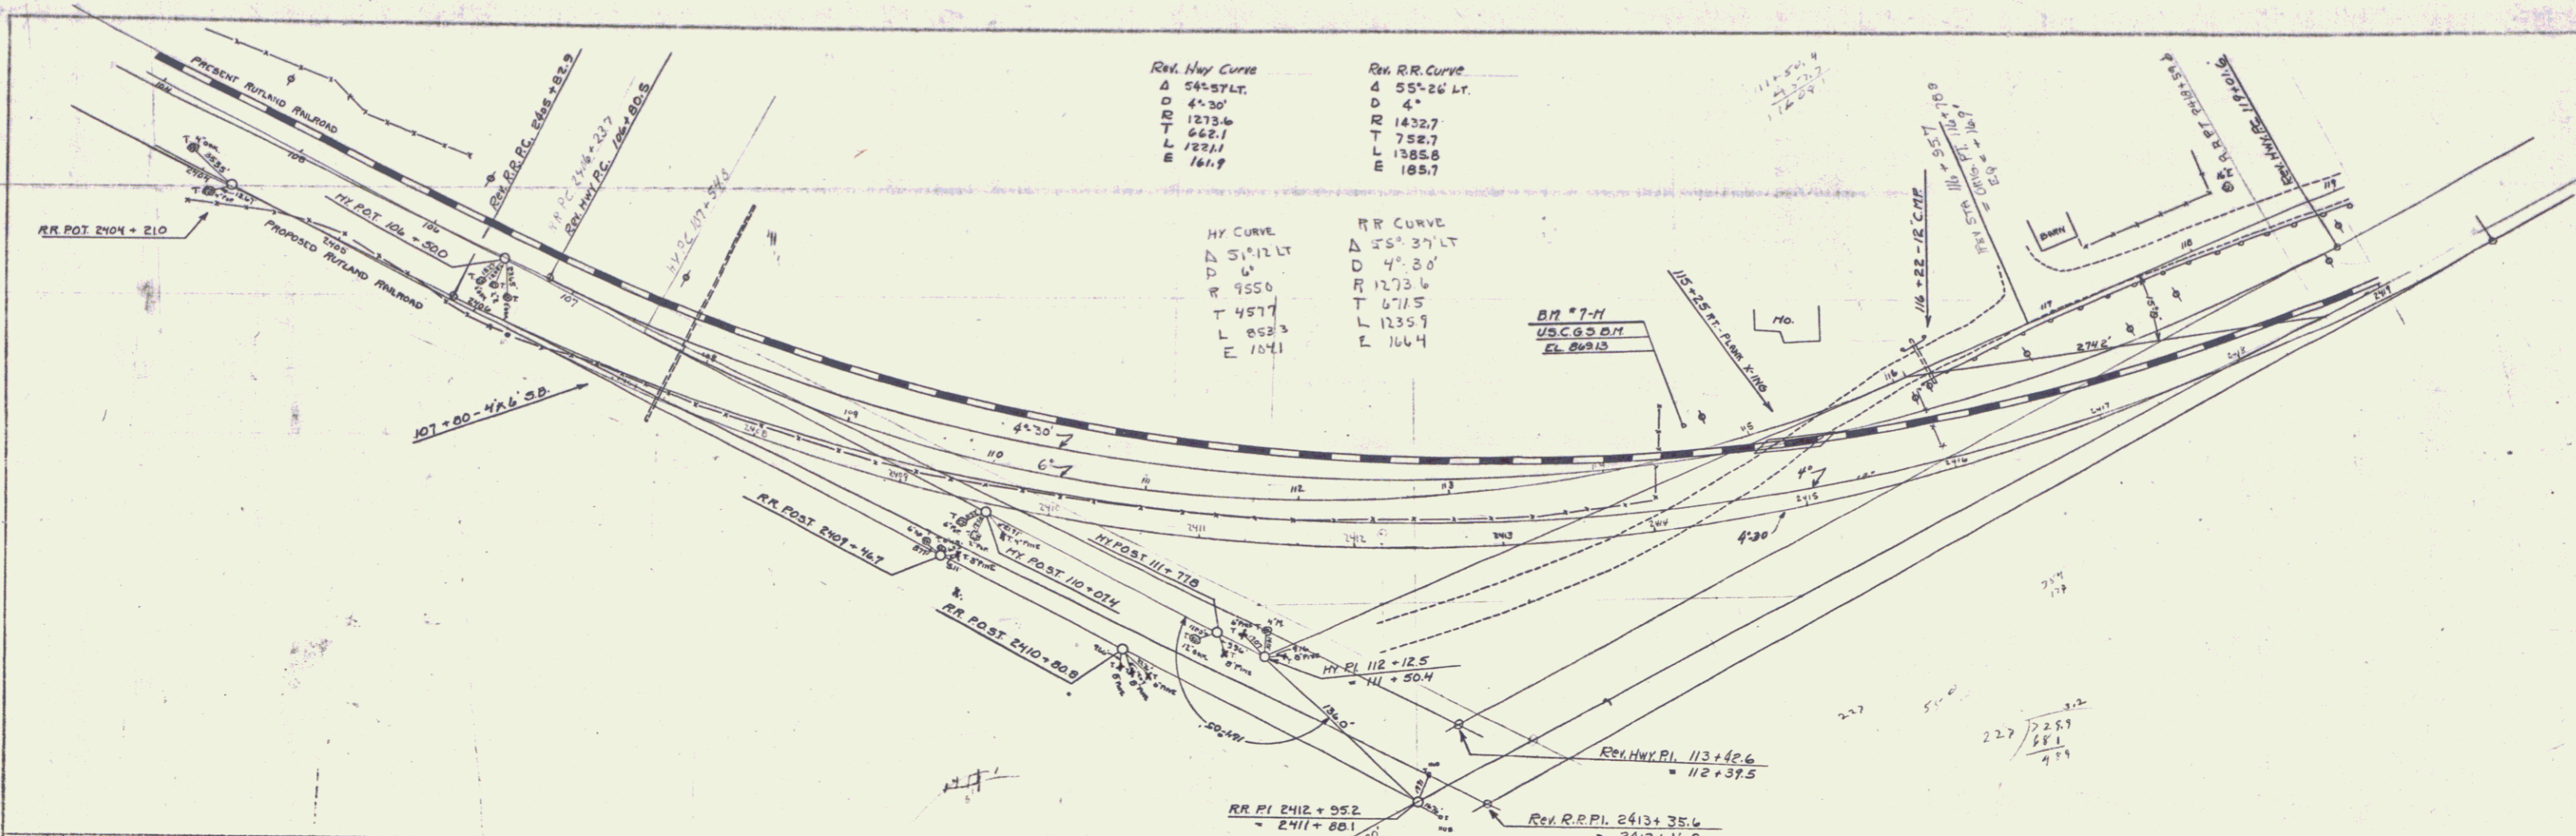

SHEET 7
 1764-30