
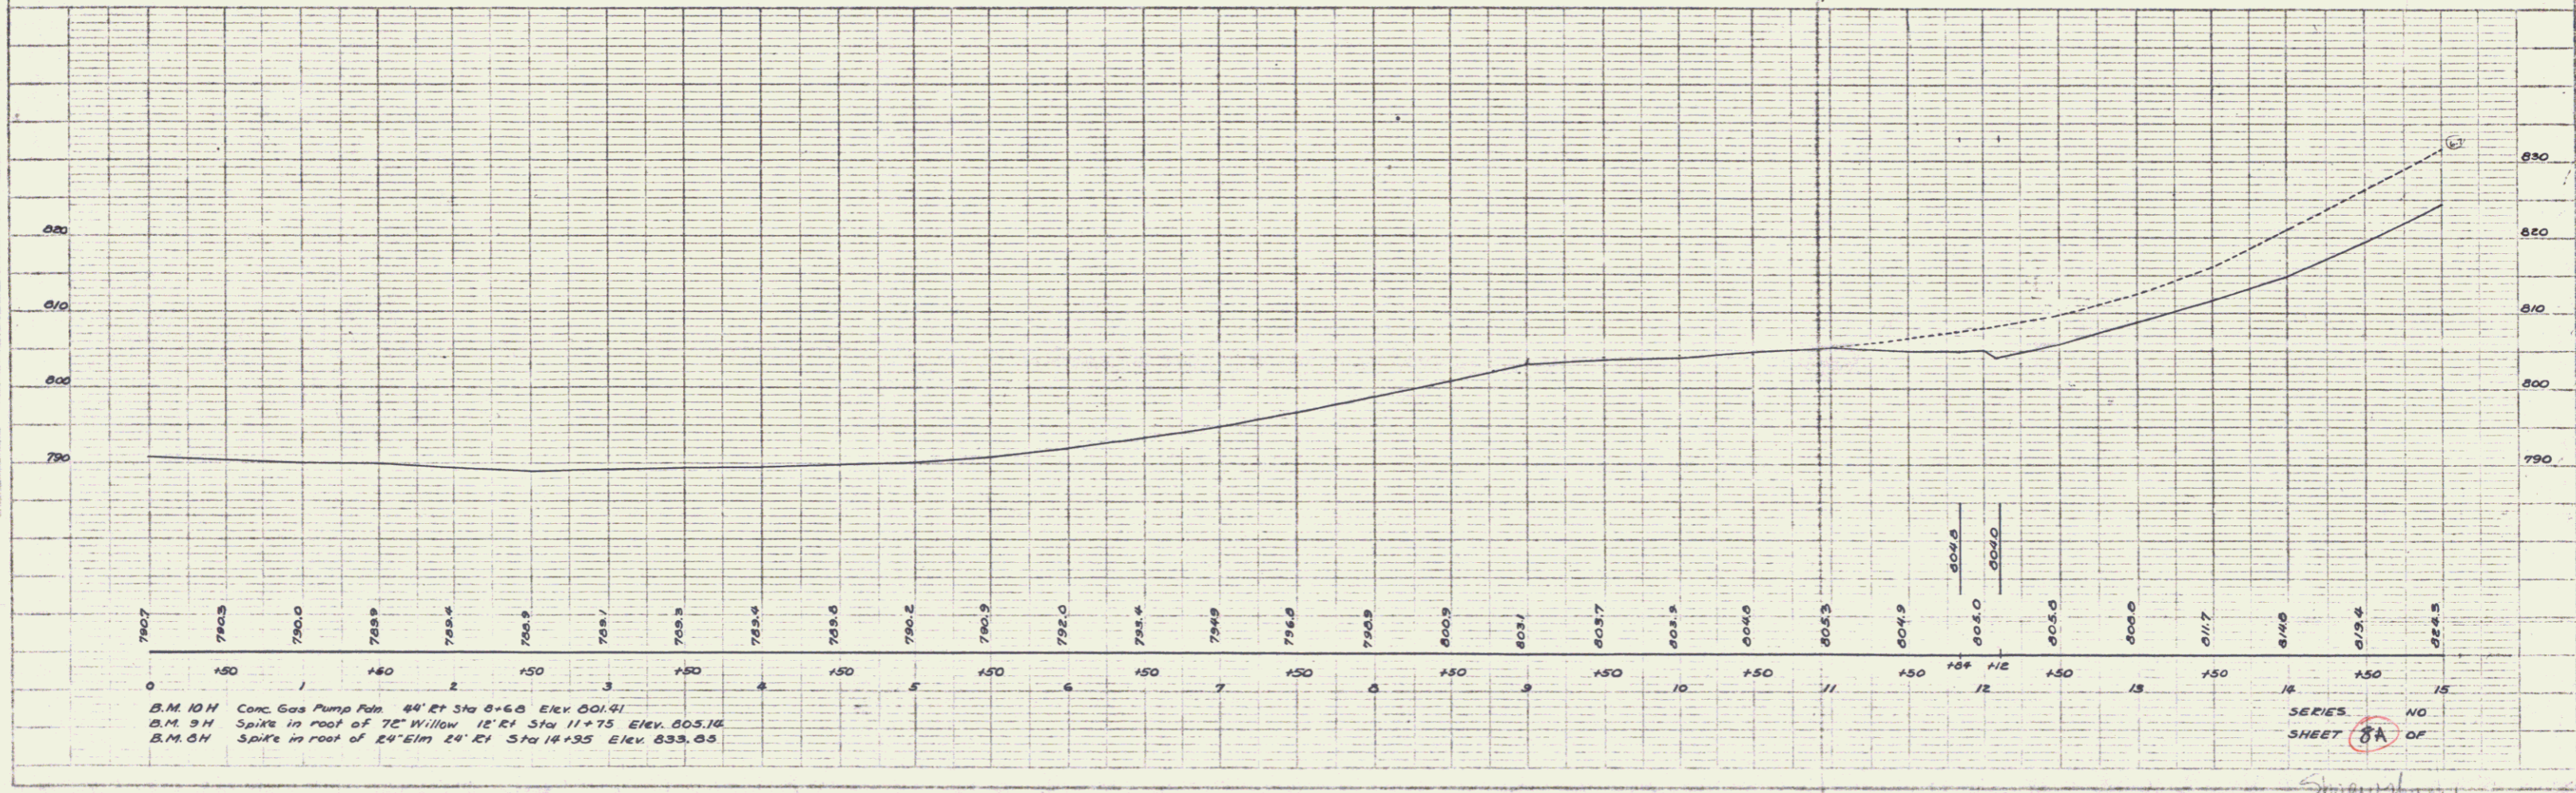


F.D. ROAD DIST. NO.	STATE	F.D. ROAD PROJ. NO.	FISCAL YEAR	SHEET NO.	TOTAL SHEETS
9	VT				

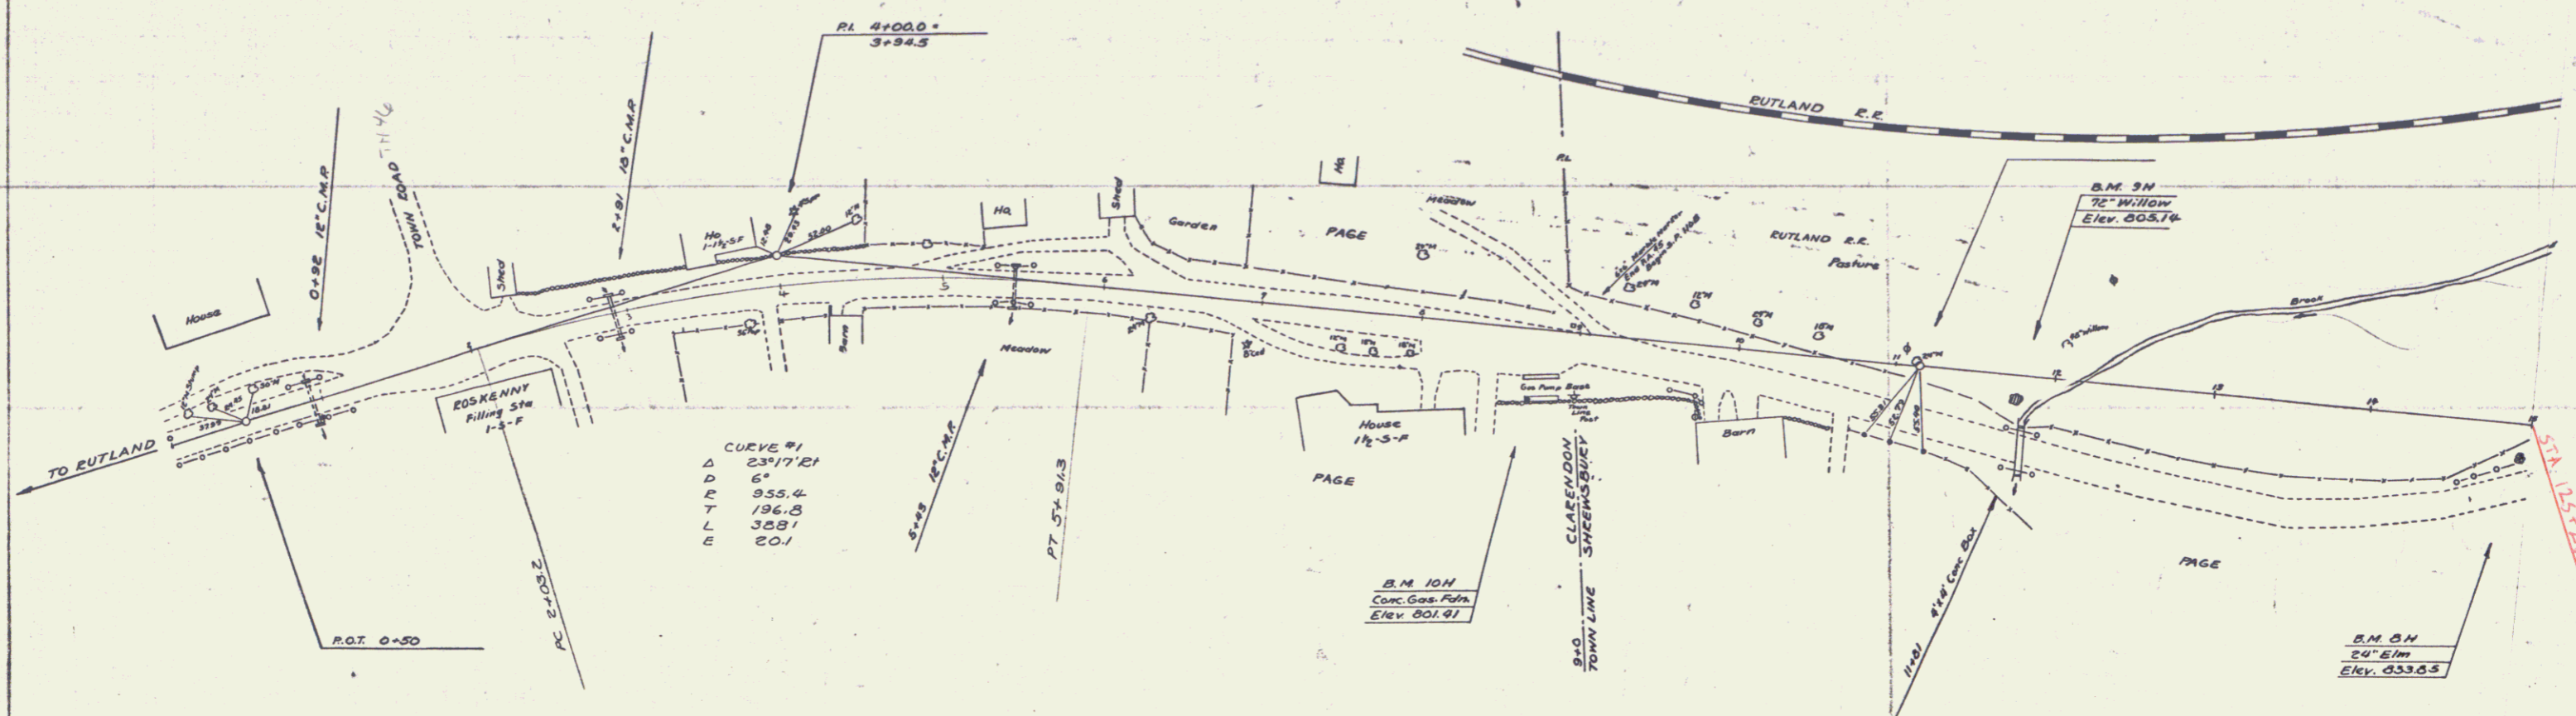

PLAN  
 PROJECT: RUTLAND  
 SHEET NO. 8A  
 DATE: 10/1/53

PROFILE  
 PROJECT: RUTLAND  
 SHEET NO. 8A  
 DATE: 10/1/53

B.M. 10H Conc. Gas Pump Pits 44' Et Sta 8+65 Elev. 801.91  
 B.M. 9H Spike in roof of 70' Willow 12' Et Sta 11+75 Elev. 805.74  
 B.M. 8H Spike in roof of 24' Elm 24' Et Sta 14+35 Elev. 833.65

SERIES NO. 8A OF 11

Smiley 11