


#9-C WALTER & MINNIE B. BLANCHARD
 (A.O.B. 2) STA 4+40-4+64 ± (SIDELINE)
 COND. 8/10/56
 RECORDED-CLARENDON-BK30-PG450/458-8/10/56

Construct Drive
 Sta. 160+30 Lt.
 Sta. 154+00 (Approach Line)
 3+25 Rt.
 160+50 Rt.
 167+50 Rt.
 178+00 Lt.

Three Cable Guard Rail/Steel Posts
 Sta. 154+00
 Sta. 160+50
 Sta. 167+50
 Sta. 178+00

Demolition & Removal of Building - Item 586
 Sta. 158+50 Rt.
 158+50 Lt. - REMOVED BY PROPERTY OWNER

PARCEL	INSTRUMENT	DATE	GRANTOR	GRANTEE	RECORD	BOOK	PAGE	DATE
9A.B.	W.D.	8-10-56	Walter & Minnie B. Blanchard	St. of V. Clarendon	30	450	458	8/10/56
9C.A.B.	W.D.	8-10-56	Walter & Minnie B. Blanchard	St. of V. Clarendon	30	450	458	8/10/56
10.A.B.	W.D.	8-10-56	Walter & Minnie B. Blanchard	St. of V. Clarendon	30	450	458	8/10/56

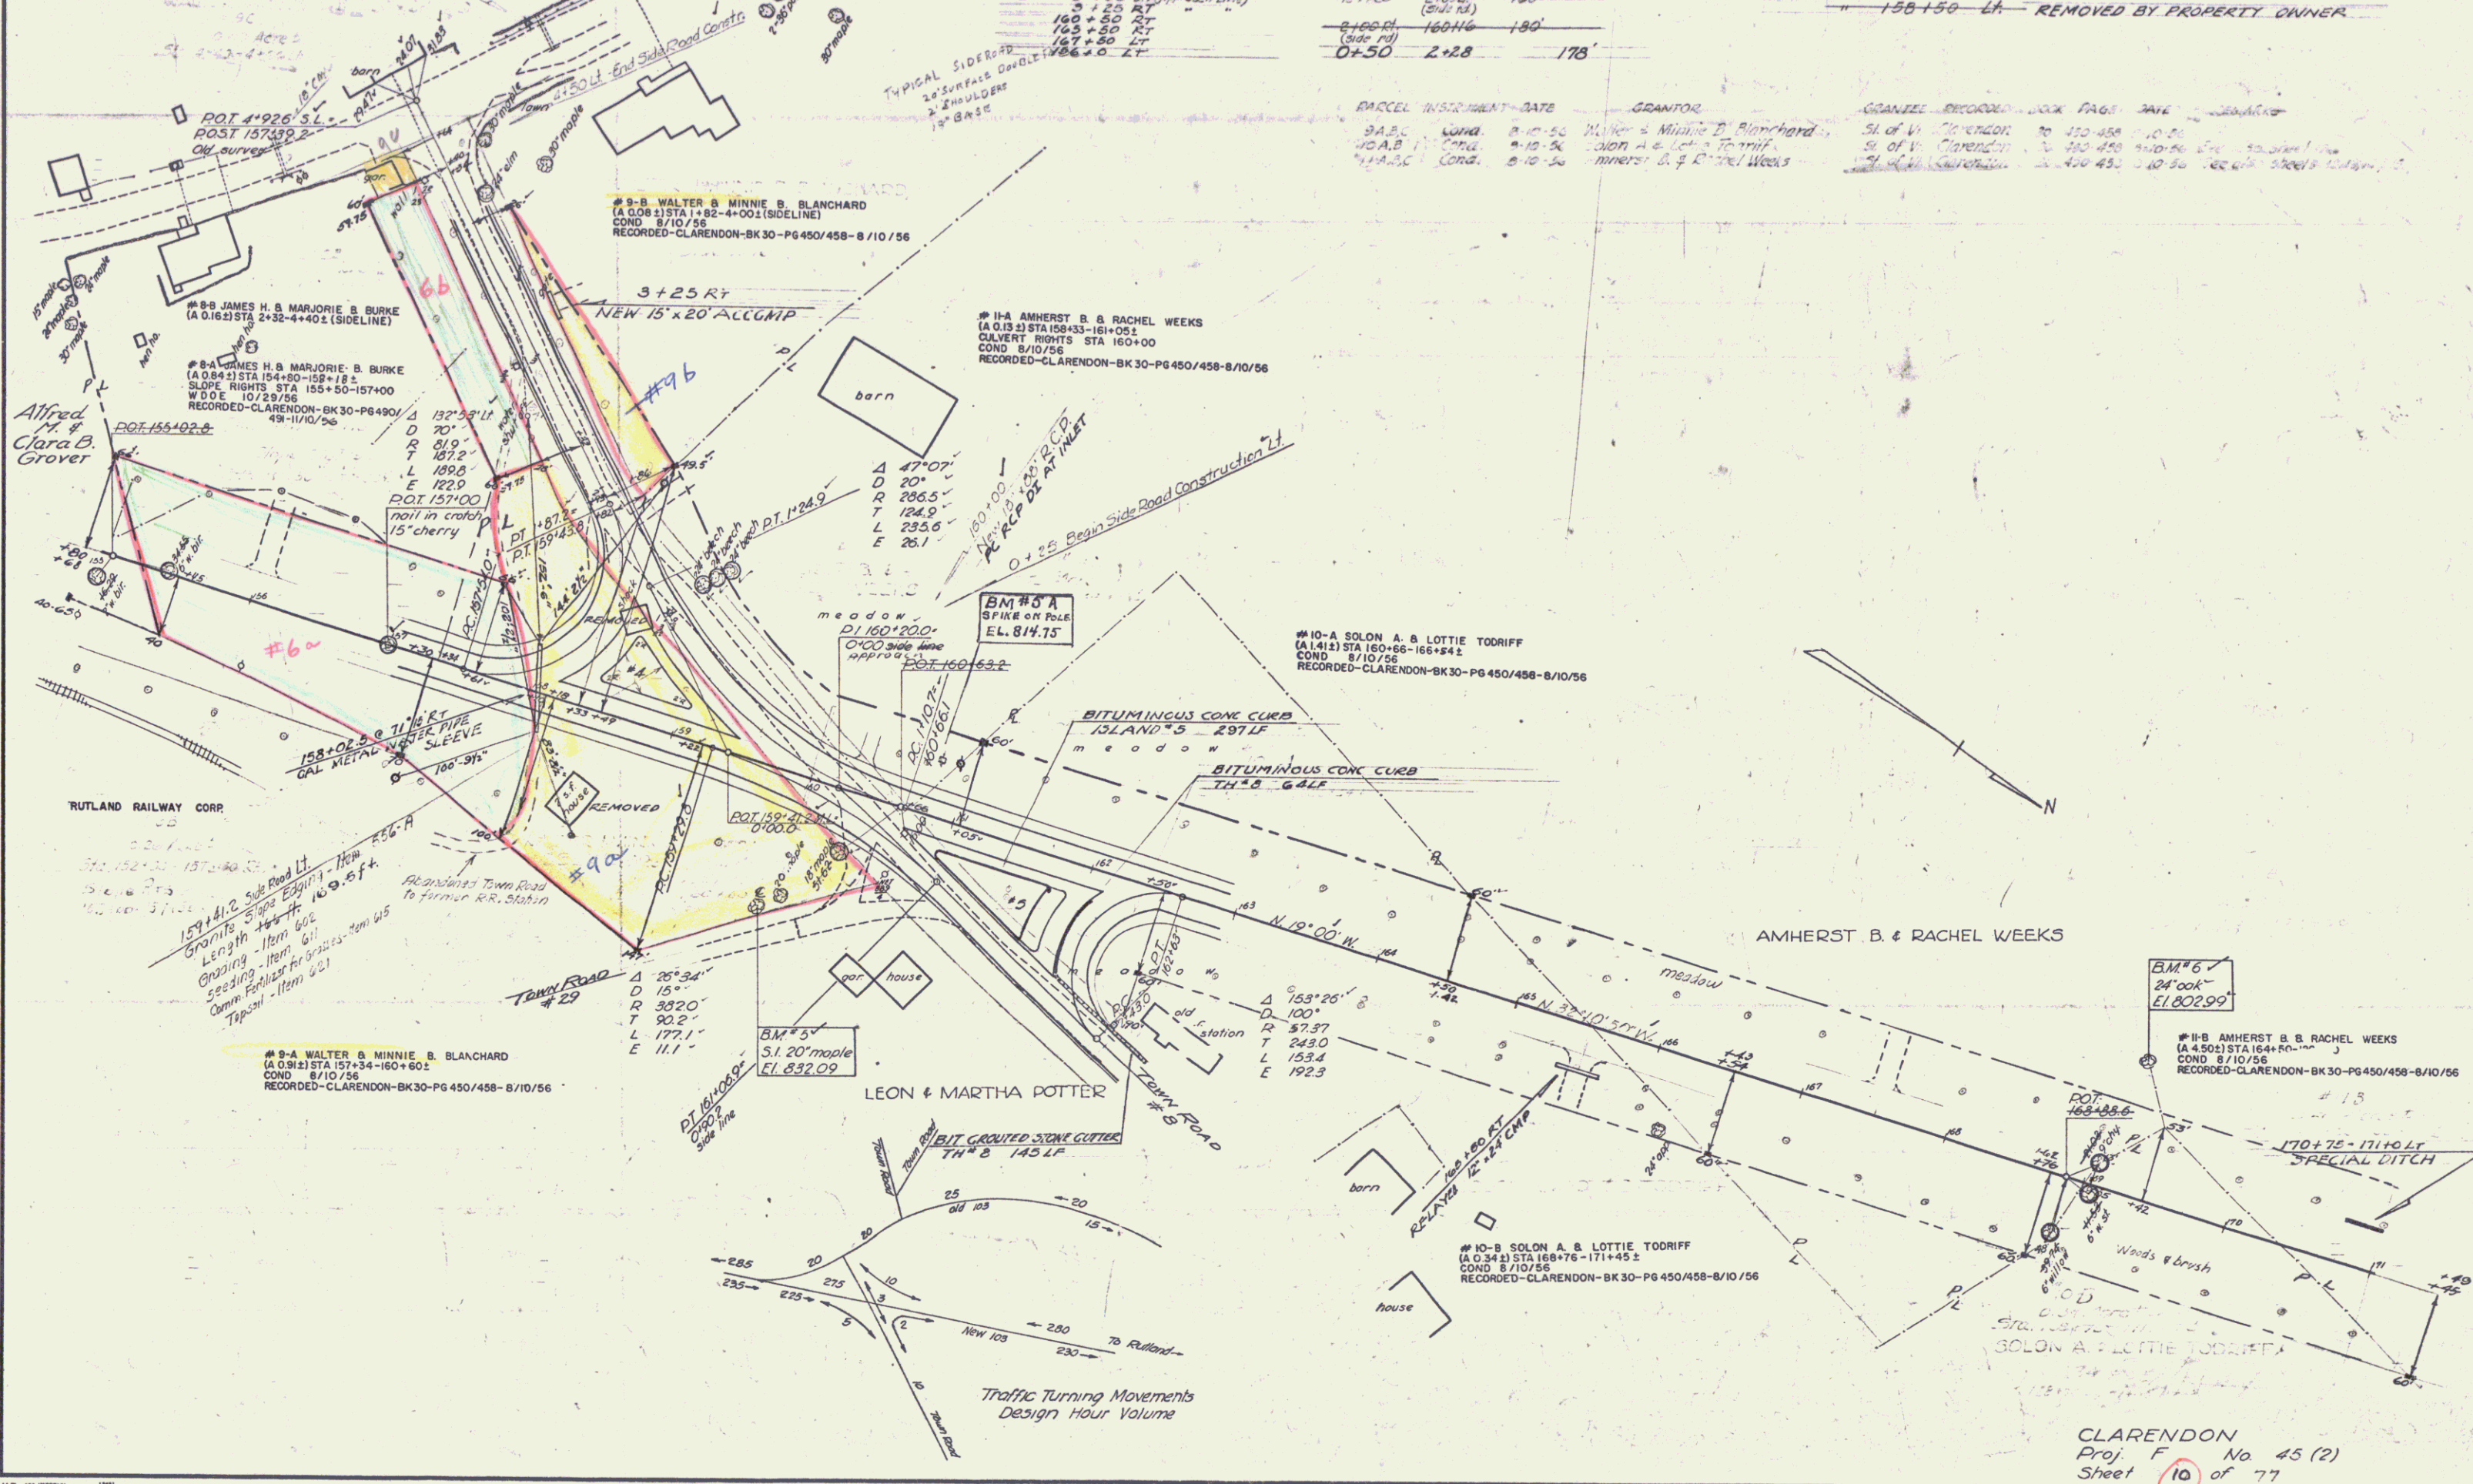

#8-B JAMES H. & MARJORIE B. BURKE
 (A.O.B. 2) STA 2+32-4+40 ± (SIDELINE)
 COND. 8/10/56
 RECORDED-CLARENDON-BK30-PG450/458-8/10/56

#8-B WALTER & MINNIE B. BLANCHARD
 (A.O.B. 2) STA 1+82-4+00 ± (SIDELINE)
 COND. 8/10/56
 RECORDED-CLARENDON-BK30-PG450/458-8/10/56

#1-A AMHERST B. & RACHEL WEEKS
 (A.O.B. 2) STA 158+33-161+00 ±
 CURVERT RIGHTS STA 160+00
 COND. 8/10/56
 RECORDED-CLARENDON-BK30-PG450/458-8/10/56

#8-B JAMES H. & MARJORIE B. BURKE
 (A.O.B. 2) STA 154+50-158+18 ±
 SLOPE RIGHTS STA 155+50-157+00
 W.D. 10/23/56
 RECORDED-CLARENDON-BK30-PG450/458-11/10/56

#10-A SOLON A. & LOTTIE TODRIF
 (A.O.B. 2) STA 160+66-166+24 ±
 COND. 8/10/56
 RECORDED-CLARENDON-BK30-PG450/458-8/10/56

#8-A WALTER & MINNIE B. BLANCHARD
 (A.O.B. 2) STA 157+34-160+00 ±
 COND. 8/10/56
 RECORDED-CLARENDON-BK30-PG450/458-8/10/56

#1-B AMHERST B. & RACHEL WEEKS
 (A.O.B. 2) STA 164+00-166+00 ±
 COND. 8/10/56
 RECORDED-CLARENDON-BK30-PG450/458-8/10/56

#10-B SOLON A. & LOTTIE TODRIF
 (A.O.B. 2) STA 168+76-171+45 ±
 COND. 8/10/56
 RECORDED-CLARENDON-BK30-PG450/458-8/10/56

CLARENDON
 Proj. F No. 45 (2)
 Sheet 10 of 77