


Construct Approach  
Sta. 237+00 Lt  
Construct Drive  
Sta. 249+15 Lt

Removal of Road Surface - Item 118  
Sta. 237+00 to Sta. 237+00  
238+50

Relinquished, from survey station 150+60 left 100' to sta. 235+60 left 200' approximately 1.74 miles, to the Town of Clarendon and recorded in Book 21 on Page 183 of Land Records, of the Town of Clarendon, on the 23rd day of August, 1958.

Three Cable Guard/Steel Posts

Sta.	Sta.	Lt.	Rt.
237+00	237+00	72'	
237+00	237+15	107'	
237+15	240+15	100'	
237+25	237+25	40'	
238+25	241+15	110'	
238+25	240+27	112'	

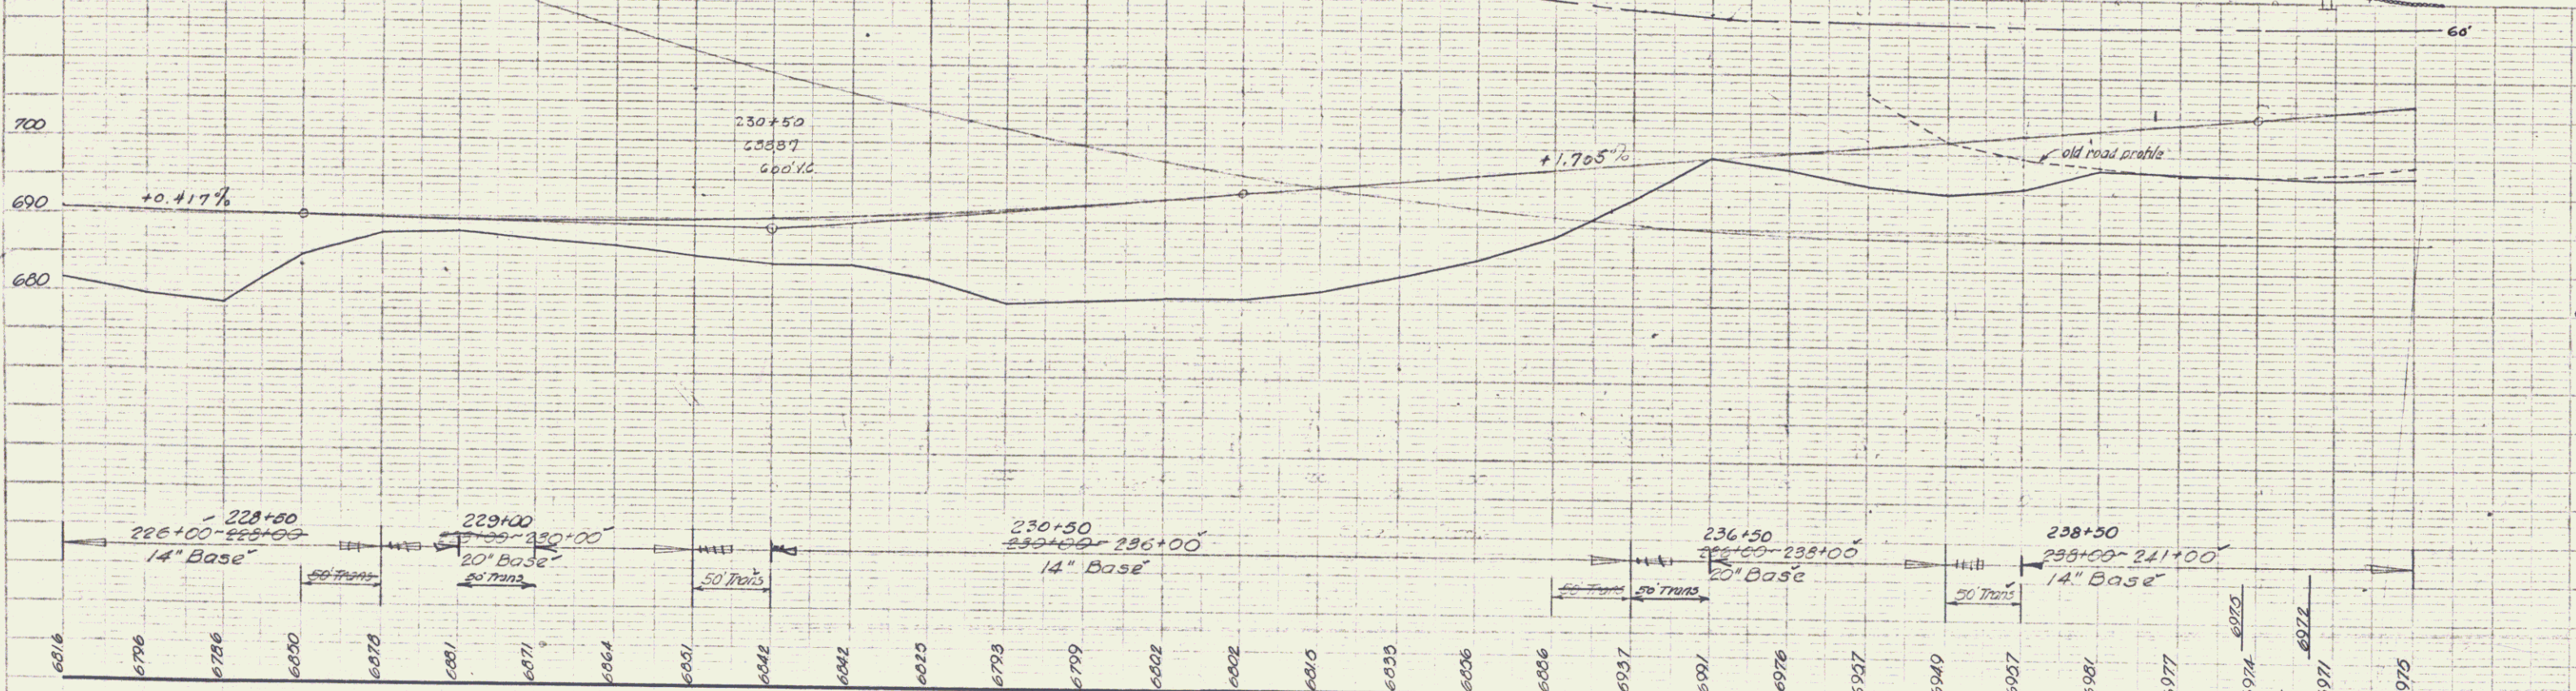

226 +00 B.M. #14 Spot on Boulder, Vicinity of Sta. 231+00 El. 693.20  
B.M. #15 S.R. 20' Maple 74' Rt Sta. 238+20 El. 702.33

CLARENDON  
Proj. F. No. 45(2)  
Sheet 17 of 77