


#1-C WALTER B. MINNIE & BLANCHARD
(A.C. 9215131-140-14641 (SIDE LINE))
COND. 8/10/56
RECORDED-CLARENDON-BK 30-PG 450/458-8/10/56

0+50 2+25 735

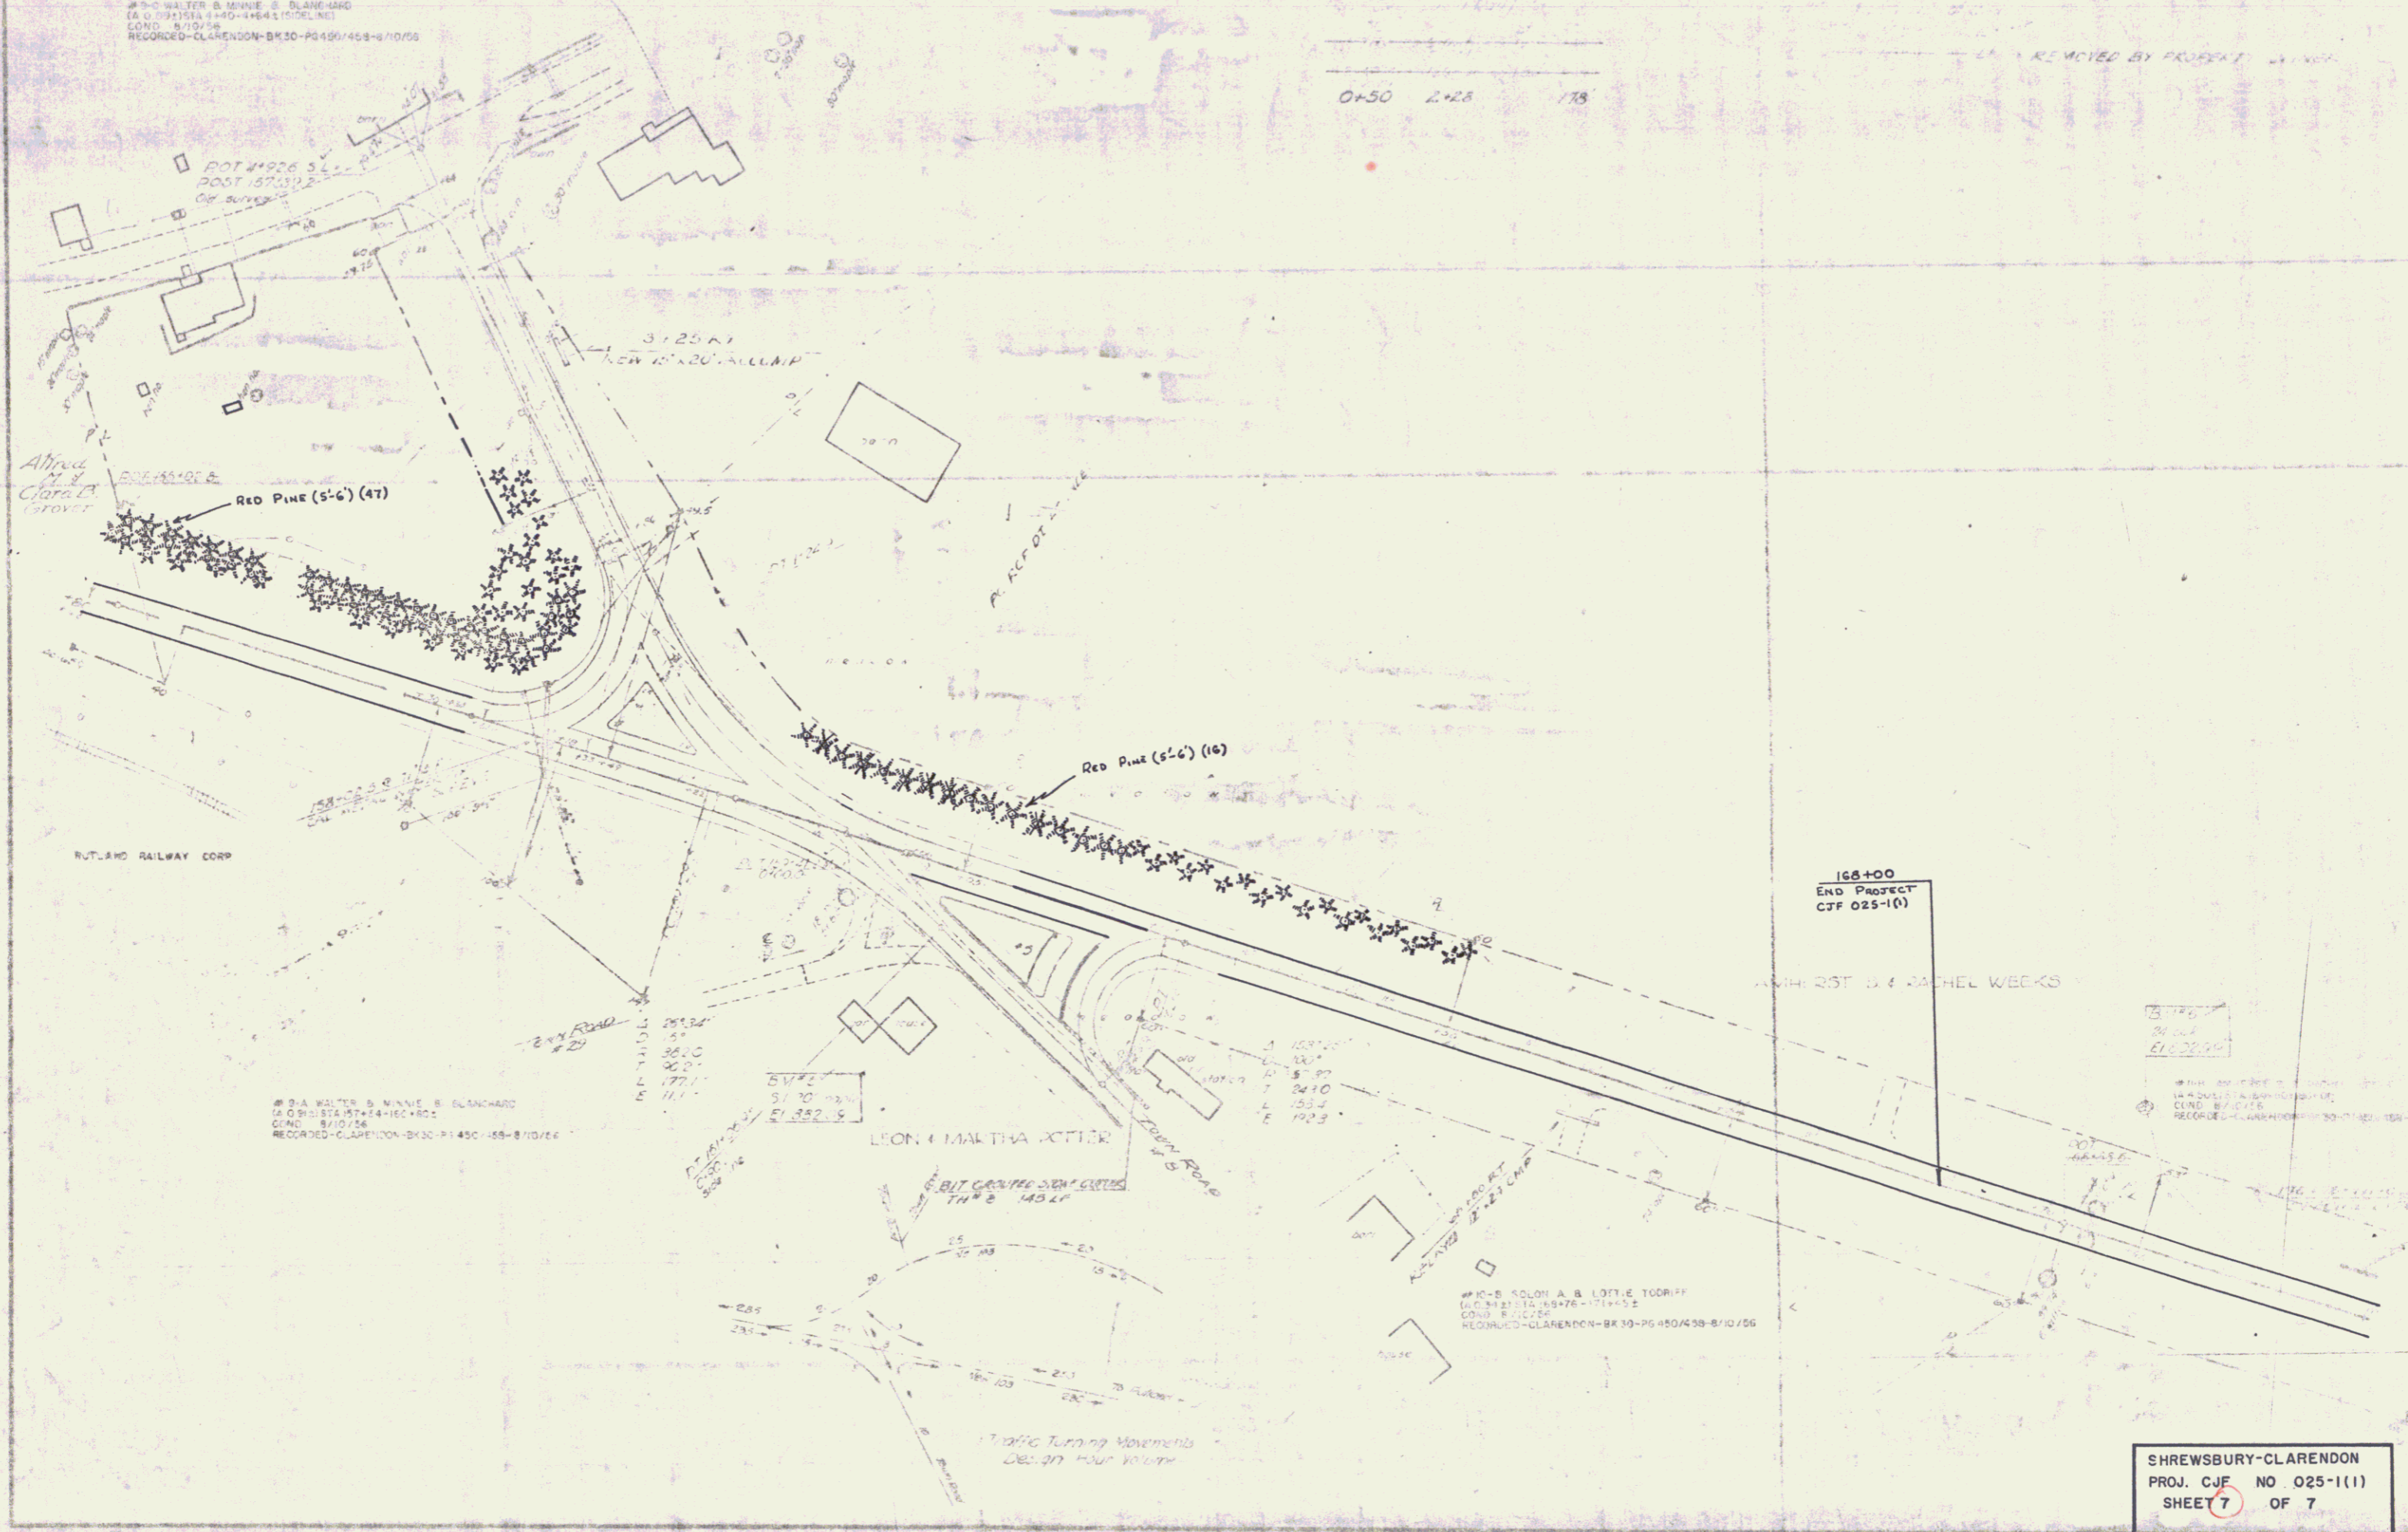

#1-A WALTER B. MINNIE & BLANCHARD
(A.C. 9215131-140-14641 (SIDE LINE))
COND. 8/10/56
RECORDED-CLARENDON-BK 30-PG 450/458-8/10/56

STAKE
3+20
5+22.5

LEON & MARTHA POTTER

BIT CARBIDE SIGN CLUSTERS
TH 2 140 LF

#10-B SOLOH A. & LOYD E. TODRIF
(A.C. 9215131-140-14641 (SIDE LINE))
COND. 8/10/56
RECORDED-CLARENDON-BK 30-PG 450/458-8/10/56

165+00
END PROJECT
CJF 025-1(1)

ASHTON ST. & RACHEL WEEKS

165+00
165+00

#10-B SOLOH A. & LOYD E. TODRIF
(A.C. 9215131-140-14641 (SIDE LINE))
COND. 8/10/56
RECORDED-CLARENDON-BK 30-PG 450/458-8/10/56

SHREWSBURY-CLARENDON
PROJ. CJF NO 025-1(1)
SHEET 7 OF 7