

INDEX OF SHEETS

SHEET NO.	TITLE PAGE	DESCRIPTION
1	TITLE PAGE	
2	TYPICAL CROSS-SECTION OF IMPROVEMENT	2 1/2" CRUSHED GRAVEL MIXED IN PLACE SURFACE COURSE WITH CUTBACK ASPHALT AND PRIME COAT OF REFINED TAR. ITEMS 26, 30, B 31
3	BANKING AND WIDENING TABLES	
4-6	PLAN AND PROFILE	
7	STANDARD SHEETS	SG 2-4 4X4 R.C. BOXES
8		SCW-4 4X4 RC BOXES
9		S-28 PIPE CULVERTS
10		S-30 GUARD RAIL
11		S-30A BOUNDARY MARKERS
12		S-40 BARRICADES, SIGNS AND LIGHTS
13		S-41 ROUNDING OF SLOPES
13A		S48-46 THREE STRAND CABLE GUARD RAIL
13B		S49-46 SPRING MOUNTED PANEL TYPE GUARD RAIL
14-28	CROSS SECTIONS	

STANDARD STRUCTURE SHEETS APPROVED BY THE CHIEF ENGINEER VERMONT DEPARTMENT OF HIGHWAYS

S-28	APRIL 26, 1941
S-30	MAY 12, 1941
S-30A	APRIL 19, 1941
S-40	DEC. 18, 1945

STATE OF VERMONT
STATE HIGHWAY DEPARTMENT

PLAN AND PROFILE OF PROPOSED
STATE HIGHWAY

FEDERAL AID PROJECT

TOWN OF SHREWSBURY



VERMONT ROUTE 103

LUDLOW - RUTLAND ROAD

BEGINNING AT A POINT 1333.3 FEET EASTERLY OF THE SHREWSBURY-CLARENDON TOWN LINE AND EXTENDING WESTERLY 1333.3 FEET TO THE SHREWSBURY-CLARENDON TOWN LINE

LENGTH OF PROJECT 1333.3 FEET = 0.253 MILES

FED. ROAD DIST. NO.	STATE	PROJ. NO.	FISCAL YEAR	SHEET NO.	TOTAL SHEETS
9	Vt.	110(3)	1946	1	28

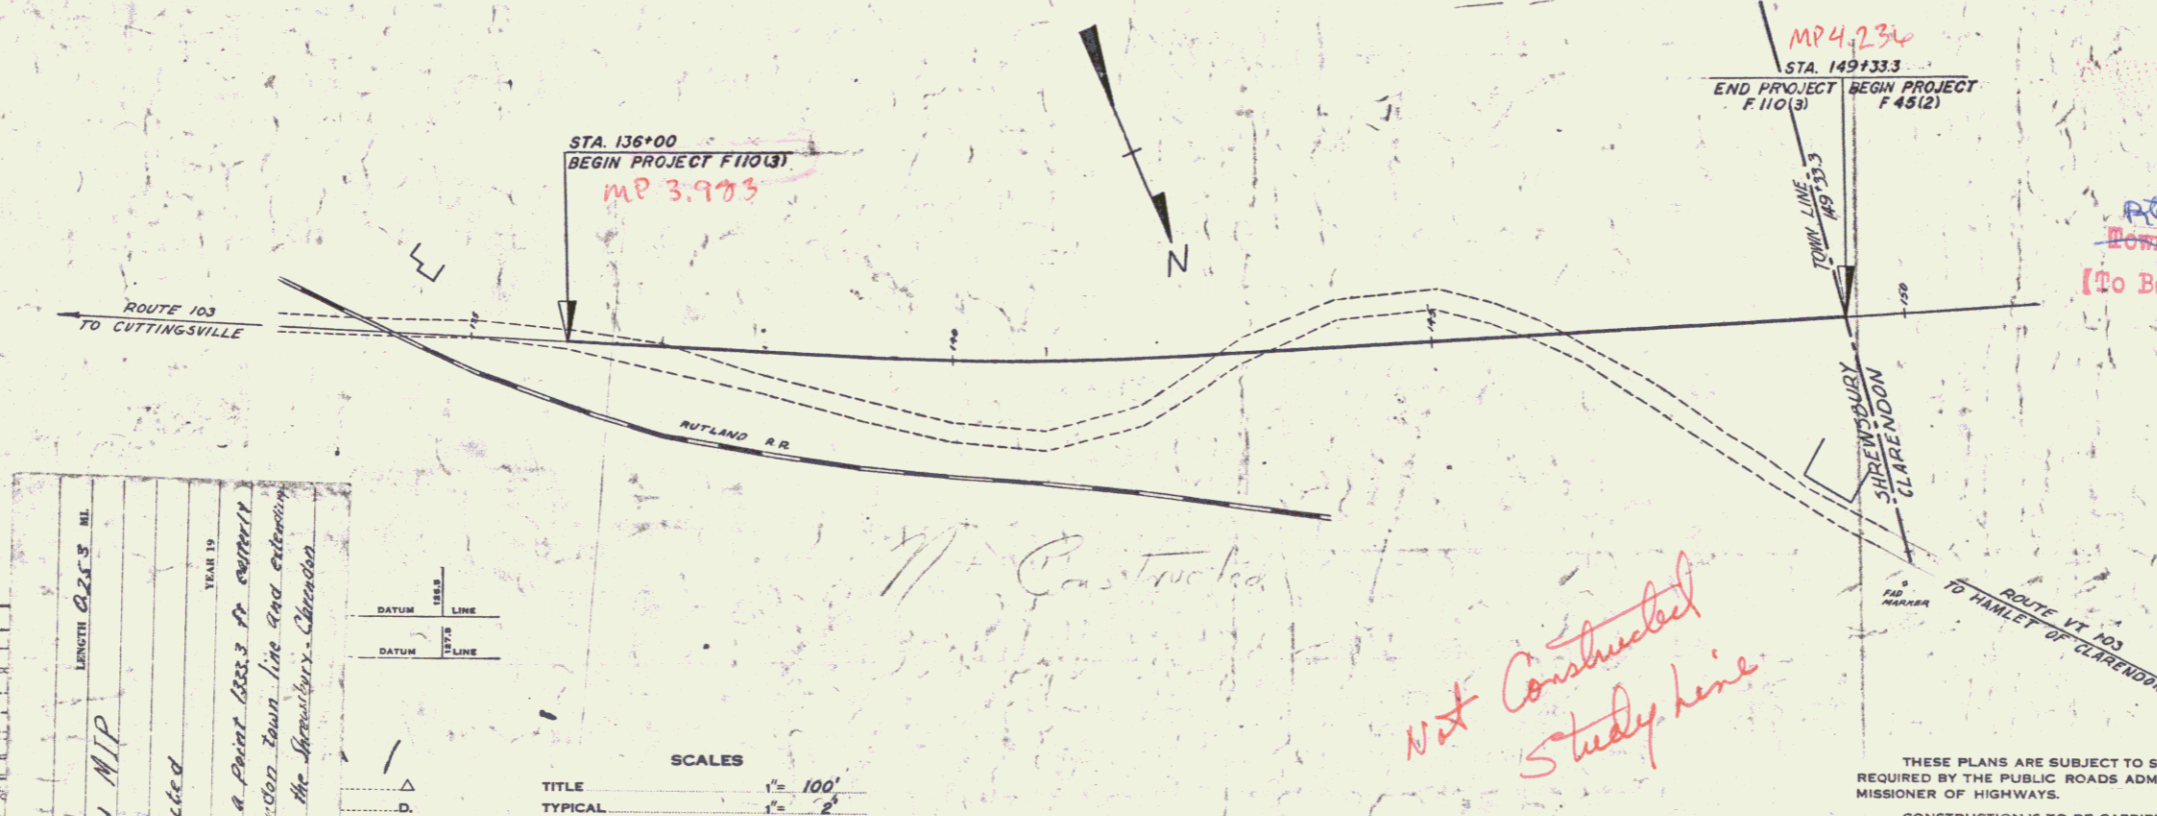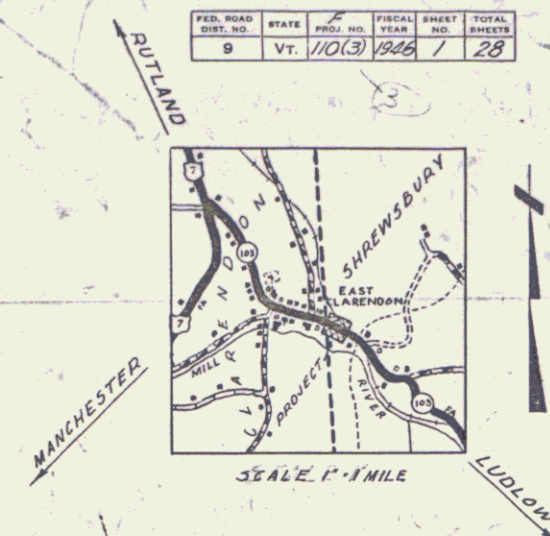

RIGHT-OF-WAY DIVISION
TOWN FILE
PERPETUAL
Town of VT 103
[To Be Returned To R.O.W. Division]

APPROVED: Dec 9 1946
H. August
COMMISSIONER OF HIGHWAYS

SUBMITTED BY ORDER OF THE STATE HIGHWAY BOARD

Date 12/5/1946
Pin # 00R126

RECOMMENDED FOR APPROVAL
DISTRICT ENGINEER
PUBLIC ROADS ADMINISTRATION
FEDERAL WORKS AGENCY

APPROVED
DISTRICT ENGINEER
PUBLIC ROADS ADMINISTRATION
FEDERAL WORKS AGENCY

APPROVED Dec 2, 1946
H. August
DISTRICT HIGHWAY COMMISSIONER

SERIES F No 110(3) FILED
SHEET 1 of 28

COUNTY LINE	---
TOWN LINE	---
FENCE LINE	---
STONE WALL	---
UNFENCED PROPERTY	---
GUARD RAIL	---
TRAVELED WAY	---
RAILROAD	---
RETAINING WALL	---
CENTER LINE	---
SURVEY LINE	---
CULVERT	---
DROP INLET	---
TROLLEY POLE	---
POWER POLE	---
TELEPHONE POLE	---
TREES	---
HEDGE	---

PROJECT: Shrewsbury
NUMBER: F 110 (3) (V)
TITLE: Proposed Grant M.P.
CONTRACTOR: Not Constructed
LOCATION: Beginning at a point 1333.3 ft. easterly of Shrewsbury-Clarendon town line and extending westerly 1333.3 ft. to the Shrewsbury-Clarendon town line.

DATE	BY	LINE
		DATE
		BY
		LINE

SCALES

TITLE	1" = 100'
TYPICAL	1" = 2'
PLAN	1" = 80'
PROFILE HORIZONTAL	1" = 80'
PROFILE VERTICAL	1" = 10'
CROSS SECTIONS	1" = 5'

Not Constructed Study line