
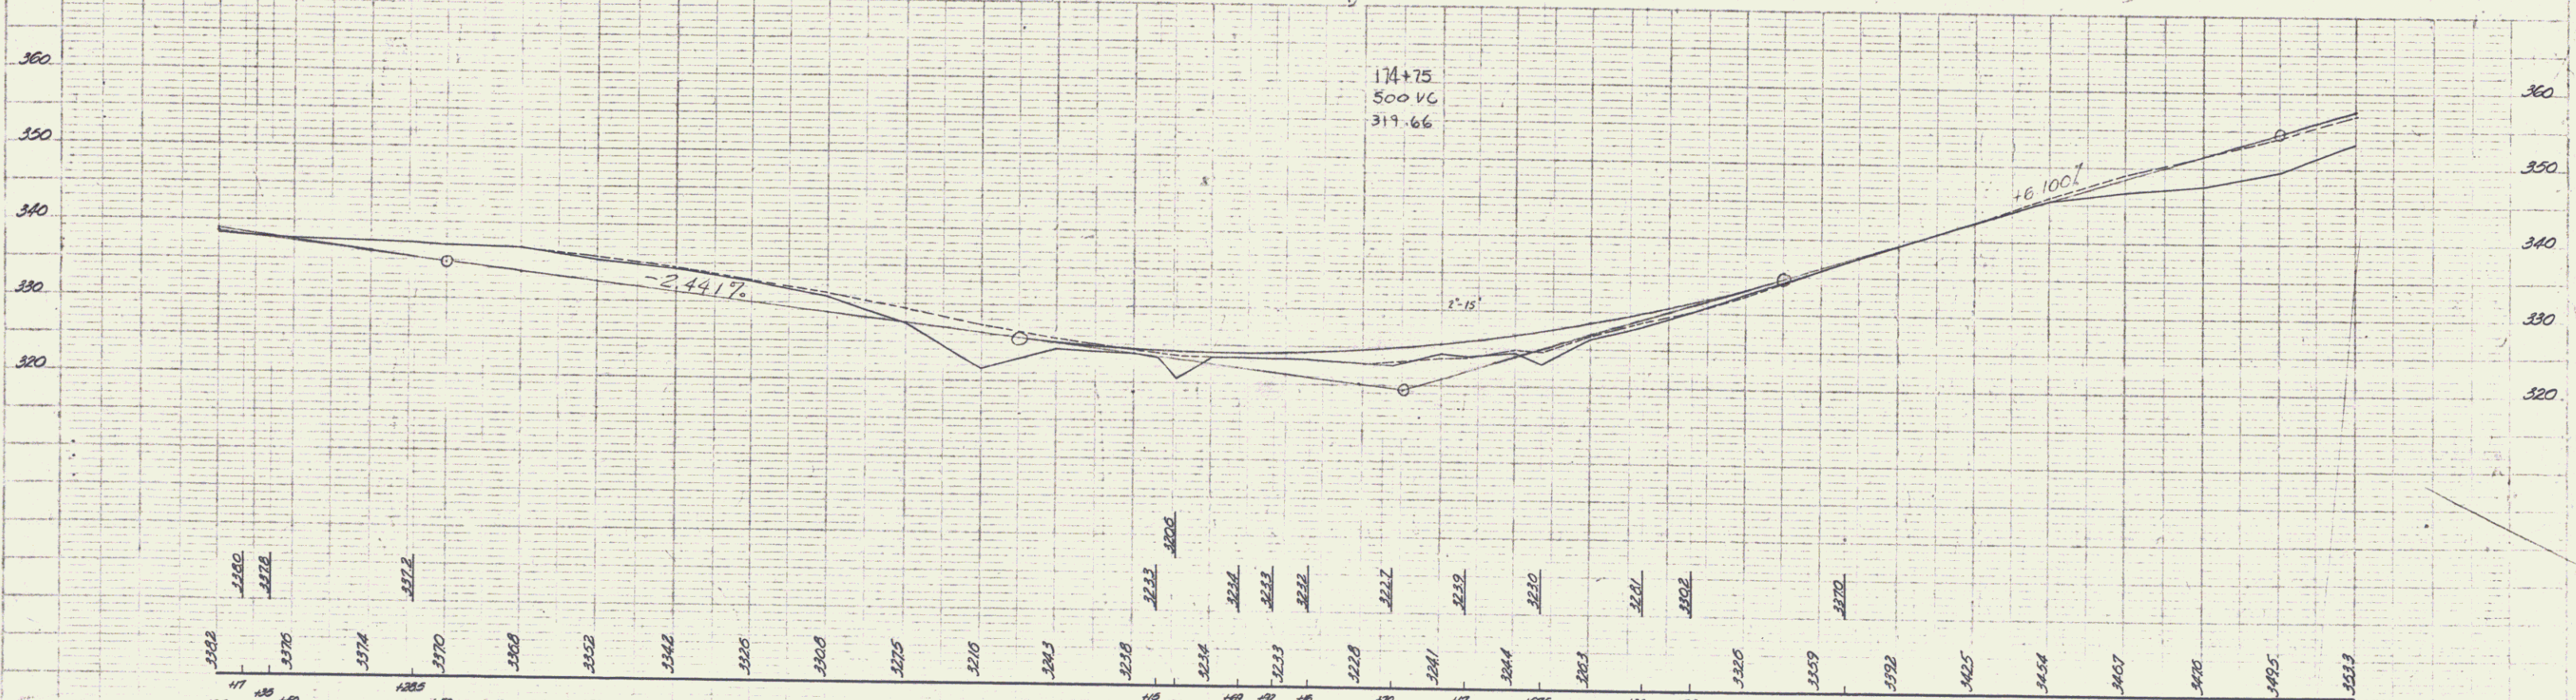


PLAN	DATE	BY	LOC.
DATE	BY	LOC.	
DATE	BY	LOC.	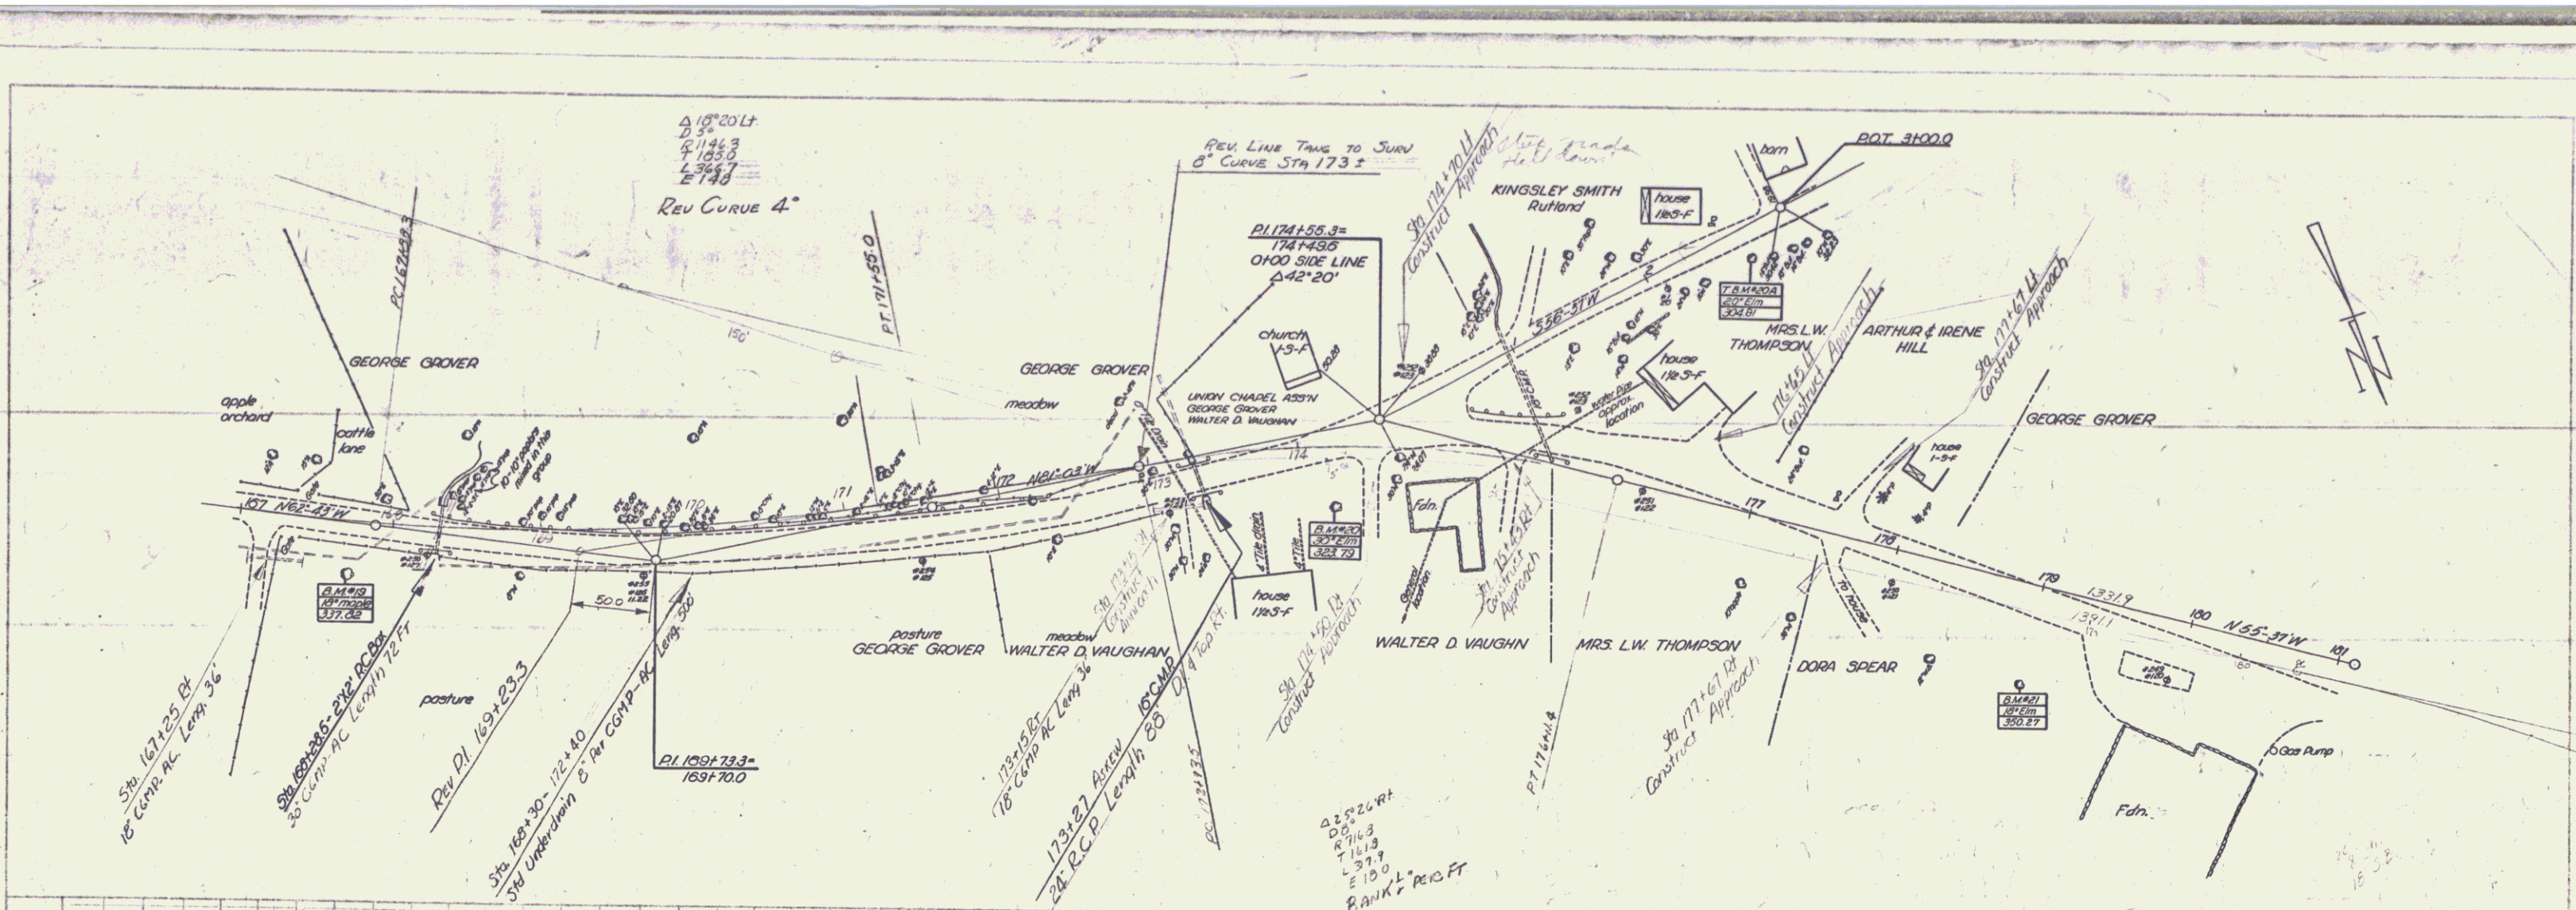
BM 199 S1R 15' lim 305' RI of sta 167+74 Elev 337.02  
 BM 200 S1R 30' lim 335' RI of sta 174+22 Elev 323.79  
 BM 204 S1R 20' lim 161' LI of sta 176+62 Elev 304.91  
 BM 21 S1R 18' lim 625' RI of sta 178+90 Elev 360.27