
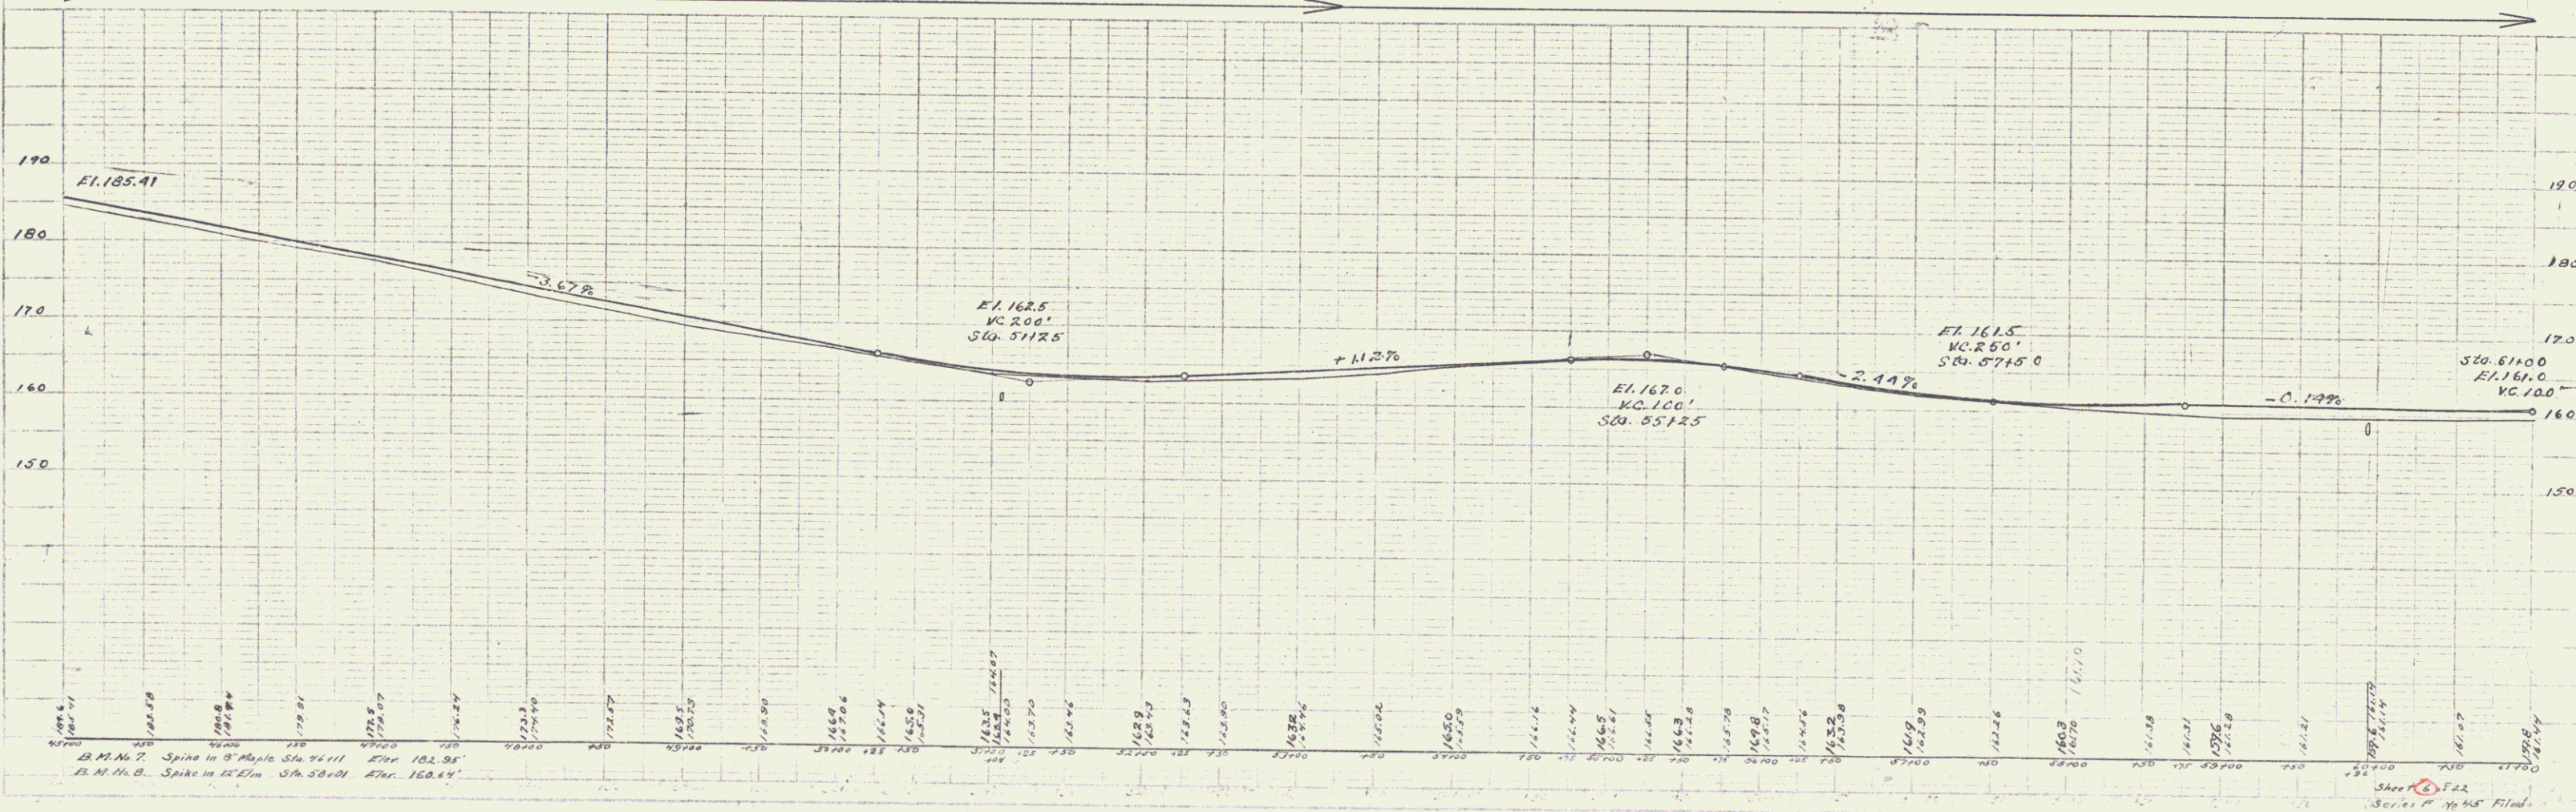


**GUARD RAIL REQUIRED**  
**ON LEFT**  
 Sta 45+00 to Sta 45+12 Length 12 FT  
 - 50+32 - 51+16 - 24 -  
 - 53+84 - 60+08 - 24 -  
**ON RIGHT**  
 Sta 45+00 to Sta 45+12 Length 12 FT  
 - 50+32 - 51+16 - 24 -  
 - 53+84 - 60+08 - 24 -  
**TOTAL THIS SHEET 120 FT**

**NEW CULVERTS REQUIRED**  
 Sta 51+04 2'x2' Concrete Box  
 1-2-4 Concrete 32 cu yd  
 1-2-5 Concrete 71 cu yd  
 Sta 53+06 18" Cur. Iron Pipe Length 28 FT  
 1-2-5 Concrete 1.5 cu yd

**SUB-BASE REQUIRED**  
 Sta 50+50 to Sta 53+00 Length 250 FT  
 Sta 54+00 - 60+00 Length 400 FT

FED. AID DIST. NO.	STATE	FED. AID PROJ. NO.	FISCAL YEAR	SHEET NO.	TOTAL SHEETS
8	VT	95	22	8	22

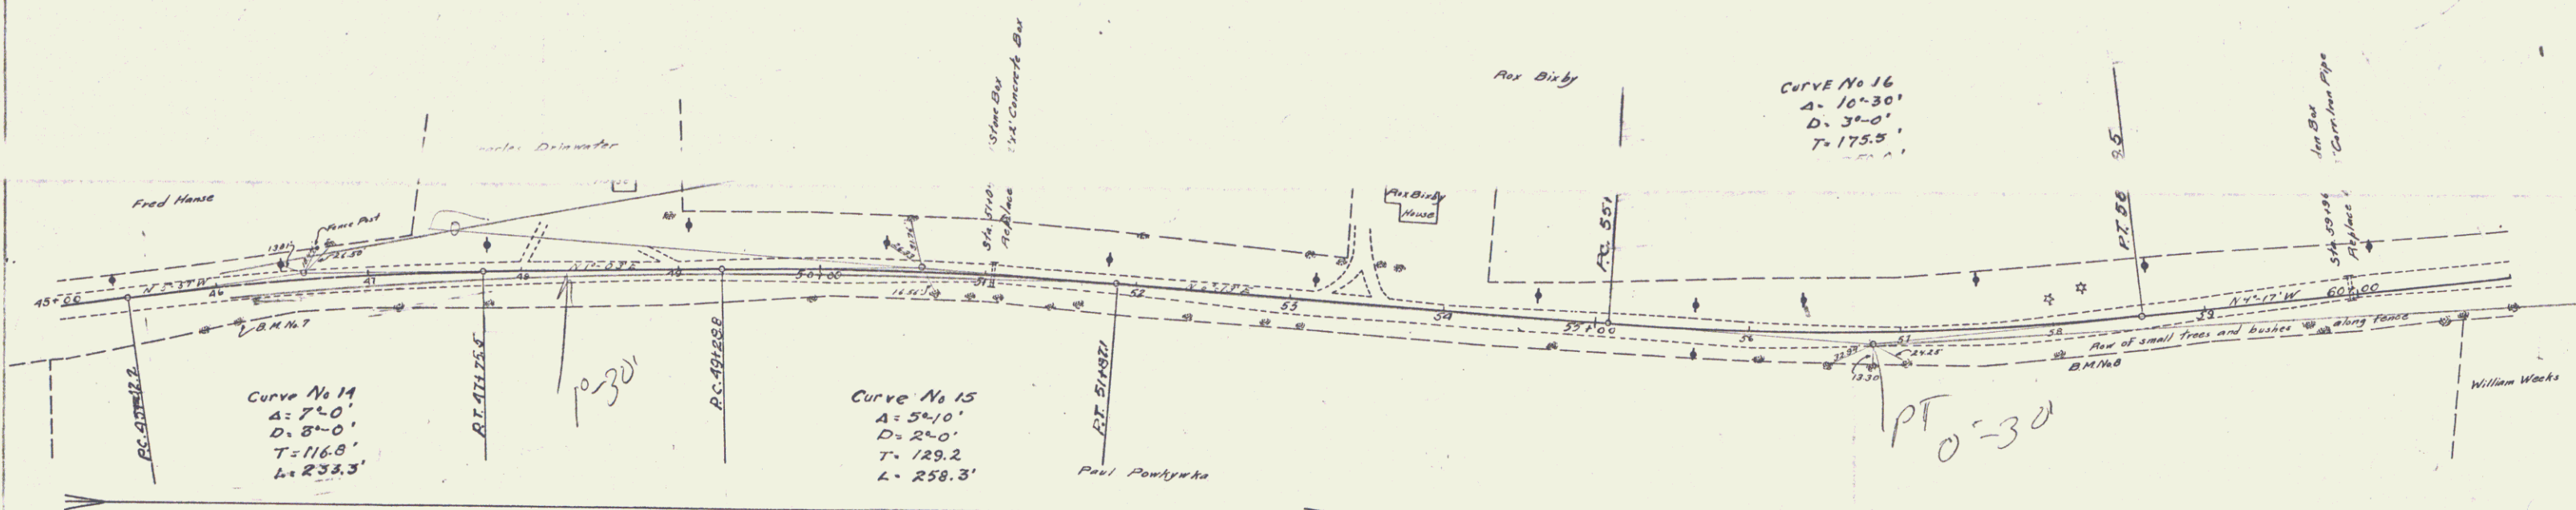

DATE: 10/1/54  
 DRAWN BY: J. W. WILSON  
 CHECKED BY: J. W. WILSON

DATE: 10/1/54  
 DRAWN BY: J. W. WILSON  
 CHECKED BY: J. W. WILSON

DATE: 10/1/54  
 DRAWN BY: J. W. WILSON  
 CHECKED BY: J. W. WILSON

Scale 1" = 40' Vert.  
 Scale 1" = 40' Horiz.