

- INDEX OF SHEETS
- SHEET NO. 1. Title Page  
 2. Typical Sheet of Improvement (17' Bit. Conc. Pav't.) Item 261-9  
 3. Summary - Item & Detail Drainage Sheets  
 4. Grapes & Earthworks  
 5. P.O.M. Detail Sheet  
 6. Plan Sheet  
 7. Profile Sheets  
 8-9. Traffic Sign and Delineator-Location  
 10. Traffic Sign and Delineator-Summary  
 11. Traffic Sign and Delineator-Details  
 12. Overview Plywood Sign-Assembly and Construction Details  
 13. Blank  
 14. A-11 Drilling and Blasting  
 15. B-1 Grading  
 16. B-2 Rebuilding of Slopes  
 17. B-3 Embankment on a Slope  
 18. B-4 Slope Stabilization  
 19. B-5  
 20. B-6  
 21. B-7  
 22. B-8  
 23. B-9  
 24. B-10  
 25. C-1  
 26. C-2  
 27. C-3  
 895. C-871  
 89

- SHEET NO. 1. Title Page  
 2. Typical Sheet of Improvement (3" Bit.Conc.Pav't.) Item 361-B  
 3. Summary - Quantities  
 4. Summary - Item & Detail Drainage Sheets  
 5. Grades & Earthworks  
 6. P.O.M. Detail Sheet  
 7. Plan Sheet  
 8-9. Profile Sheets  
 10. Traffic Sign and Delineator-Location  
 11. Traffic Sign and Delineator-Summary  
 12. Guide Signs-Design and Details  
 13. Overlaid Plywood Sign-Assembly and Construction Details  
 14-15. Blank  
 16. B-1 Drilling and Blasting  
 17. B-1 Banking  
 18. B-5 Bounding of Slopes  
 19. B-10 Embankment on a Slope  
 20. F-1 Slope Stabilization  
 21. Blank  
 22. B-15 Ramp Terminals  
 23. B-16 Divisional Islands  
 24. C-1 Granite Slope Edging  
 25. C-14 Precast Concrete Curb  
 26. D-1 Precast Pipe Drop Inlets  
 27. D-2 Cement Rubble Masonry  
 28. D-3 Jute Matting  
 29. D-4 Flushing Basins  
 30. D-5 Drop Inlets  
 31. E-1 Barricades, Signs and Lights  
 32. E-12 U.S. Route Markers  
 33. E-13 State Route Markers and Auxiliary Markers  
 34. E-14 Regulatory Signs  
 35. E-15 Regulatory Signs  
 36. E-16 Warning Signs  
 37. E-18 Guide Signs  
 38. E-19 Standard Sign Placement  
 39. E-20 Delineators  
 40. E-21 Ground Mounted Sign Supports  
 41. E-31 Federal Aid Construction Identification Signs  
 42. F-1 Property Line Fence  
 43. G-1 Steel Beam Guard Rail  
 44. G-4 Marker Posts, Plank Guard Rail  
 45. J-1 Project, Boundary Markers  
 46-50. Cross Sections Vt. 103  
 51-53. Cross Sections US 7 Approach  
 54. Channel Sections # 14+43 US 7

STATE OF VERMONT  
 DEPARTMENT OF PUBLIC WORKS  
 TOWN OF CLARENDON  
 COUNTY OF RUTLAND  
**VT. 103 RUTLAND-LUDLOW ROAD**

BEGINNING AT A POINT IN THE EDGE OF U.S. 7, 2.316 MILES SOUTH OF THE CLARENDON-RUTLAND TOWN LINE AND EXTENDING SOUTHEASTERLY 0.284 MILES.

LENGTH OF ROADWAY 1,500.3 FEET = 0.284 MILE  
 LENGTH OF PROJECT 1,500.3 FEET = 0.284 MILE


ADT 1966	3150
ADT 1986	5060
DHV 1986	680
D	60%
T	6%
S	60 MPH

PROJECT NAME & NUMBER CLARENDON F-025-1(9) TYPE PAVEMENT BIT. CONC. AREA 19,600 S.Y.

**RECORD PLANS - MATERIALS -**

SUBBASE OF SAND & OF CRUSHED GRAVEL - CHESTER CARBANA PIT, CLARENDON, VT.  
 CRUSHED GRAVEL OR READY MIX PLANT MIX BASE COURSE, & BIT. CONCRETE - VT. PAVING, INC., WALLINGFORD, VT.  
 ASPHALT - HUNDELL OIL & REFINING CO., EVERETT, MASS.  
 CONCRETE CHASSIS & STAIR GRITS - CARRARA READY MIX PLANT, CLARENDON, VT.  
 REINFORCING STEEL - BETHLEHEM STEEL CORP.  
 METAL CULVERT PIPE - NEW ENGLAND METAL CULVERT CO., WHITE RIVER CT, VT.  
 REPAIRED REINFORCED CONCRETE DRAIN INLET - LMF PIPE CORP., MINNOR, VT.  
 CAST IRON GATES - E. L. LEBRON FOUNDRY CO., BROOKTON, MASS.  
 PROPERTY LINE FENCE, GRANITE SIGN EDGING, TRAFFIC SIGNS - NATIONAL FENCE & GRANITE CO., INC., COVINGTON, N.H.  
 UTENSIL SERVICE BOX - MUELLER CO., DECATUR, ILL.  
 CURB STOP - WELLSBACK CORP., PHILADELPHIA, PA.  
 STANDARD STEEL BEAM GUARD RAIL, STEEL GUIDE & MARKER POSTS - RICHMAN-JAY CORP., GLASTONBURY, CONN.  
 DELINEATORS - UNITED HIGHWAY SIGN CO., INC., BRIDEN, CONN.  
 TREATED TIMBER CURB, PLANK GUARD RAIL, & T.C. CABLE GUARD RAIL - NEW ENGLAND PILE & WOOD TREATING CO., MERRIMACK, N.H.  
 COPPER WATER TUBES - COOKILL MFG. CO., WATERBURY, VT.

CONTRACTOR - COLLETTI, INC. CONTRACT DATE - JUNE 14, 1966  
 RES. ENGINEER - MILTON S. DENNEY DATE - JUNE 14, 1966  
 CHECKERS - JAMES A. DAVIS & E. W. RIMNEY COMPLETED - NOV. 3, 1967  
 RECORD PLANS - P.W. ACCEPTED - NOV. 9, 1967

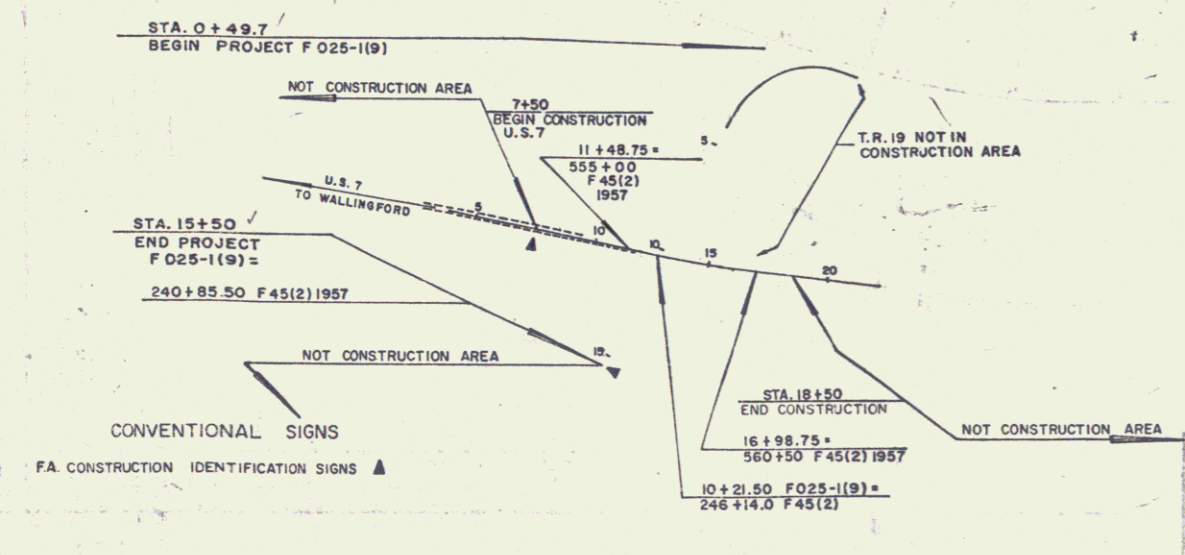

PROJECT Clarendon  
 NUMBER F 025-1(9)  
 TYPE Bituminous Concrete Pavement  
 CONTRACTOR Cooke-Boas, Inc.  
 100 Myler, Ctr.  
 LOCATION Beginning at a point in the edge of U.S. 7, 2.316 miles south of the Clarendon-Rutland T.L. and extending southeasterly 0.284 mile

NOTE: FOR R.O.W. DETAILS, SEE R.O.W. PLANS FOR THIS PROJECT.

THESE PLANS ARE SUBJECT TO SUCH REVISIONS AS MAY BE REQUIRED BY THE BUREAU OF PUBLIC ROADS OR THE COMMISSIONER OF HIGHWAYS.

CONSTRUCTION IS TO BE CARRIED ON IN ACCORDANCE WITH THESE PLANS AND THE STANDARD SPECIFICATIONS FOR HIGHWAY AND BRIDGE CONSTRUCTION DATED APRIL, 1964, AS APPROVED BY THE BUREAU OF PUBLIC ROADS ON OCT. 12, 1964, INCLUDING ALL SUBSEQUENT APPROVED REVISIONS AND SUCH REVISED SPECIFICATIONS AND SPECIAL PROVISIONS AS ARE INCORPORATED IN THESE PLANS.

CLARENDON, F 025-1(9)  
 CONTRACTOR COOKE-BOAS, INC.  
 RES. ENGINEER MILTON S. DENNEY  
 CHECKERS JAMES A. DAVIS & E. W. RIMNEY  
 RECORD PLANS - P.W.

12/23/63  
 11/21/63  
 12/6/63  
 11/21/63

F 025-1(9)  
 54





