
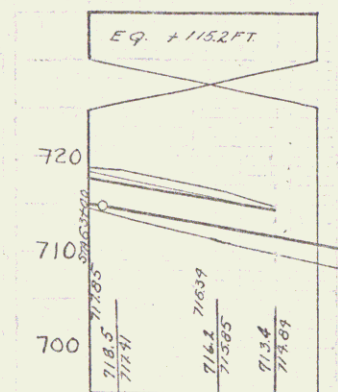


Wood Gravel Rail Required			Cable Gunns Rail Required			New Keint Conc. Pipe Culverts Required					
Culv. Sta.	Left	Right	Sta.	Length	Qty.	Sta.	diam.	Length	Conc. B.	Conc. C.	Steel
65123	24'	-	63100-75193 RT.	1093'	80'	1128'	65123	18"	60'	10 cy.	157'
70123	24'	-				70123	15"	50'	-	2.3	33'
75126	24'	-				73126	15"	36'	1.8	1.7	12.8'
77117	24'	24'				77117	15"	36'	-	2.3	12.8'

Parcel	Kind of Instrument	Date of Instrument	Grantor	Grantee	Recorded Sheet	Book Page	Date	Remarks
A&B	Q.C.D.	1-16-31	W. W. Goodrich	St. of Y. 32	5-6	1-16-31		

STATE OF NEW YORK
 COUNTY OF ...
 No. 125-A 1931 9 54

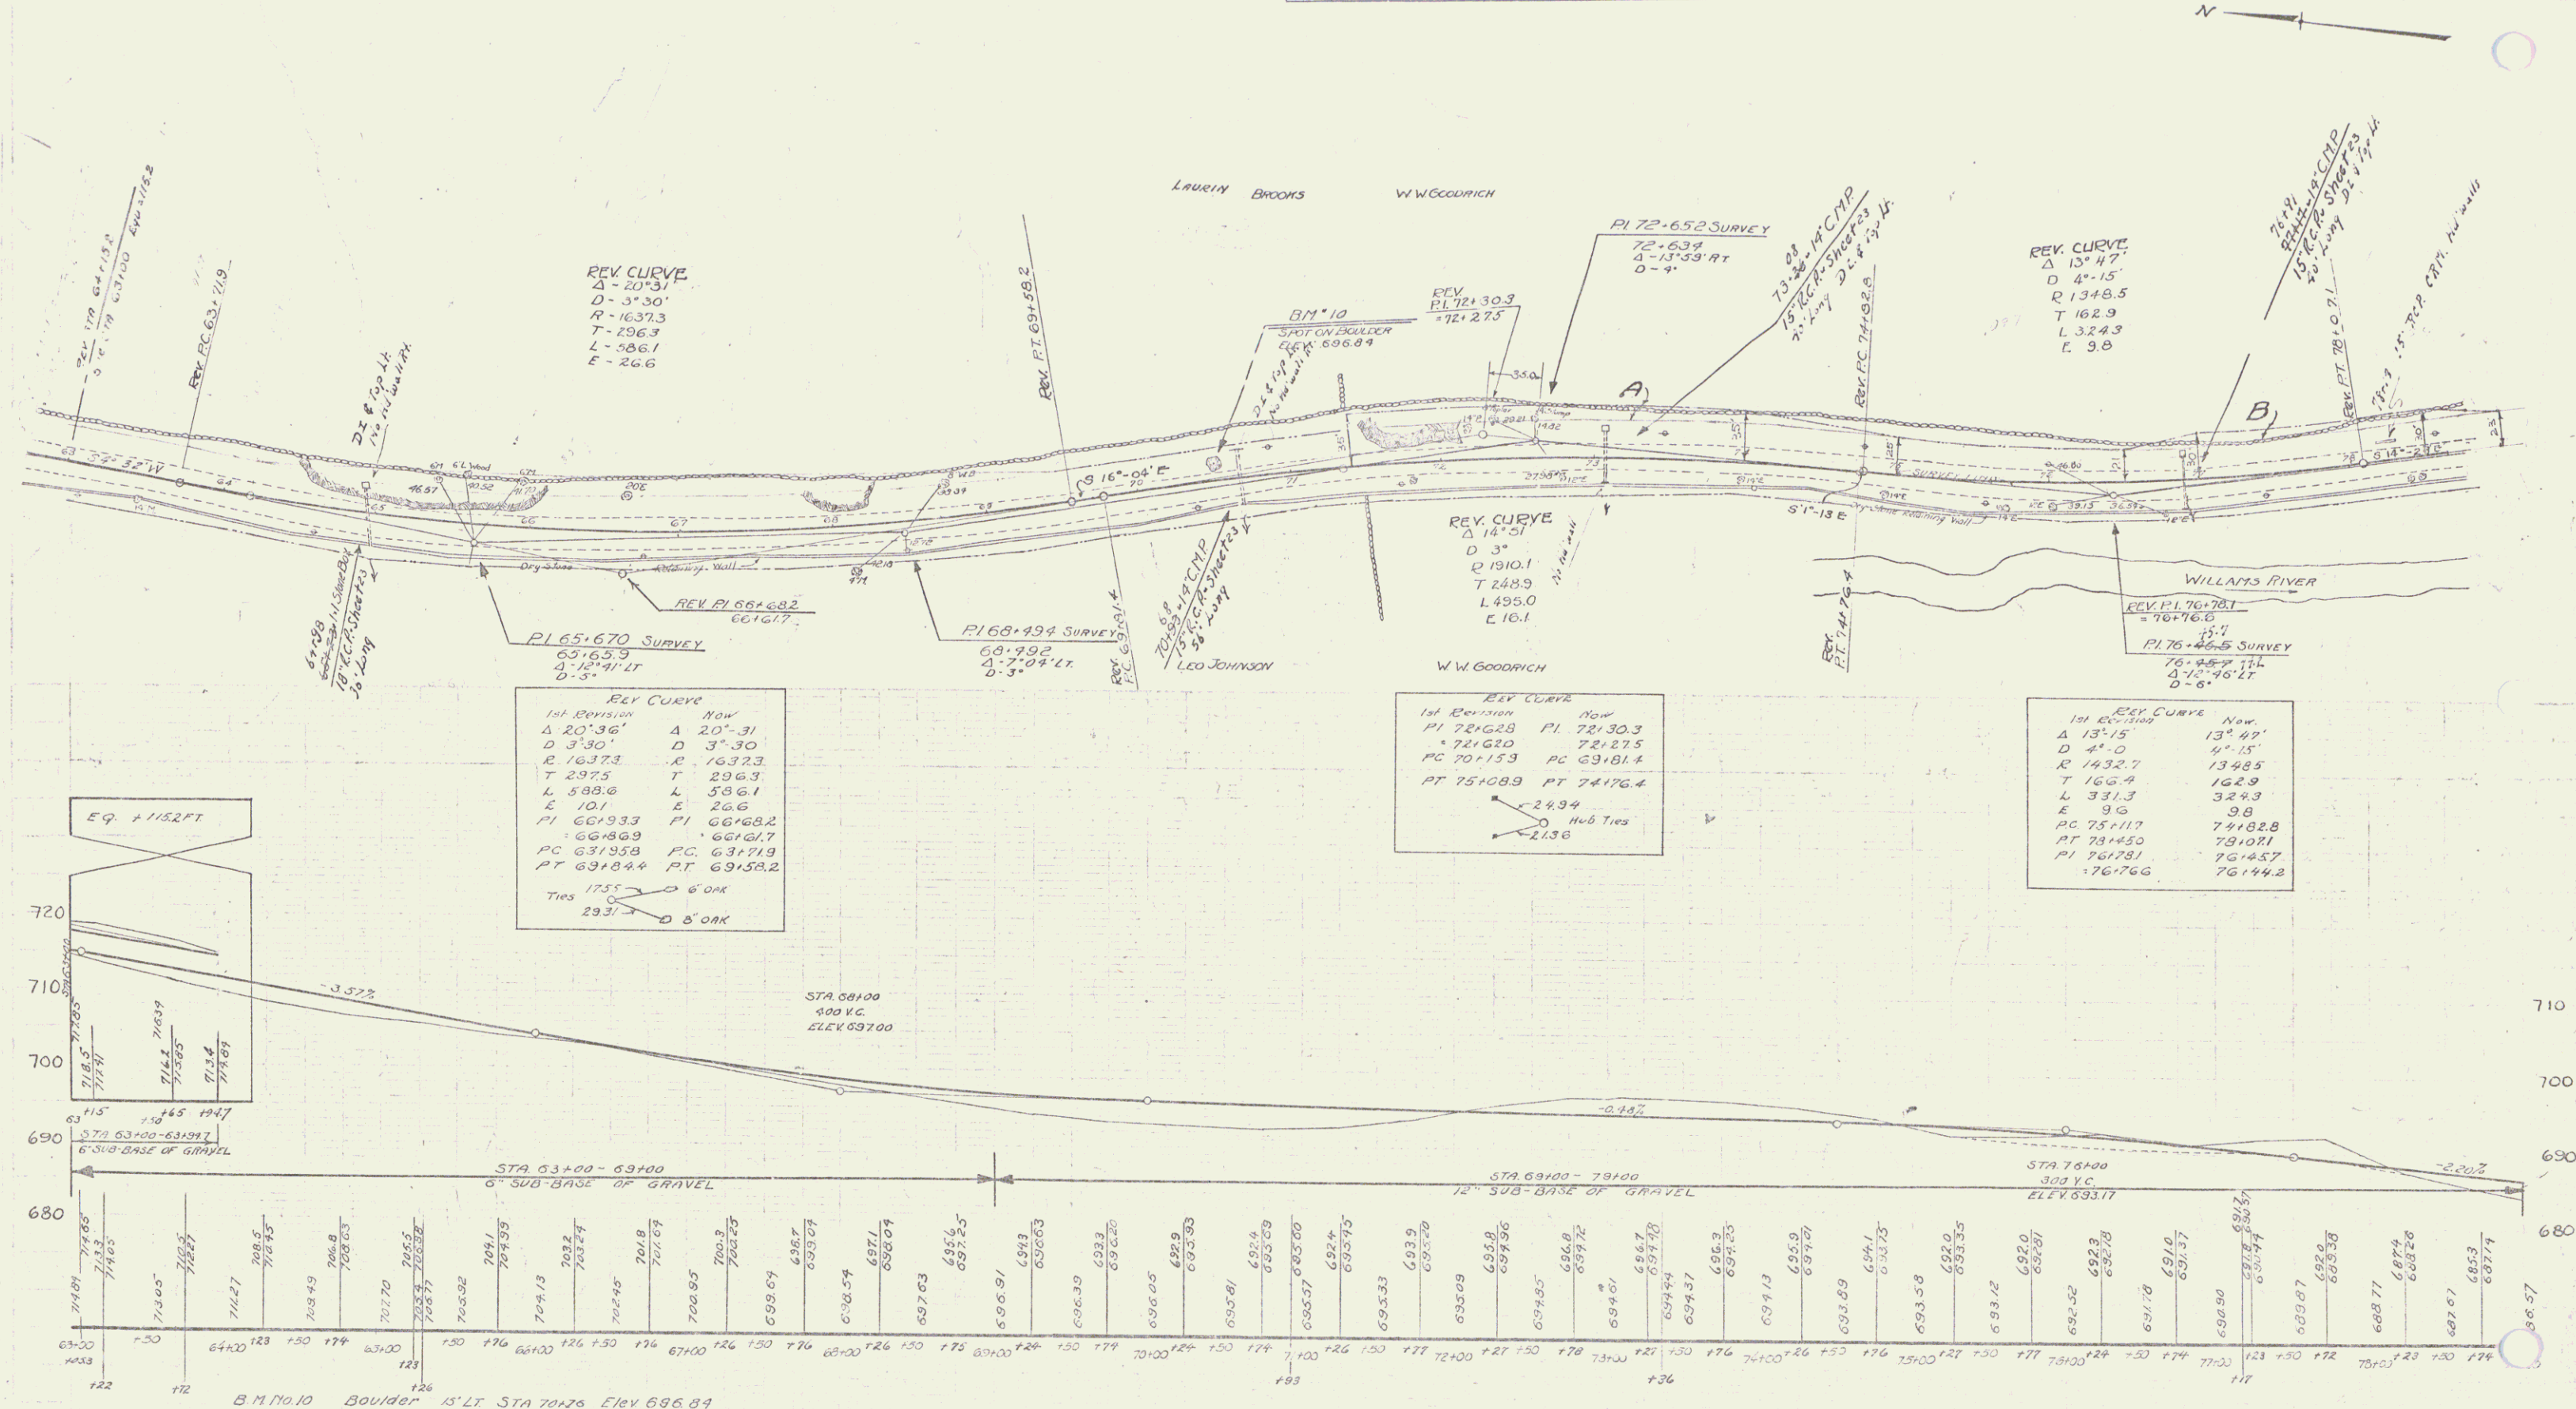

REV CURVE

1st Revision	Now
Δ 20°36'	Δ 20°31'
D 3°30'	D 3°30'
R 1637.3	R 1637.3
T 297.5	T 296.3
L 589.6	L 586.1
E 101	E 26.6
PI 601933	PI 601482
PC 601869	PC 601817
PT 631958	PT 631719
PT 631844	PT 631582

THS 1755' 0" OAK
 2331' 0" OAK

REV CURVE

1st Revision	Now
PI 721628	PI 721303
PC 701153	PC 691814
PT 751089	PT 741764

2494' Hub Trees
 2136'

REV CURVE

1st Revision	Now
Δ 13°15'	Δ 13°47'
D 4°-0'	D 4°-15'
R 1432.7	R 1348.5
T 165.9	T 162.9
L 331.3	L 324.3
E 9.0	E 9.8
PC 751117	PC 741828
PT 751150	PT 751081
PI 751181	PI 751157
1761766	761442

