


WOOD GUANO RAIL REQUIRED			CABLE GUANO RAIL REQUIRED			NEW ROUND CORR. PIPE CULVERTS REQUIRED				NEW CORRUGATED GALV. METAL PIPE CULVERTS REQUIRED			
Culv. Sta.	Left	Right	Sta.	Long	Const. Prg. Leng.	Sta.	Diam.	Leng.	Cont. #	Steel	Station	Diam.	Length
95+22	24'	-	93+00	97+78.6	478'	60	530	93+22	36"	32'	4.0 cy	58"	111'
95+24	24'	-						96+20	15"	32'	1.4	111"	
103+48	24'	24'						103+48	24"	36'	2.8	103"	

STATE OF PENNSYLVANIA
 DIVISION OF HIGHWAYS
 PROJECT NO. 125A
 SHEET NO. 54

Parcel	Kind of Instrument	Date of Instrument	Grantor	Grantee	Recorded Chester	Remarks
A	RCD	9-30-31	A.B. Pollard	Staff	Book 31 Page 638	Date 10-31

Sta 95+00 - 105+00 ± Rock Excavation thru this section is to be used as Rock Fill (non pay item) at such locations as shown on layouts or as directed by the Engineer. No rock is to be wasted.

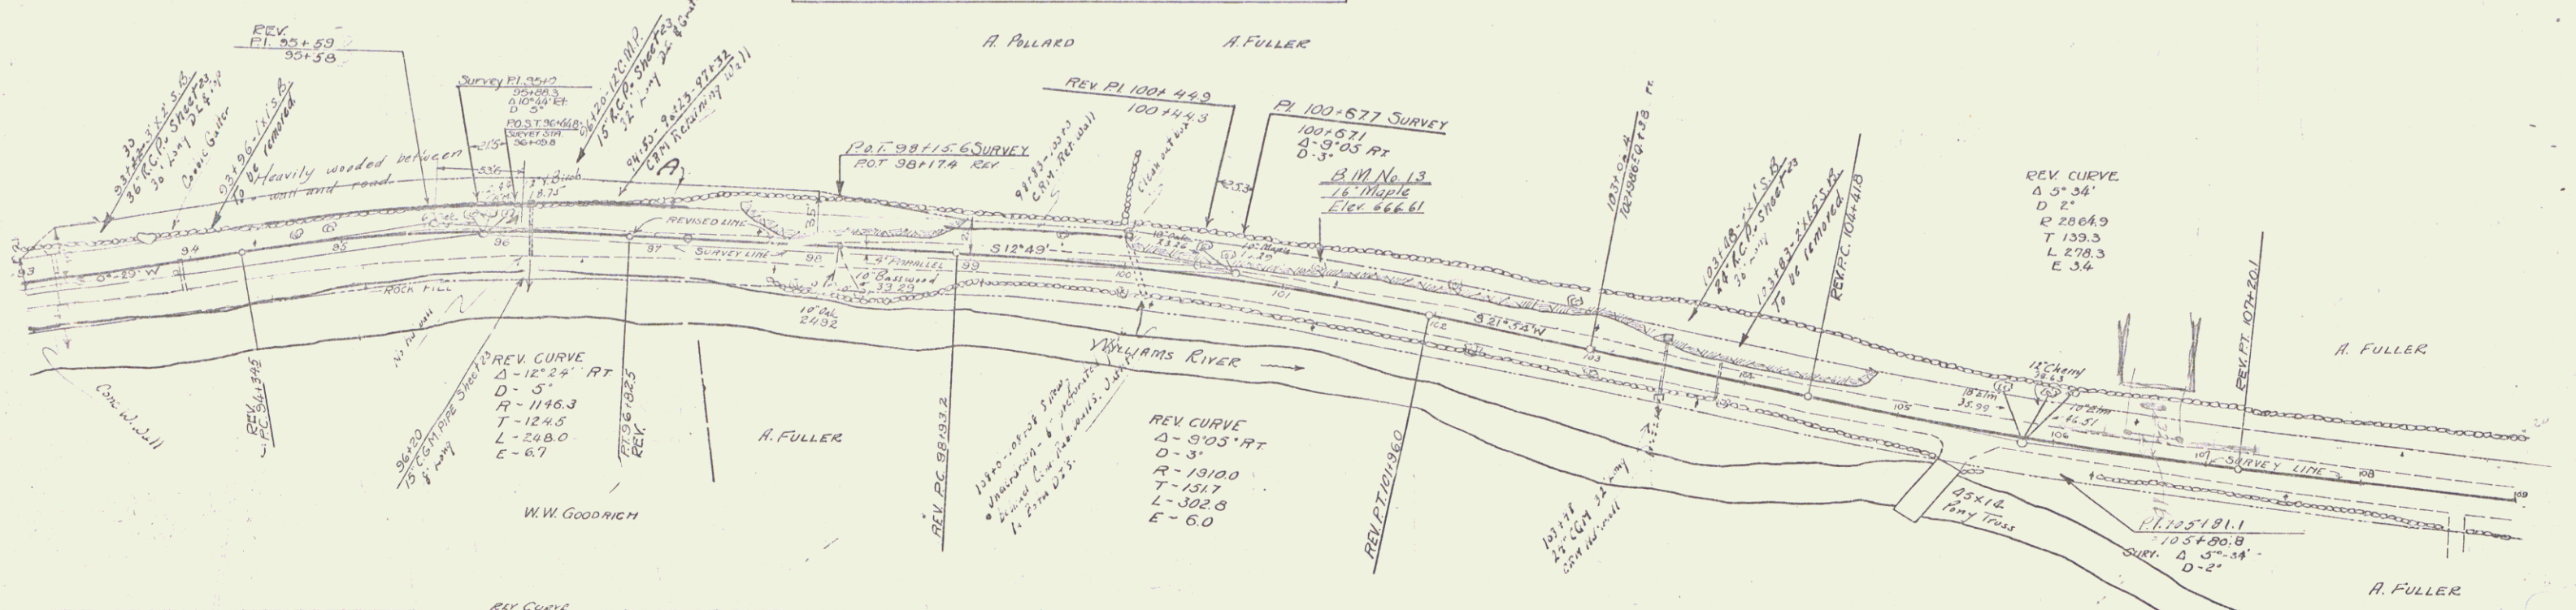


REV. CURVE

1st Revision	12° 20'
2nd	12° 27'
Δ	12° 20'
D	5° 0'
R	1146.3
T	123.3
L	246.7
E	7.7
PI	95+92.3
PC	95+191.2
PT	95+389.4
PC	94+58.4
PT	97+151
Elev	96+182.5

REV. CURVE

1st Revision	100+781
2nd	100+443
PI	100+775
R	99+26.4
T	101+96.0
L	12.03
E	32.0
PI	100+781
PC	100+443
PT	101+96.0
PC	99+26.4
PT	101+96.0
Elev	95.87

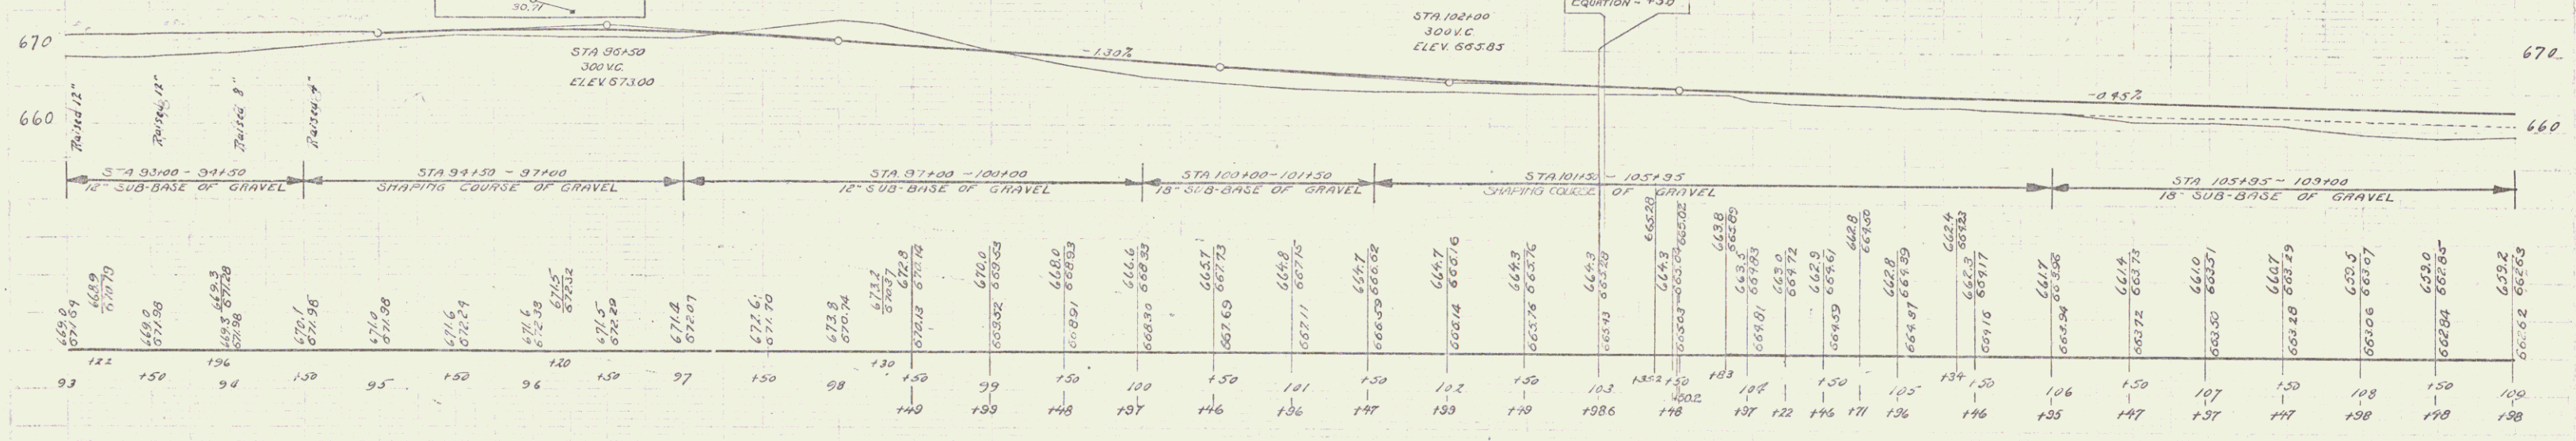

B.M. No. 13 16" Maple 13.5' LT Sta 101+18 Elev 666.61