



Wood Gravel Rail Required	Cable Guard Rail Required	New Reinf Conc. Arch Culverts Required	New Coprivated Galv Metal Pipe Culverts Required	New Reinf Conc. Driveway Pipes Required	Grouted Cobble Gutter Required
Culv. Sta.	Left Right Sta. Leng. Const. By Leng.	Sta. Diam. Leng. Conc. H. Conc. C. Steel	Station Diam. Length	Sta. Diam. Leng. Const. Rubble Massing	Sta. Width Area
113448	24' - 113448-113448 RT 200' 40' 280'	113460 24" 80' 13cy. 127"	113+60 24" 16'	113450 15' 22' 2.6 cy.	11670 RT 3'-0" 3.37 yds
114131	24' - 114131-114131 RT 96' 40' 136'	116151 18" 40' 30cy. 33"			
	101400-101400 RT 80' 40' 138'				
	102135-102100 RT 69' 20' 84'				

NO. 100 STATE ROAD DISTRICT 10
 125-A 1951 12 54

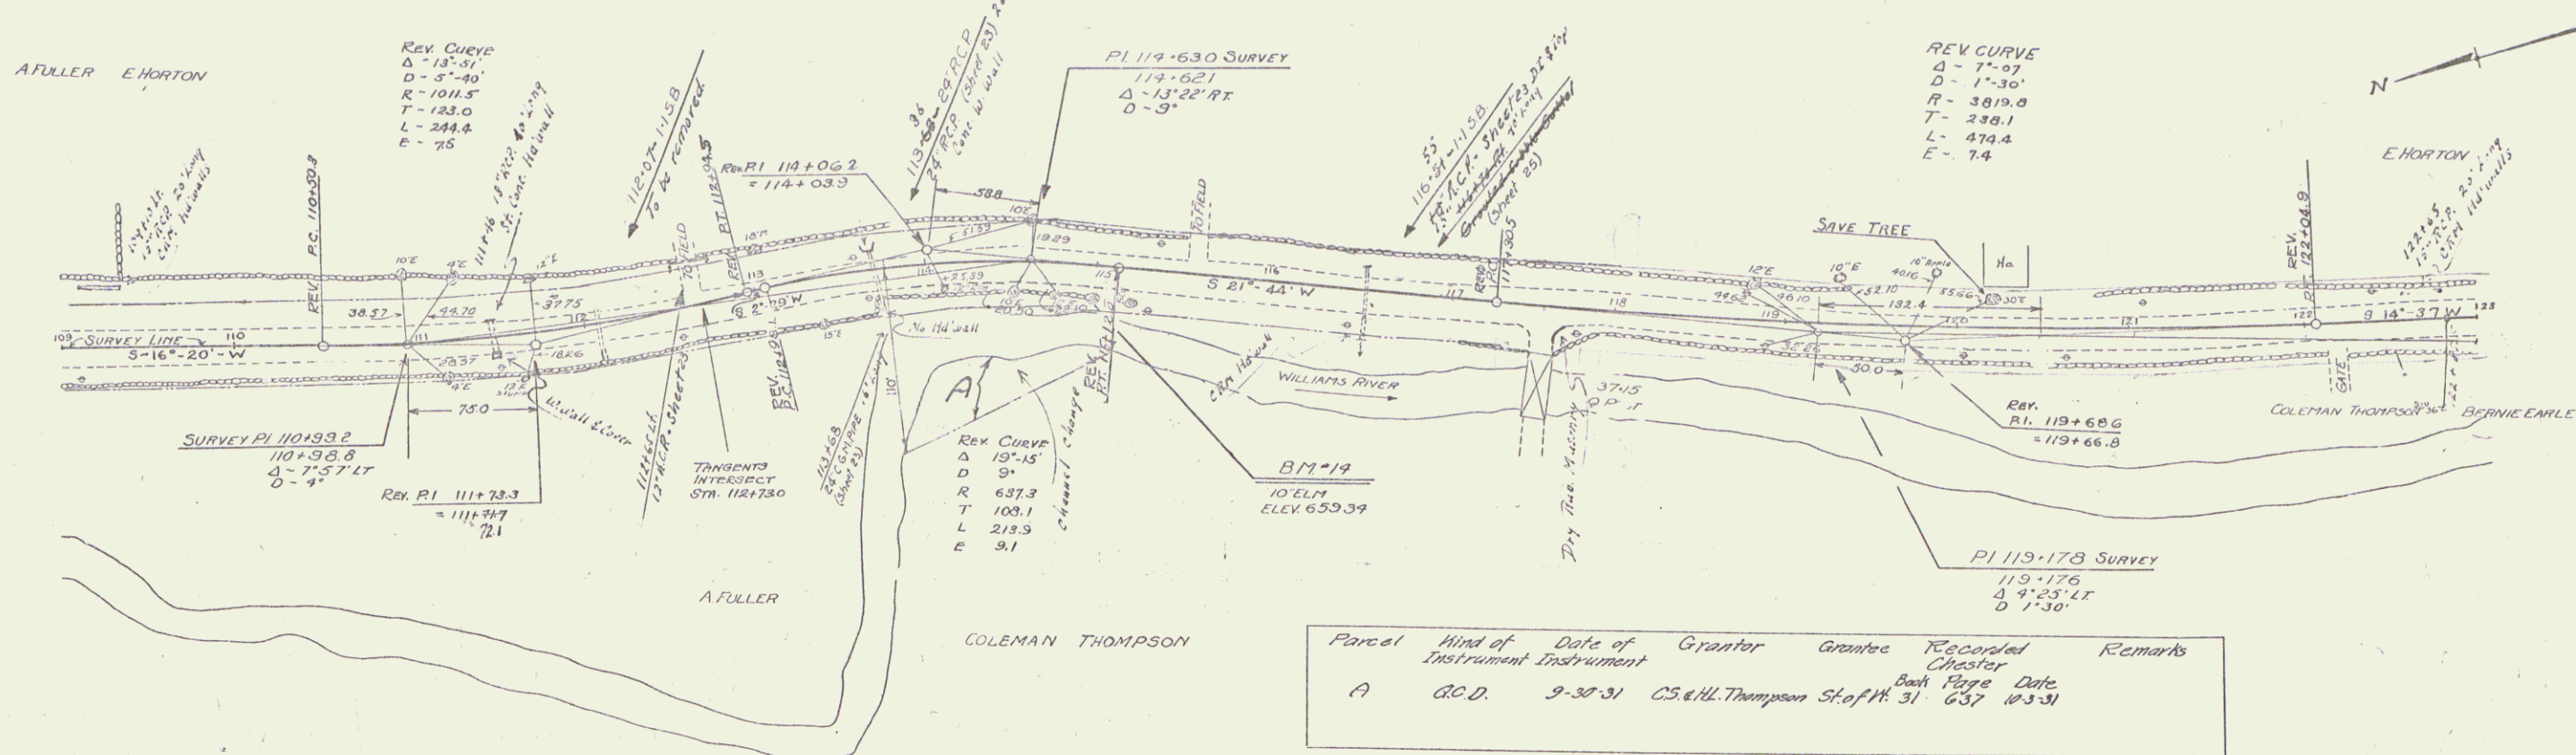

1st Revision	Now
Delta 13' 51'	13' 48'
D 5' 40'	5' 40'
R 1011.5	1011.5
T 123.0	122.9
L 244.4	243.6
E 7.5	7.4
PI 11173.3	11173.3
PI 11171.7	11172.1
P.C. 110+50.3	110+50.9
P.T. 112194.7	112+345

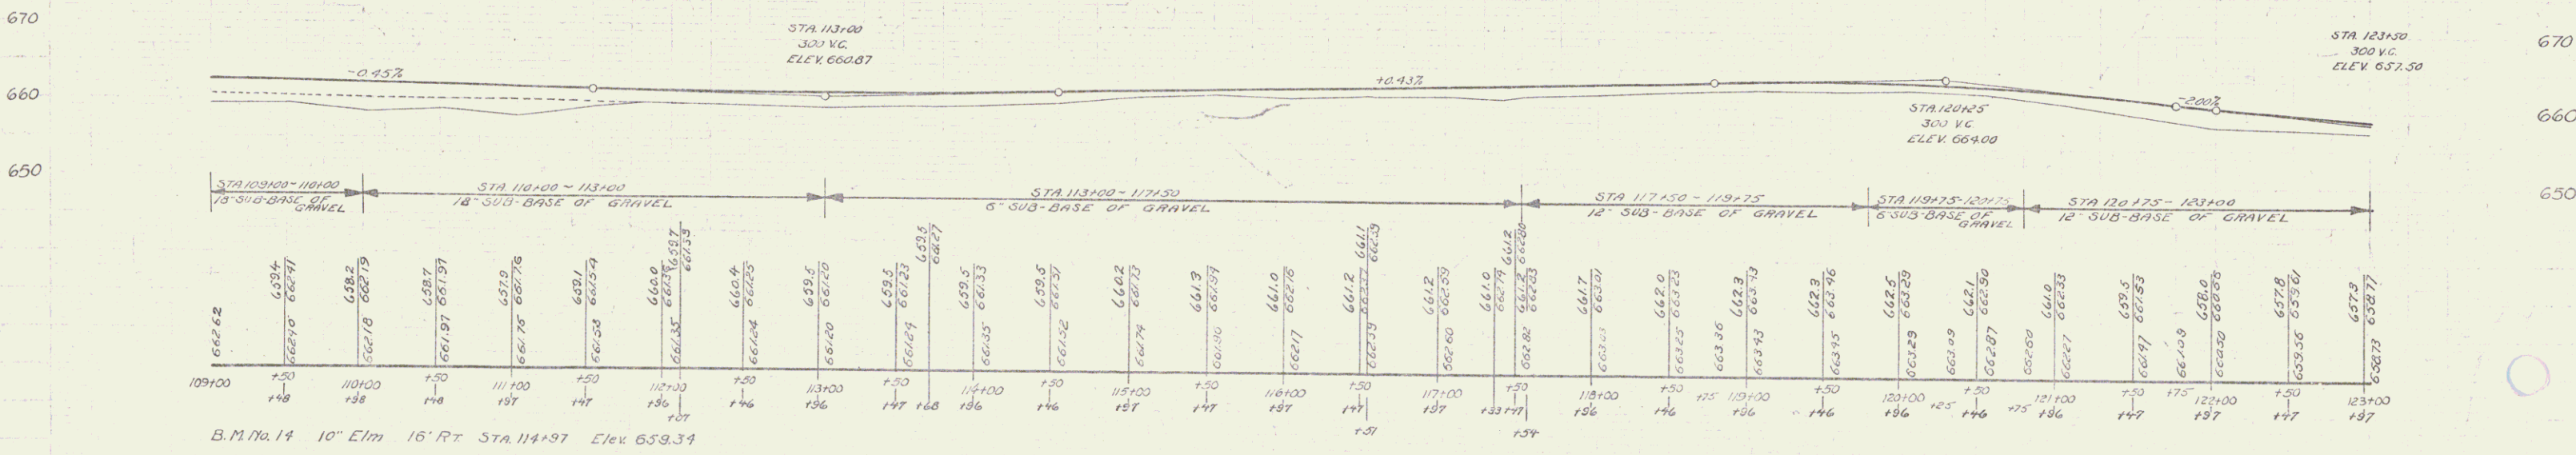

SERIES E No. 125-A
 Sheet 12 of 54