


WOOD GUARD RAIL REQUIRED			CABLE GUARD RAIL REQUIRED			New KEENE CONC. PIPE CONCRETE REQUIRED					
Cully Sta.	Left	Right	Sta.	Long. Center	By-Leng.	Sta.	Diam	Length	Conc. H.	Conc. C.	Steel
124740	24'	-	128100-128100	198'	20'	128160	15"	36'	18	-	54"
126745	24'	24'				126765	18"	36'	18	-	54"
131197	24'	24'				131197	18"	40'	-	3.0	33"
133195	24'	24'				133195	18"	40'	24.4	-	34"

Parcel	Kind of Instrument	Date of Grant	Grantee	Grantee Recorded	Remarks
A. Cully 749	C.C.D.	7-27-31	B. M. J. Earle	Sta. 7 6/6	7-27-31 Cully Sta. 131194, 133195

ROAD STATE NEW YORK PLATS SHEET NO. 125-A
 5 125-A 1951 13 54

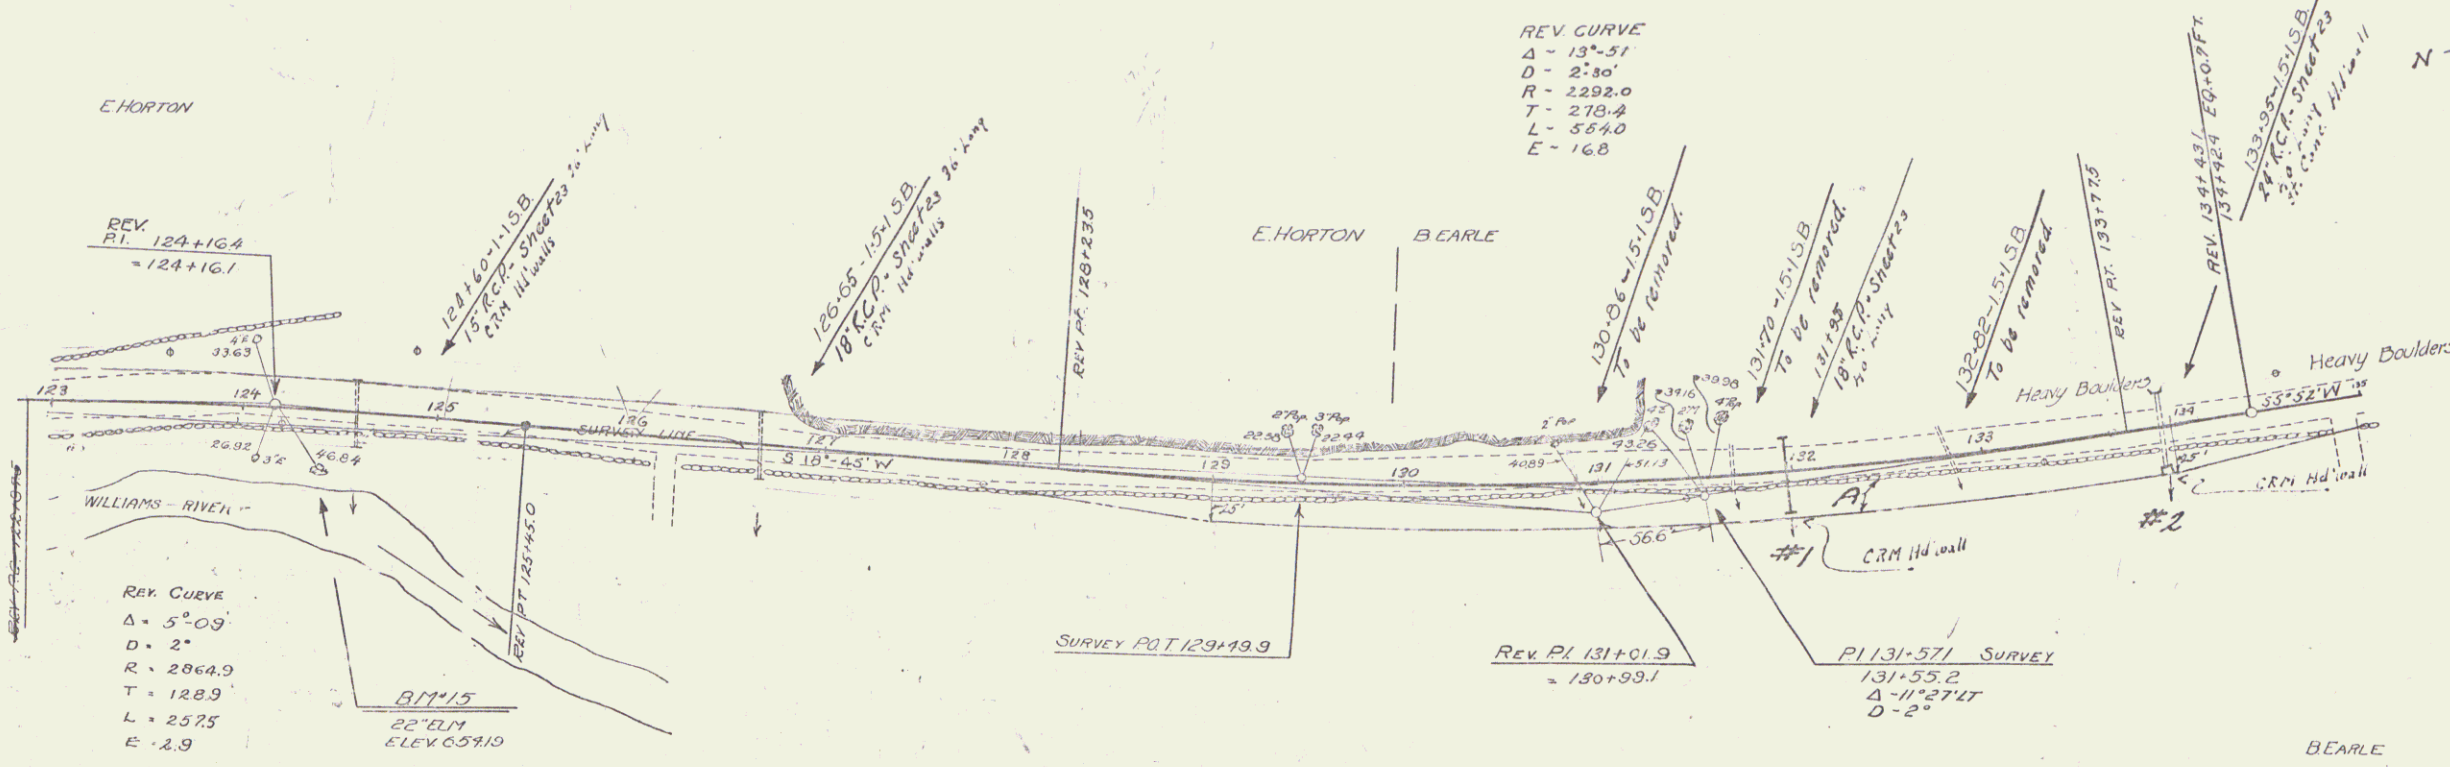

1st Remainder	Now
Δ 4°-08'	5°-09'
D 2'-0"	2'-0"
R 2064.9	2064.8
T 103.4	128.9
L 206.7	257.5
E 1.9	2.9
P.I. 124+156	124+164
P.C. 123+12.3	122+18.25
P.T. 125+130	125+45.0

1st Remainder	Now
Δ 13°-29'	13°-51'
D 2'-30"	2'-30"
R 2292.0	2292.0
T 270.9	278.4
L 539.3	554.0
E 13.7	16.8
P.I. 131+00.3	131+01.9
P.C. 128+30.0	128+23.5
P.T. 133+69.3	133+72.5

