
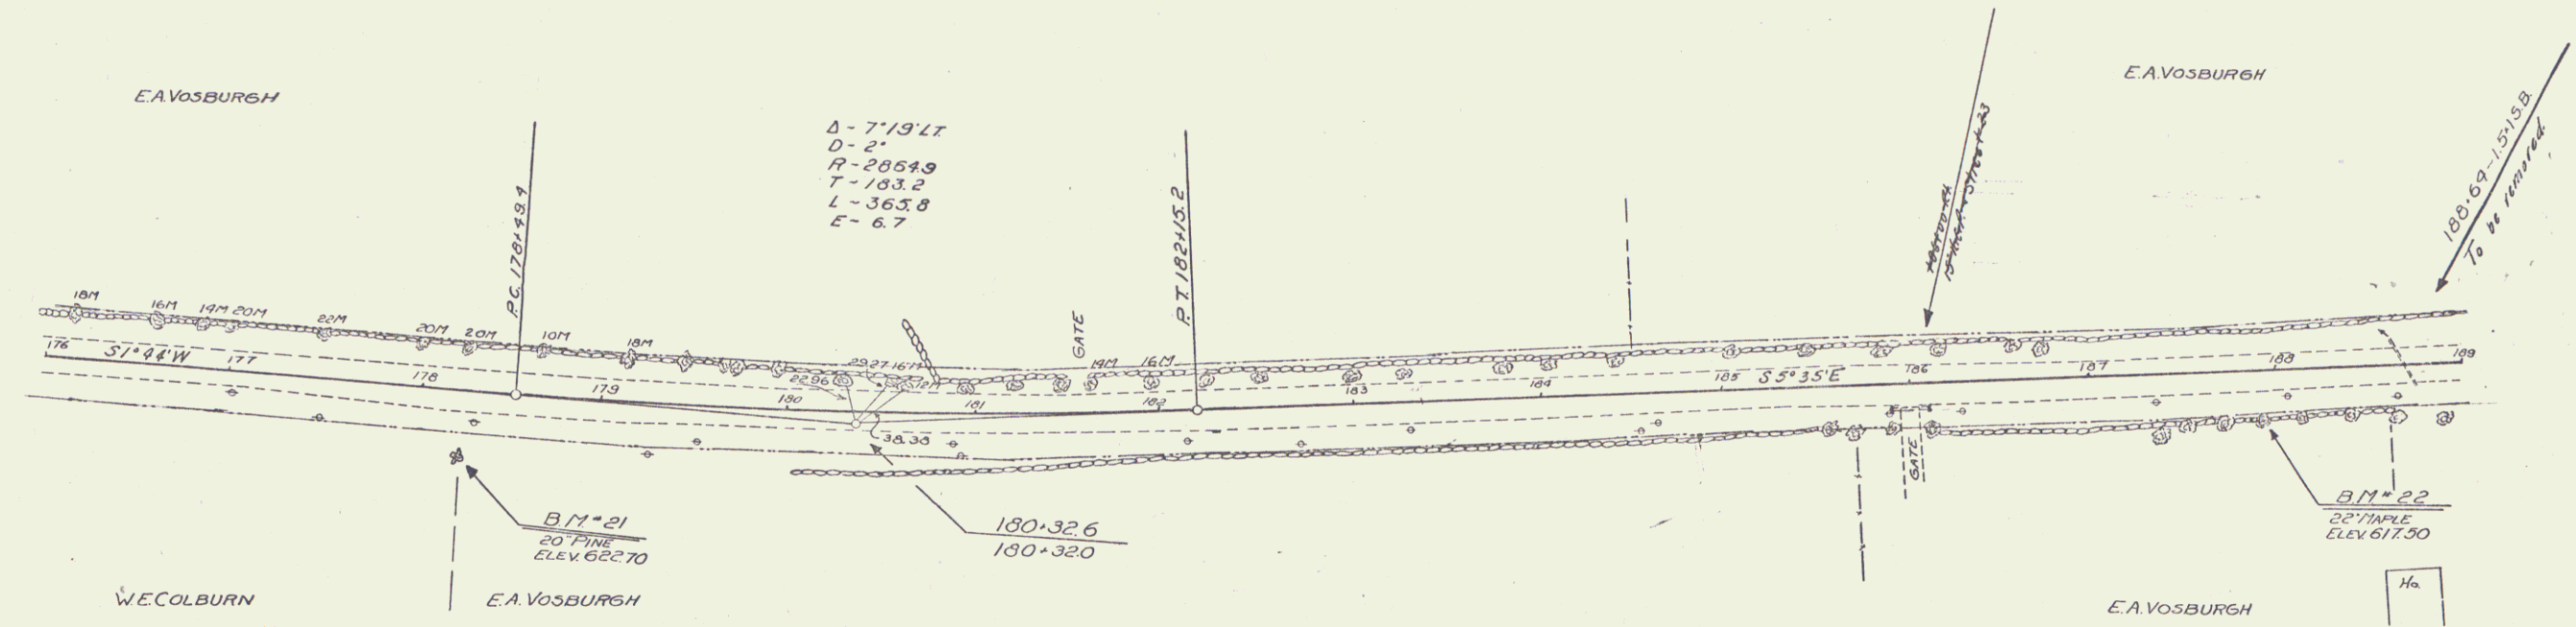



NEW REINF CONC DRAINAGE PIPES REQUIRED
 Sta. Bluff Leq. Cem. Reb. Mar.
 186100 R 15' 24' 16 cy

DATE	STATE	NO.	SHEET	TOTAL
125-A	1931	17	54	

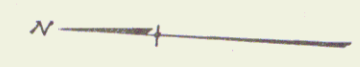

GRADE REVISION IN FIELD

18150 - 185100	0.16 FT.
18150	Raised 0.50"
18210	" 1.00"
18250	" 1.08"
18310	" 1.00"
18410	" 0.42"
18510	" 0.16"

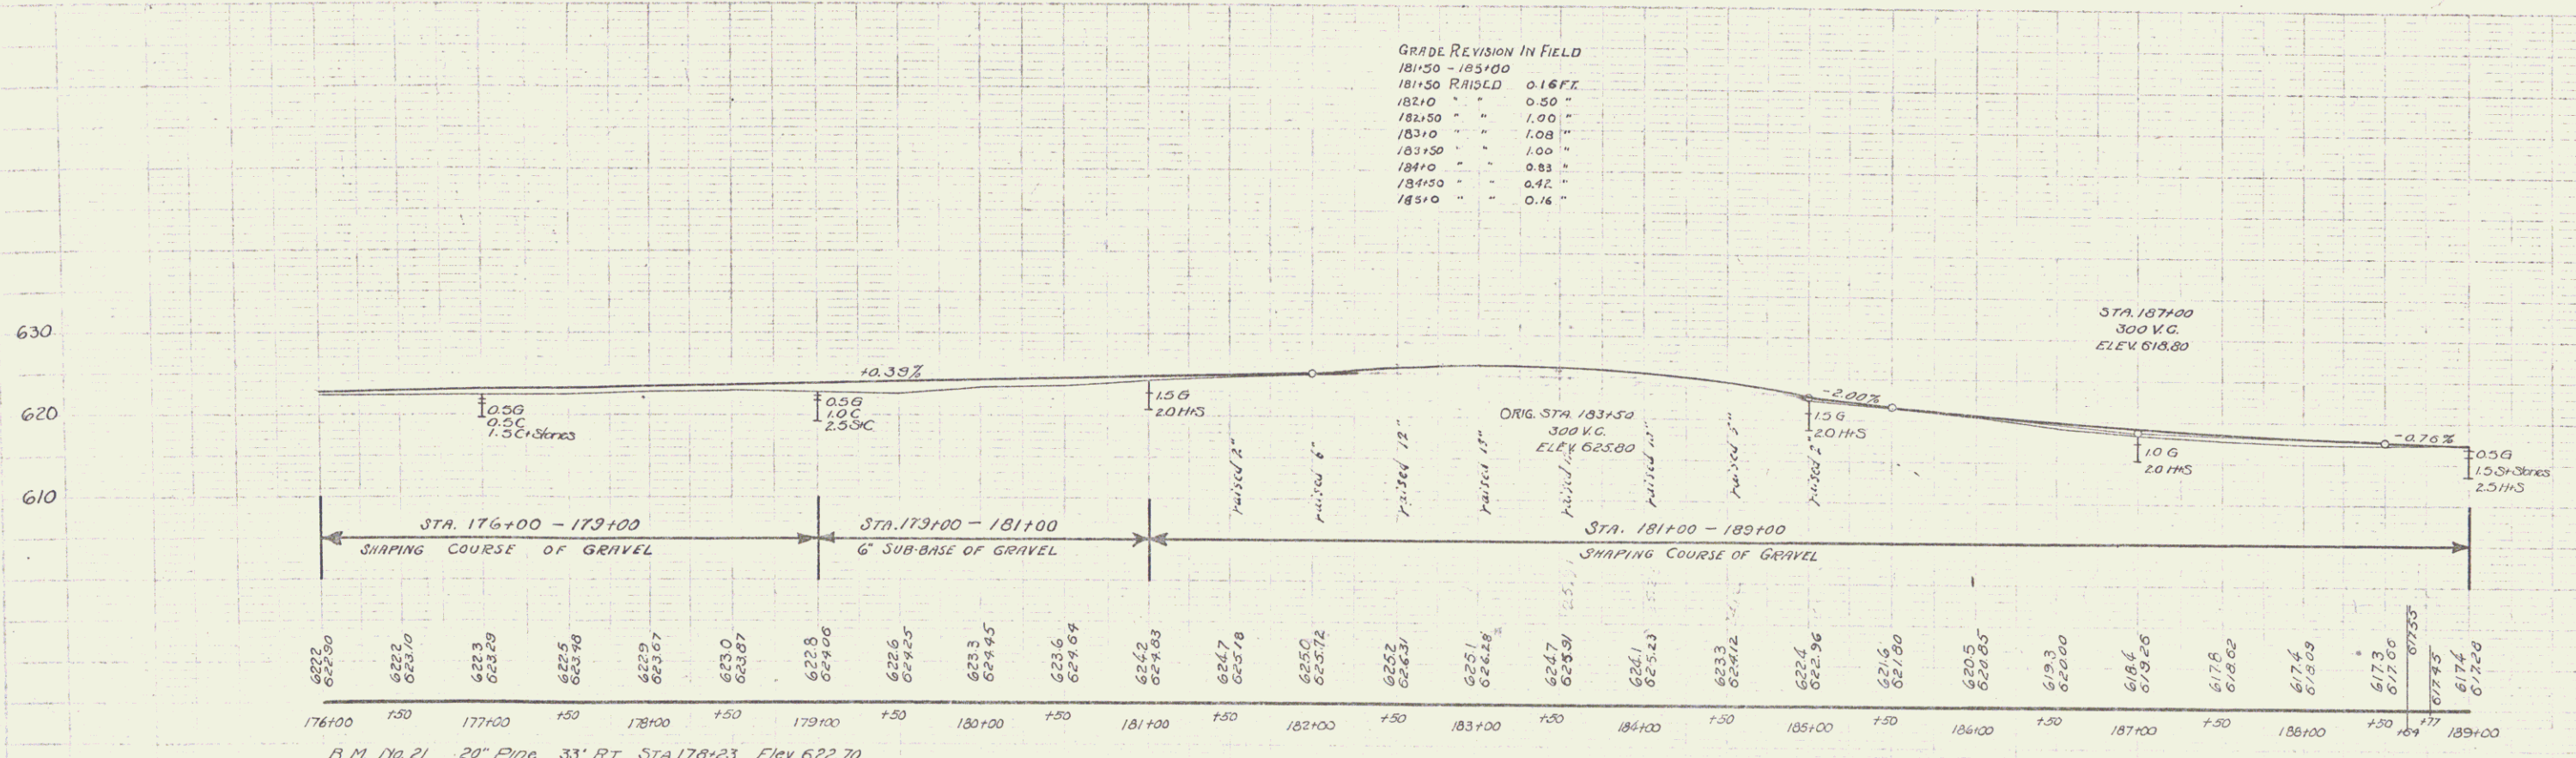

B.M. No. 21 20" Pine 33' RT. STA. 178+23 Elev 622.70
 B.M. No. 22 22" Maple 24.5 RT. STA. 187+93 Elev 617.90

SERIES F No 125-A
 Sheet 17 of 54