
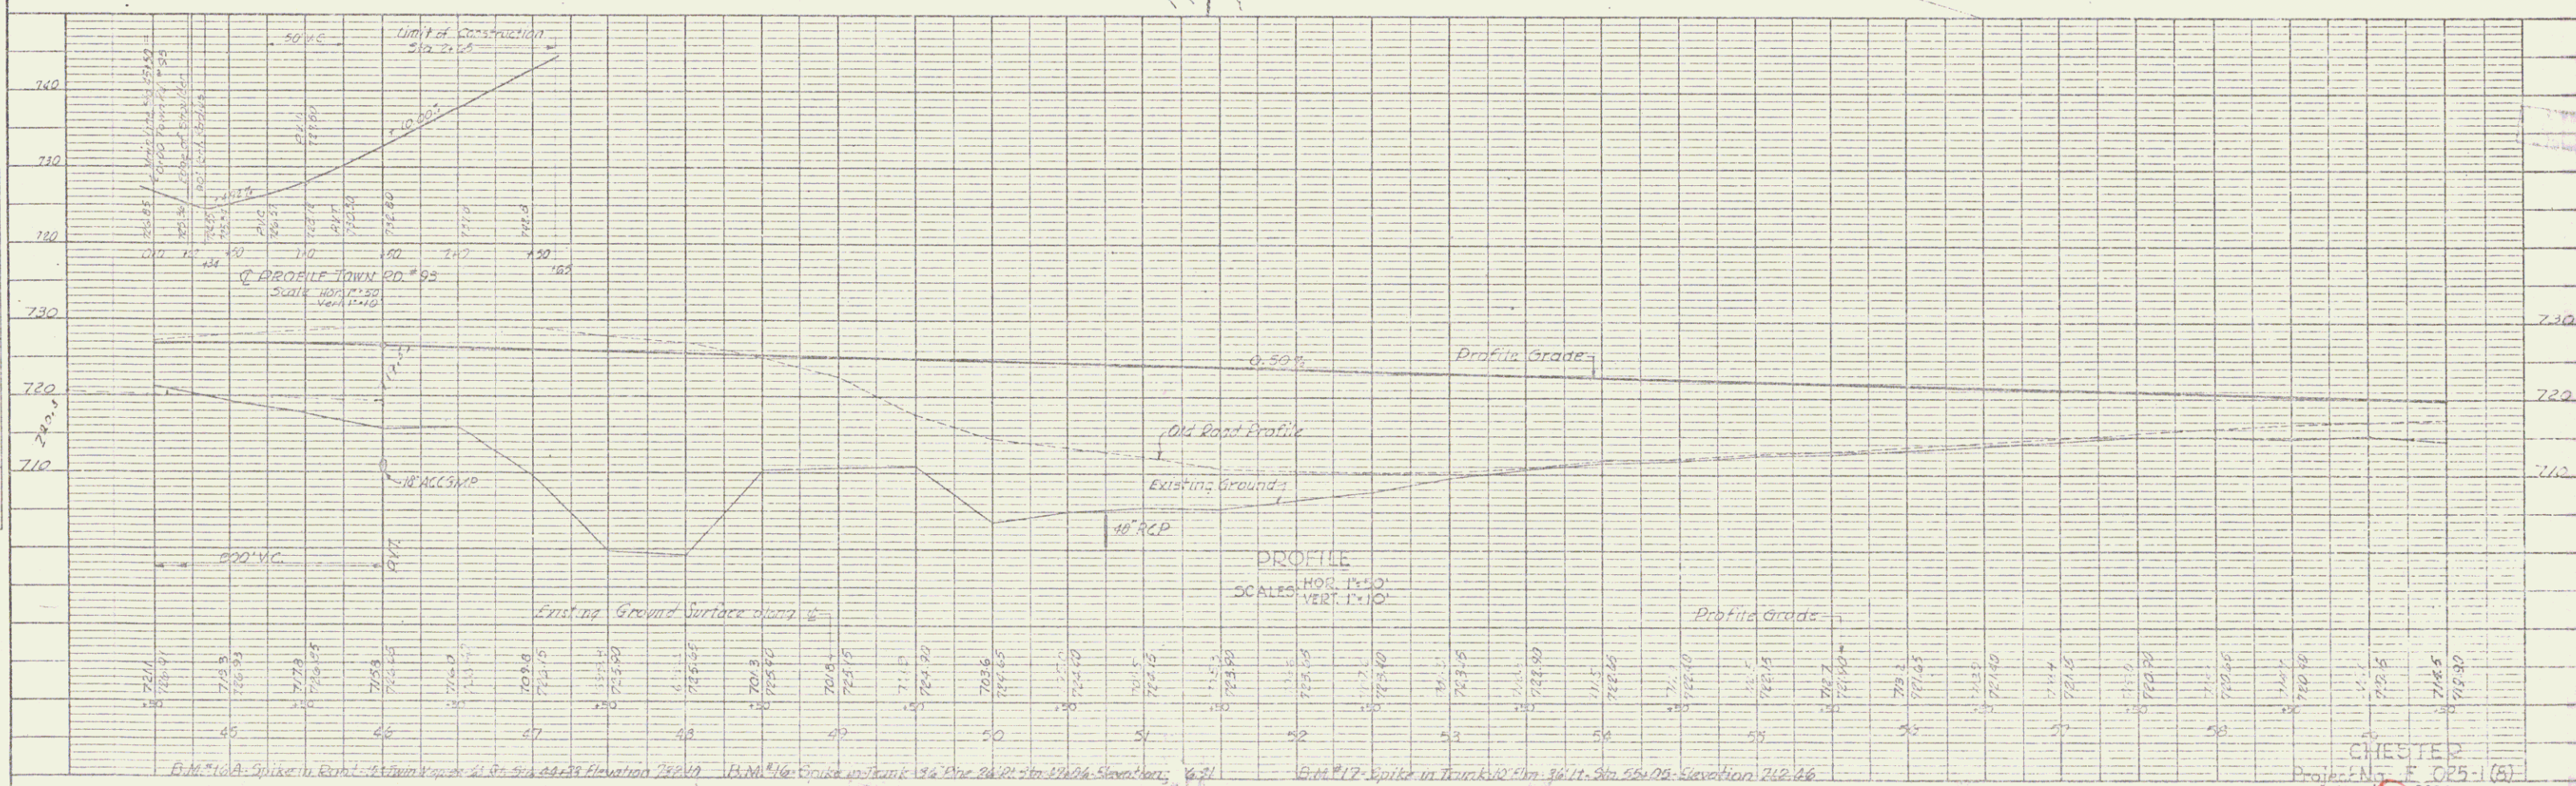


PLAN	DATE
REVISED	
NOTE BOOK	
AS QUANTIFIED	
NO.	

PROFILE	DATE
REVISED	
NOTE BOOK	
AS QUANTIFIED	
NO.	

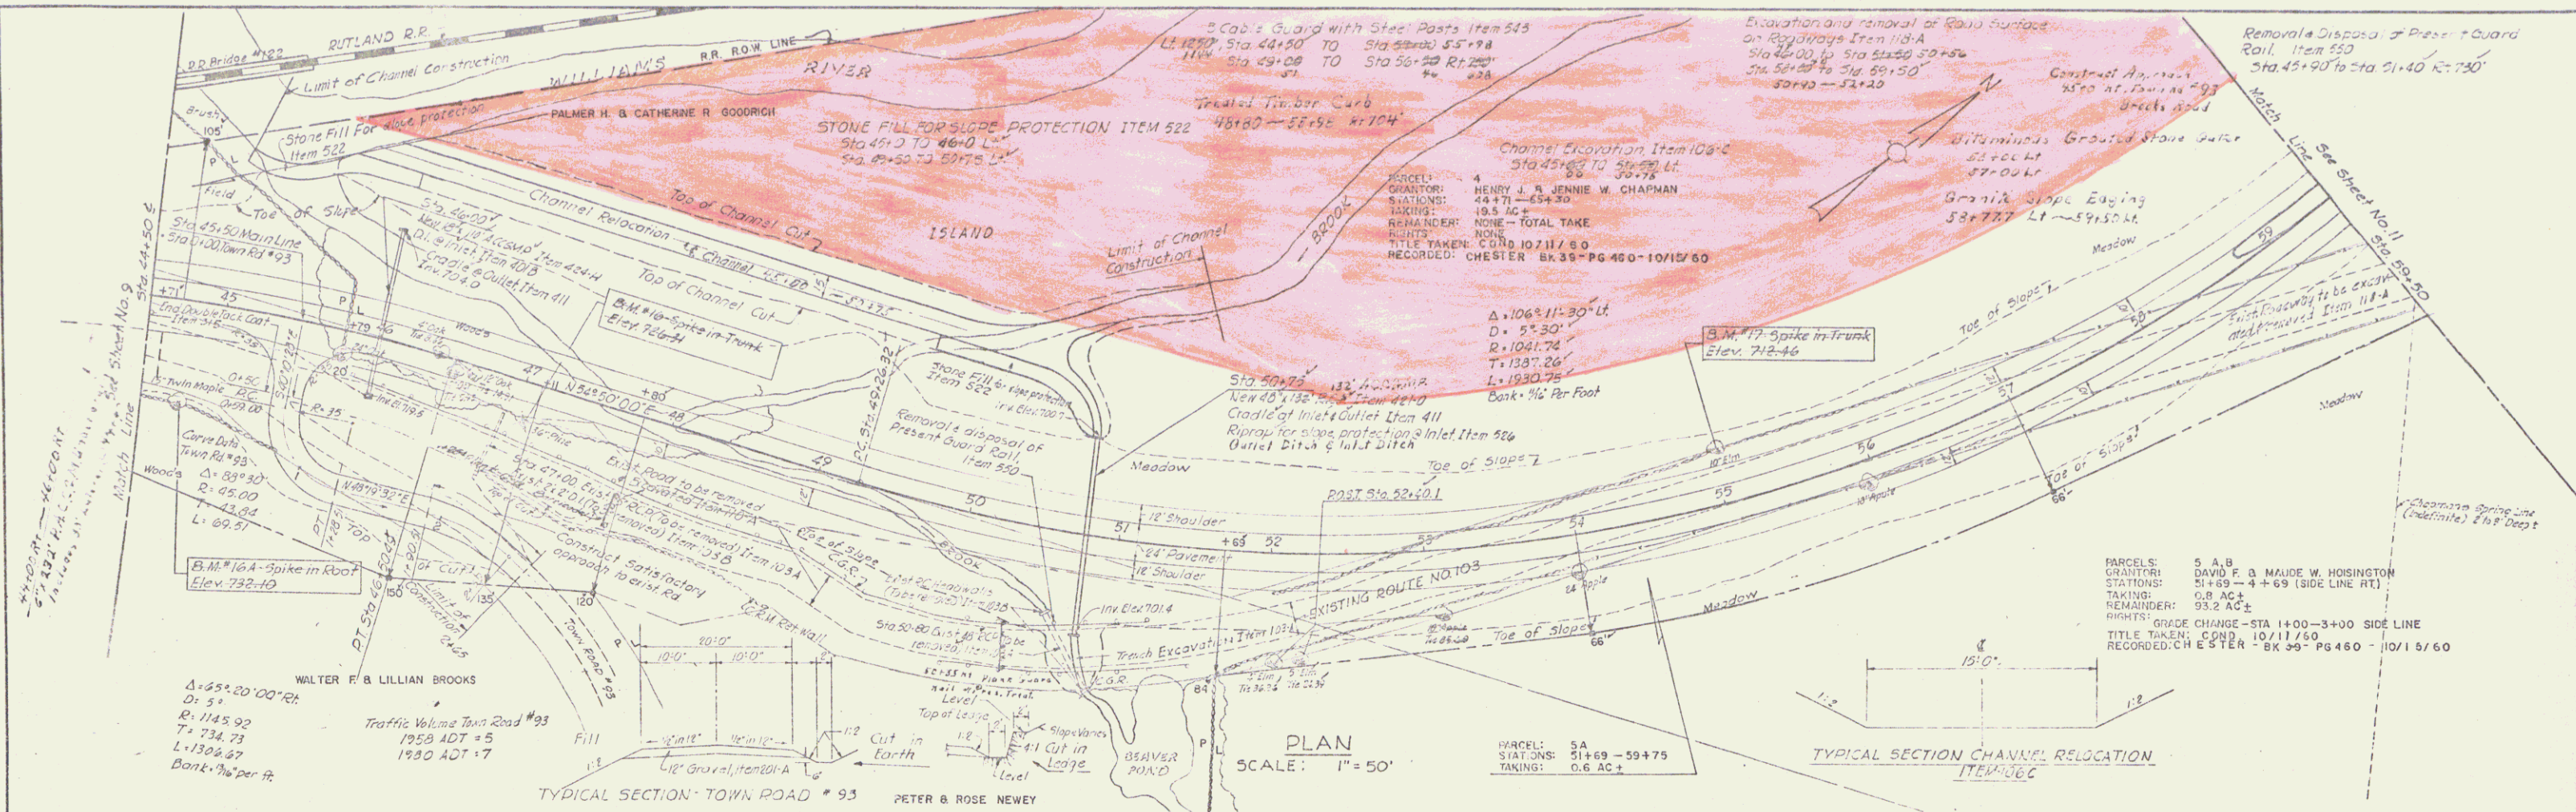

CHESTER
Project No. 025-1 (A)
Sheet 10 of 20B