
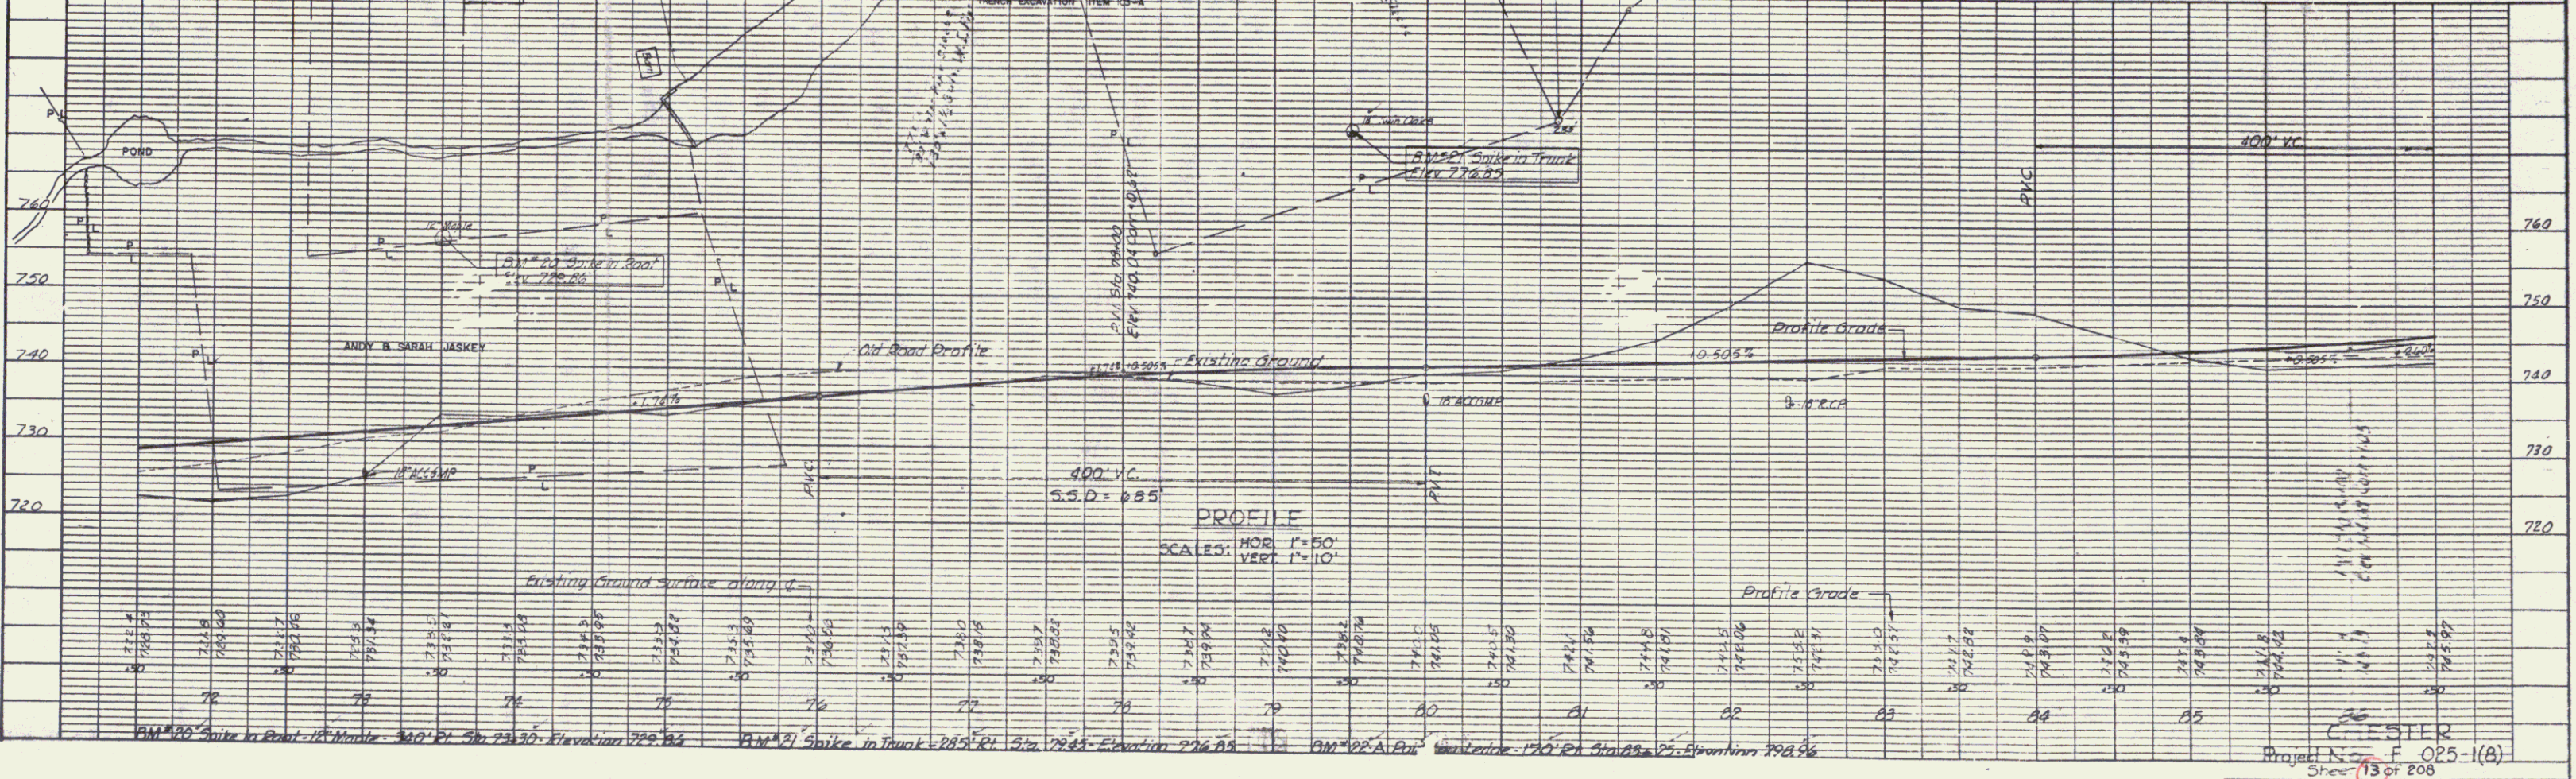


DATE: _____ BY: _____
 PLAN
 SURVEYED: _____
 CHECKED: _____
 DATE: _____
 BY: _____
 NO. _____

DATE: _____ BY: _____
 PROFILE
 SURVEYED: _____
 CHECKED: _____
 DATE: _____
 BY: _____
 NO. _____

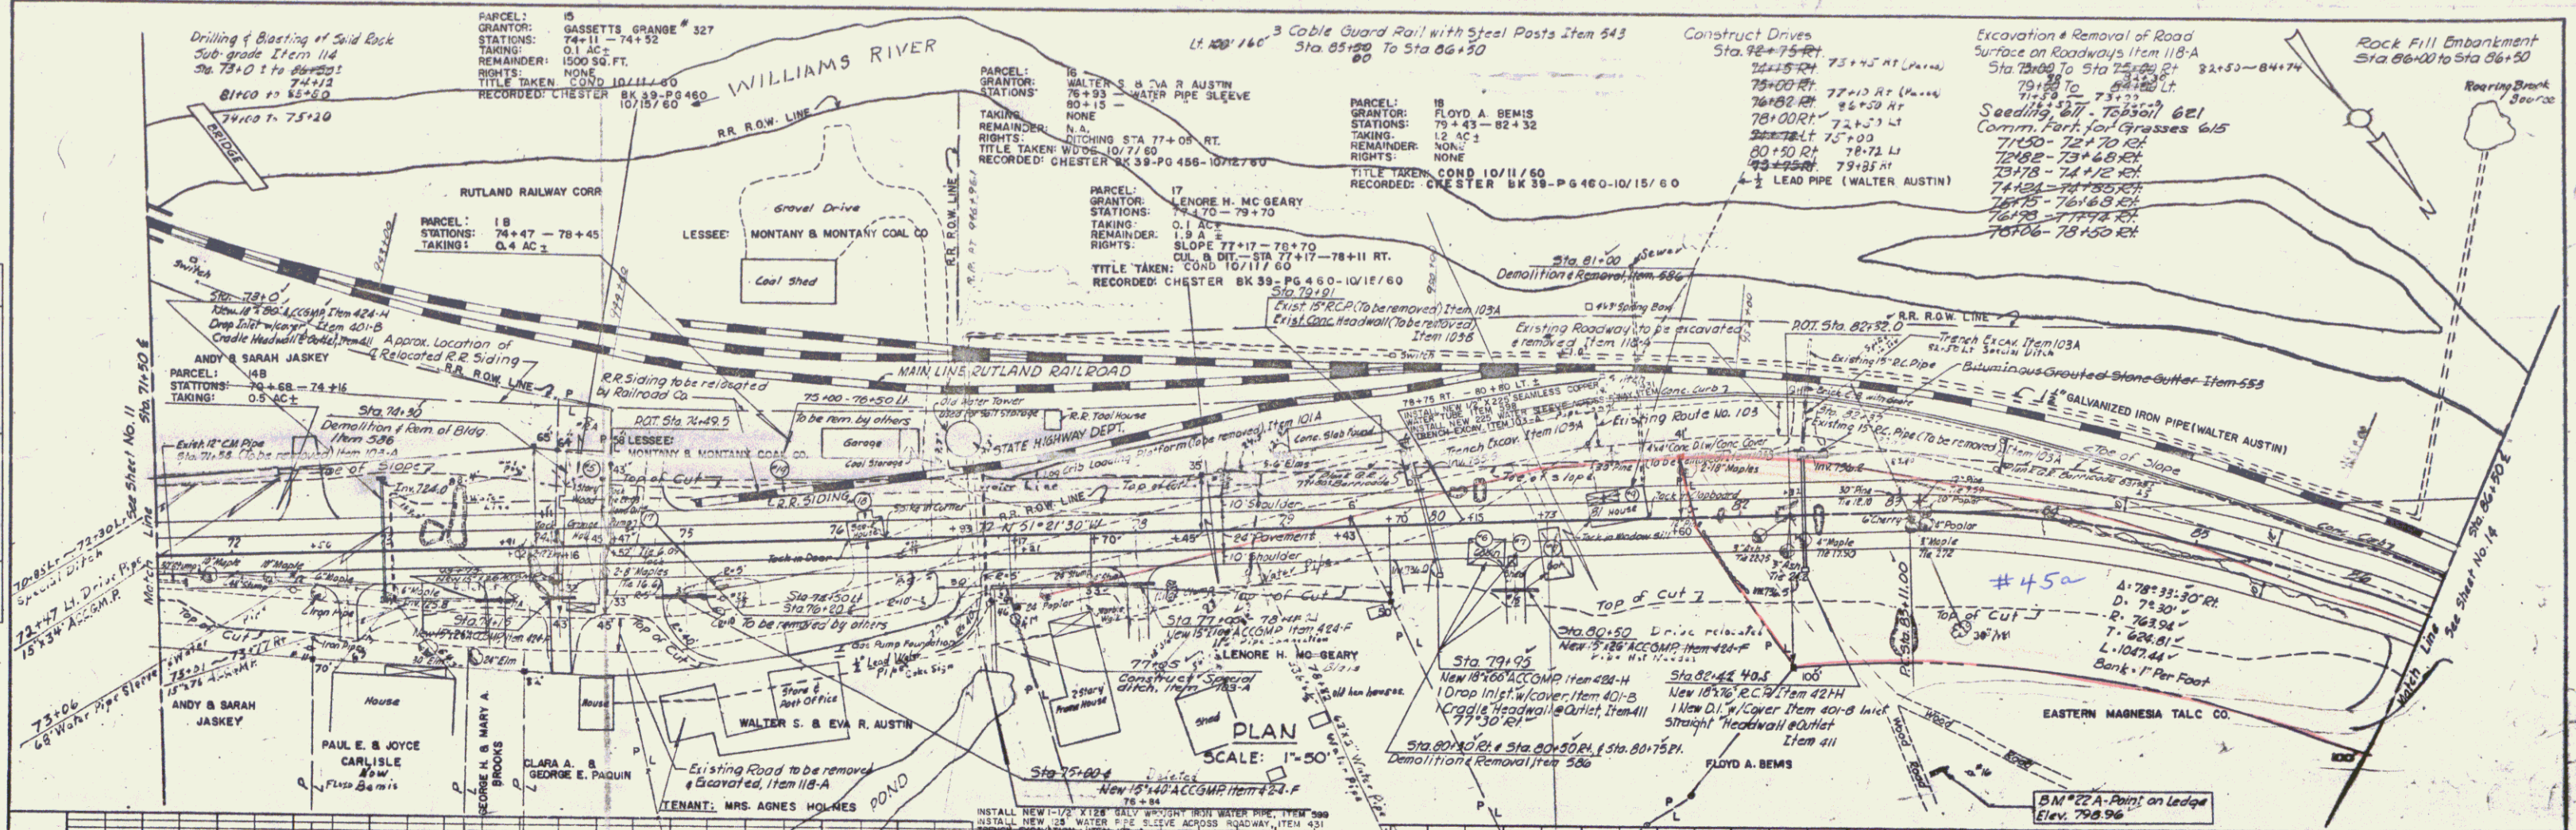

Project No. F 025-1(A)
 Sheet 13 of 208

7