


DATE	
BY	
PROJECT	
SCALE	
REVISIONS	
NO.	
DESCRIPTION	
DATE	
BY	
PROJECT	
SCALE	
REVISIONS	
NO.	
DESCRIPTION	
DATE	
BY	
PROJECT	
SCALE	
REVISIONS	
NO.	
DESCRIPTION	

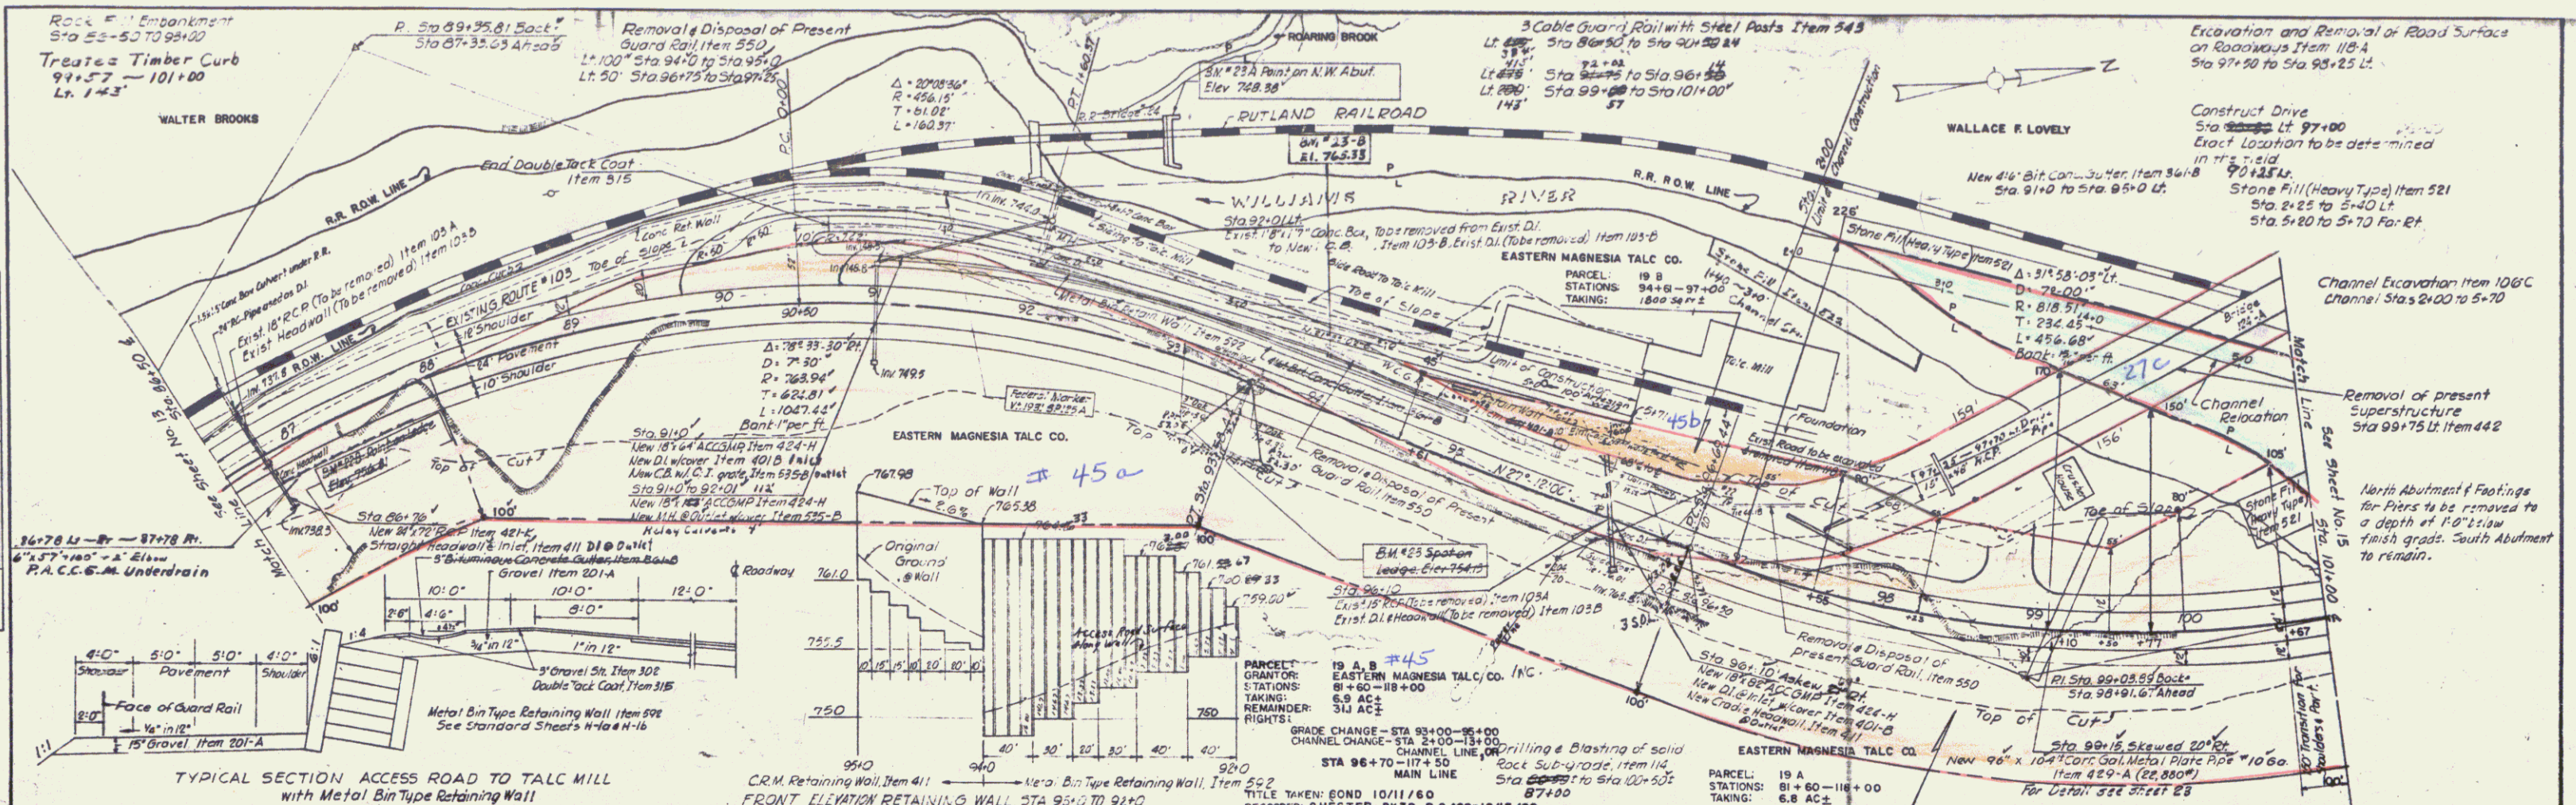

TYPICAL SECTION ACCESS ROAD TO TALC MILL with Metal Bin Type Retaining Wall

FRONT ELEVATION RETAINING WALL STA 95+0 TO 92+0 See Standard Sheet H-14-104 D-2

DATE	
BY	
PROJECT	
SCALE	
REVISIONS	
NO.	
DESCRIPTION	
DATE	
BY	
PROJECT	
SCALE	
REVISIONS	
NO.	
DESCRIPTION	

