
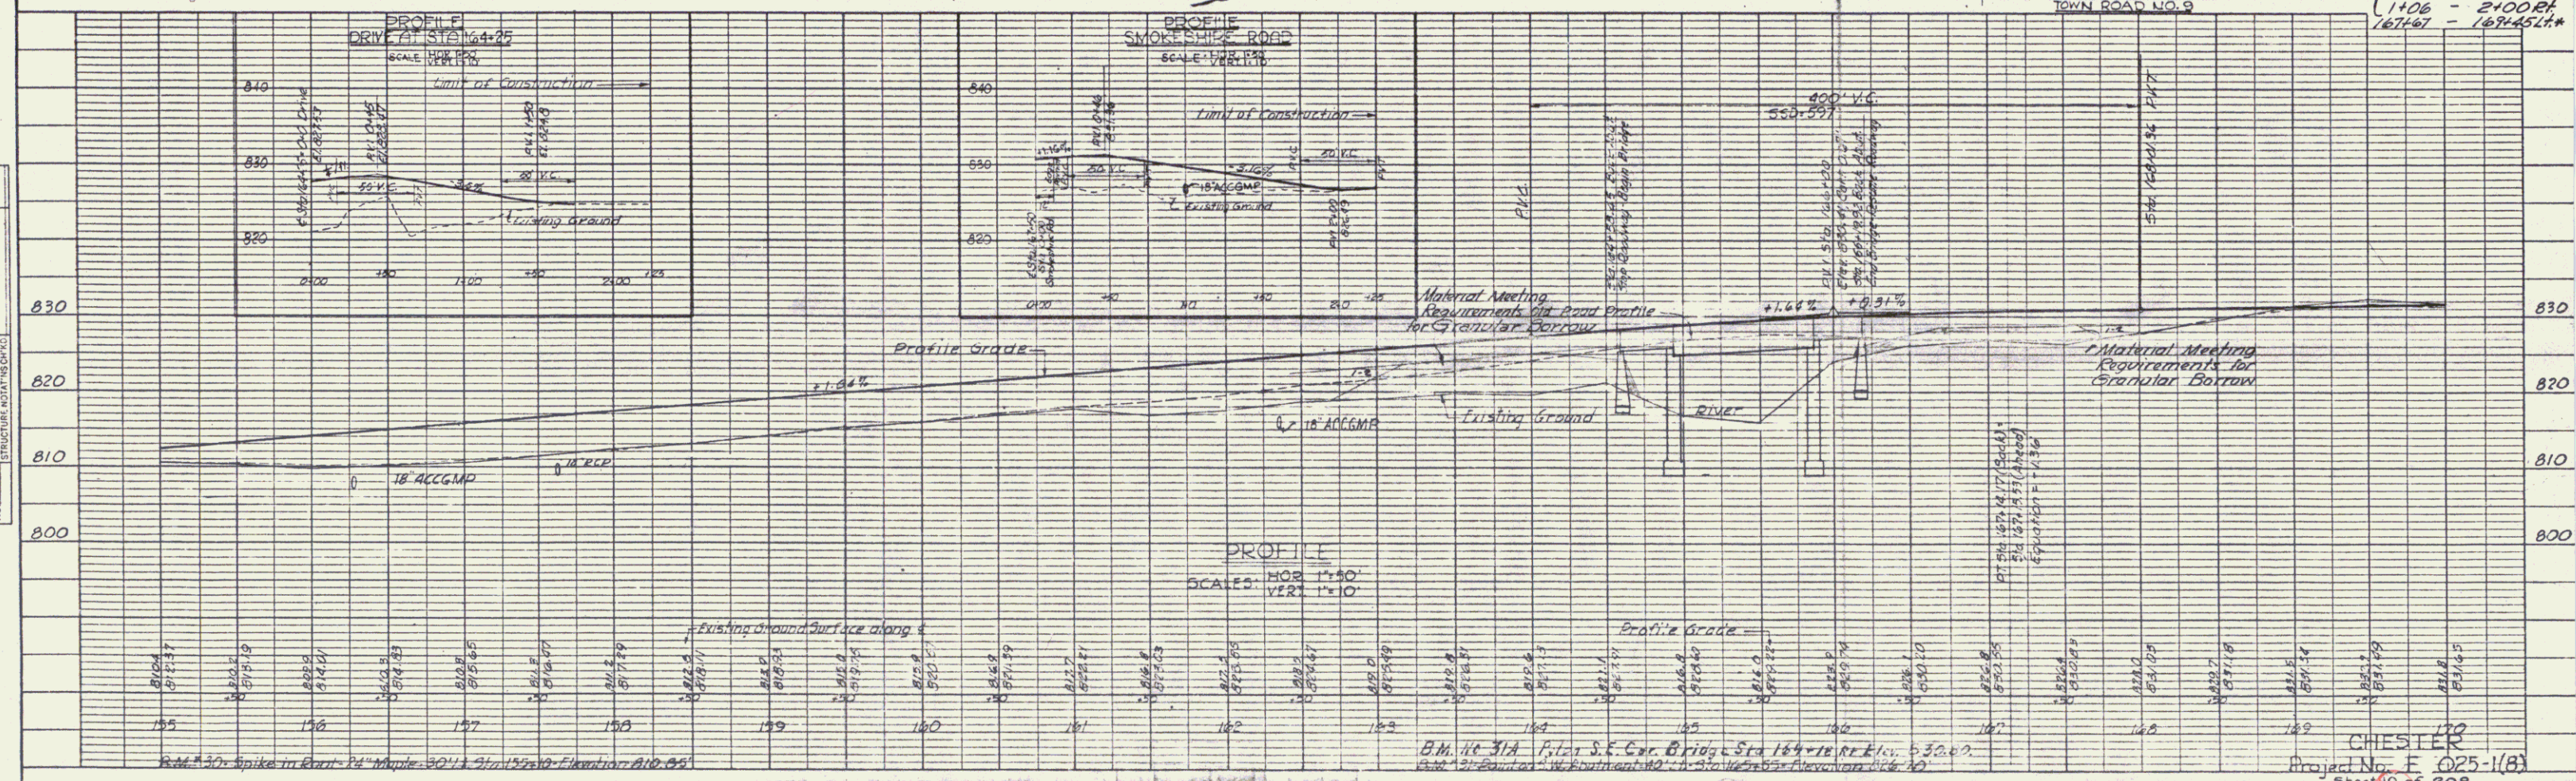


DATE	
BY	
APPROVED	
ALTERNATE CHECKED	
NOTE BOOK	
NO.	

DATE	
BY	
APPROVED	
ALTERNATE CHECKED	
NOTE BOOK	
NO.	

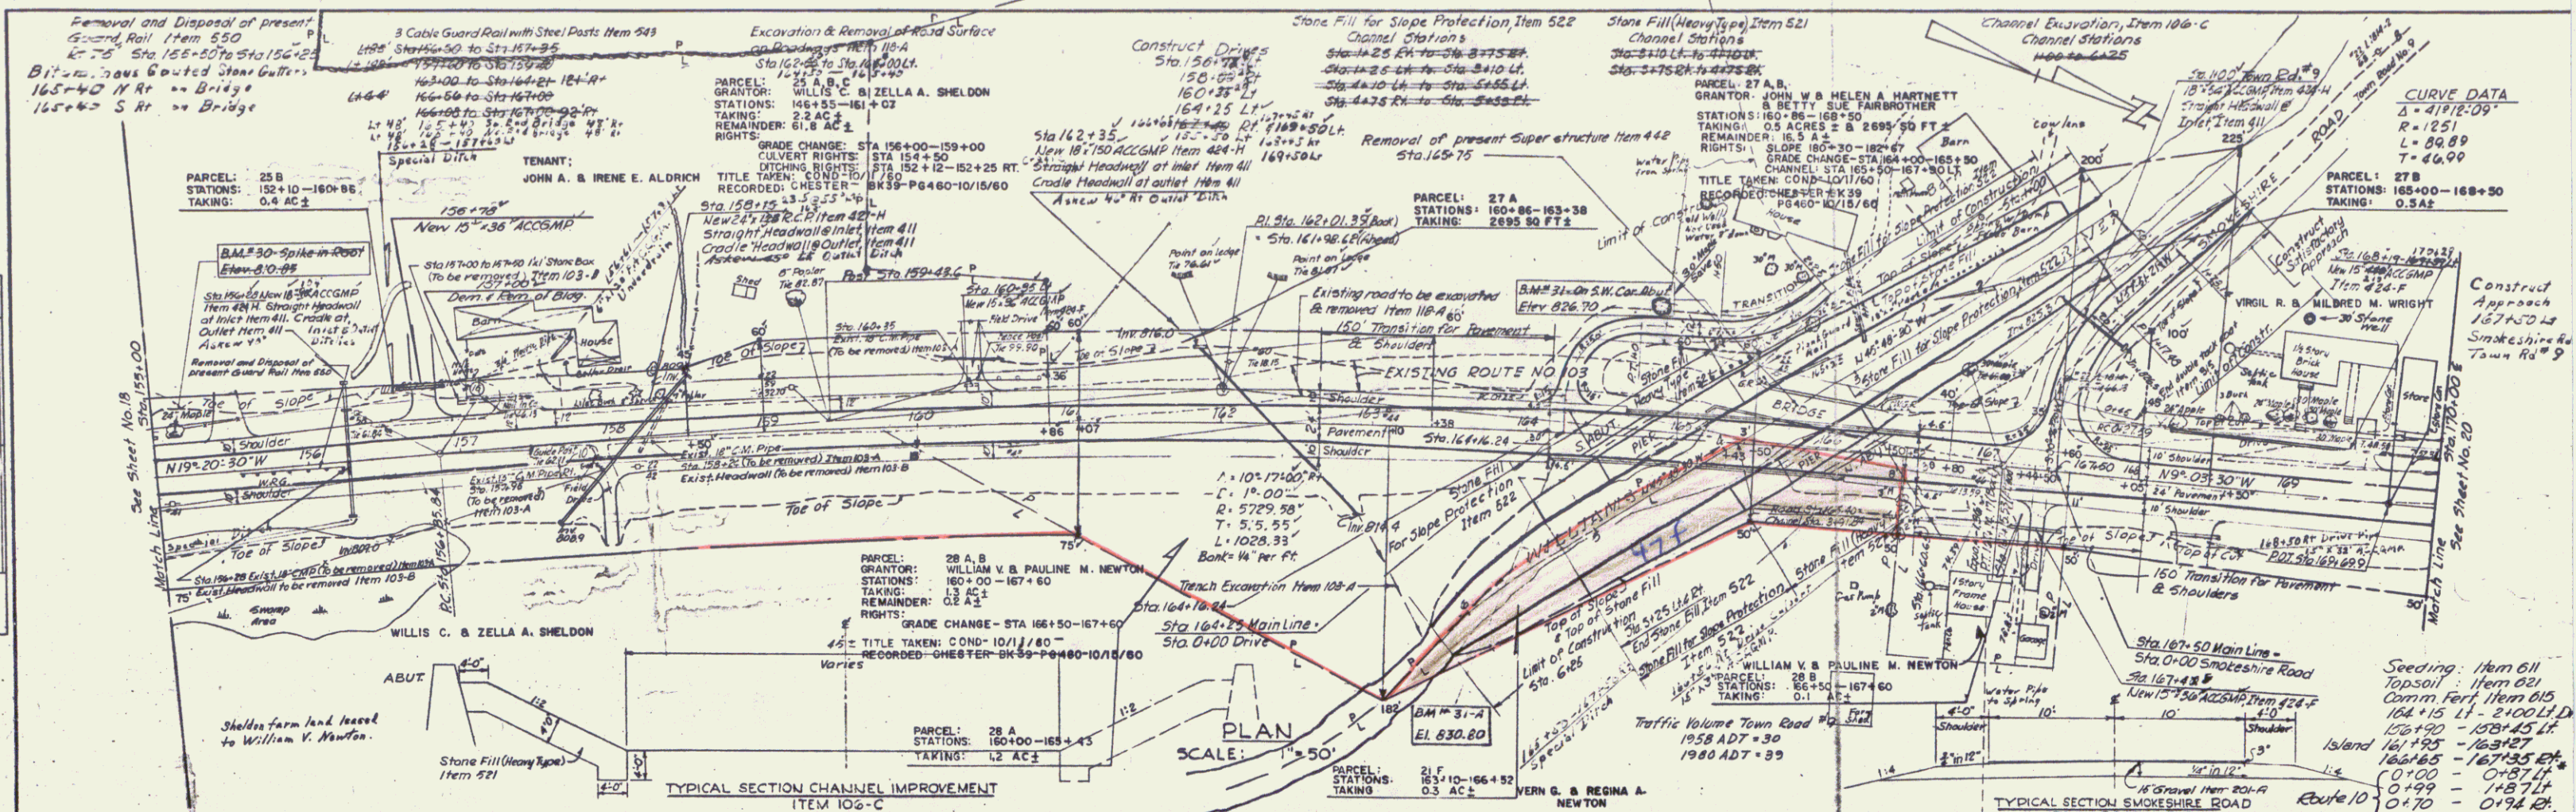

CHESIER
Project No. F 025-1(B)
Sheet 19 of 208