

GUARD RAIL REQUIRED

ON LEFT		
Sta. 1120 to Sta 1116 Length	296 Ft.	
711 - 7199	88	
ON RIGHT		
1120 to Sta. 1144	24	
7143 - 7199	56	
Total This Sheet		464 Ft.


NEW CULVERTS REQUIRED

Sta. 1132	18" Corr. I. Pipe	36 Ft.
	1-2 1/2'-5' Concrete	15 Cu Yds.


FED. ROAD DIST. NO.	STATE	FED. AID PROJ. NO.	FISCAL YEAR	SHEET NO.	TOTAL SHEETS
5	VT	54-A	1964	3	14

PLAN
DATE: 10/15/64
BY: [Signature]
CHECKED: [Signature]

C.S. [Signature]
G.S. [Signature]
D.R. [Signature]

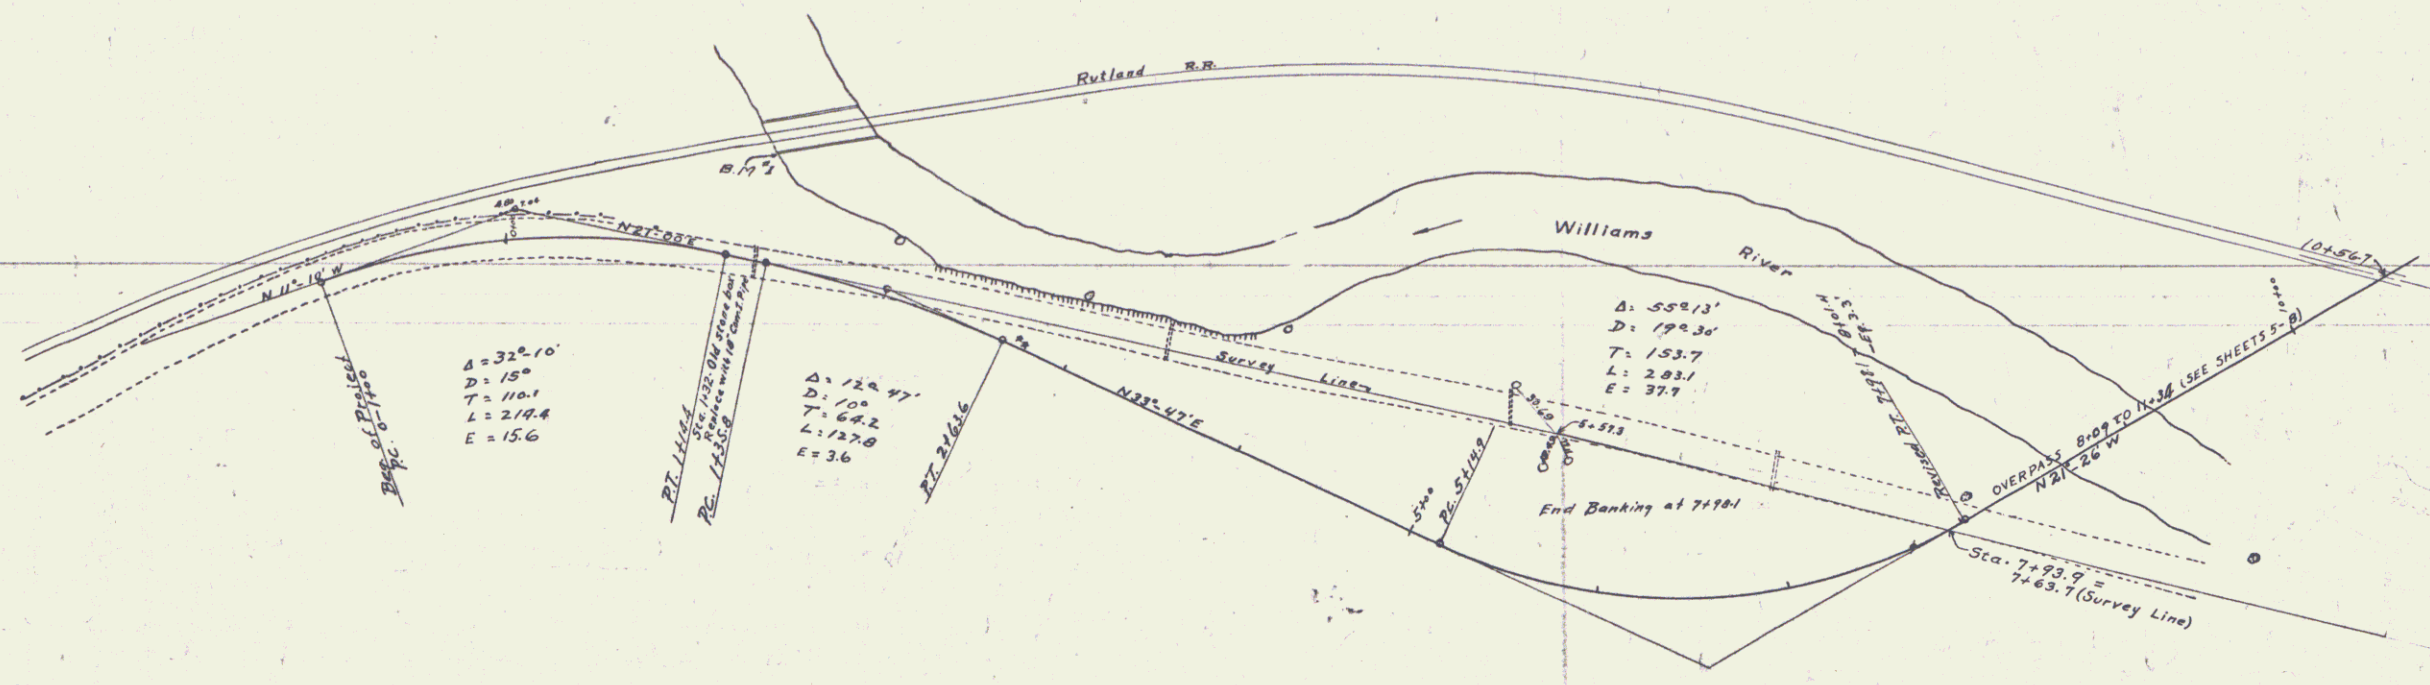

Note: If during construction nature of excavated material is found unlike that assumed in making these Plans, alignment and grade may be changed if so ordered by the Engineer in order to obtain proper balance of quantities.

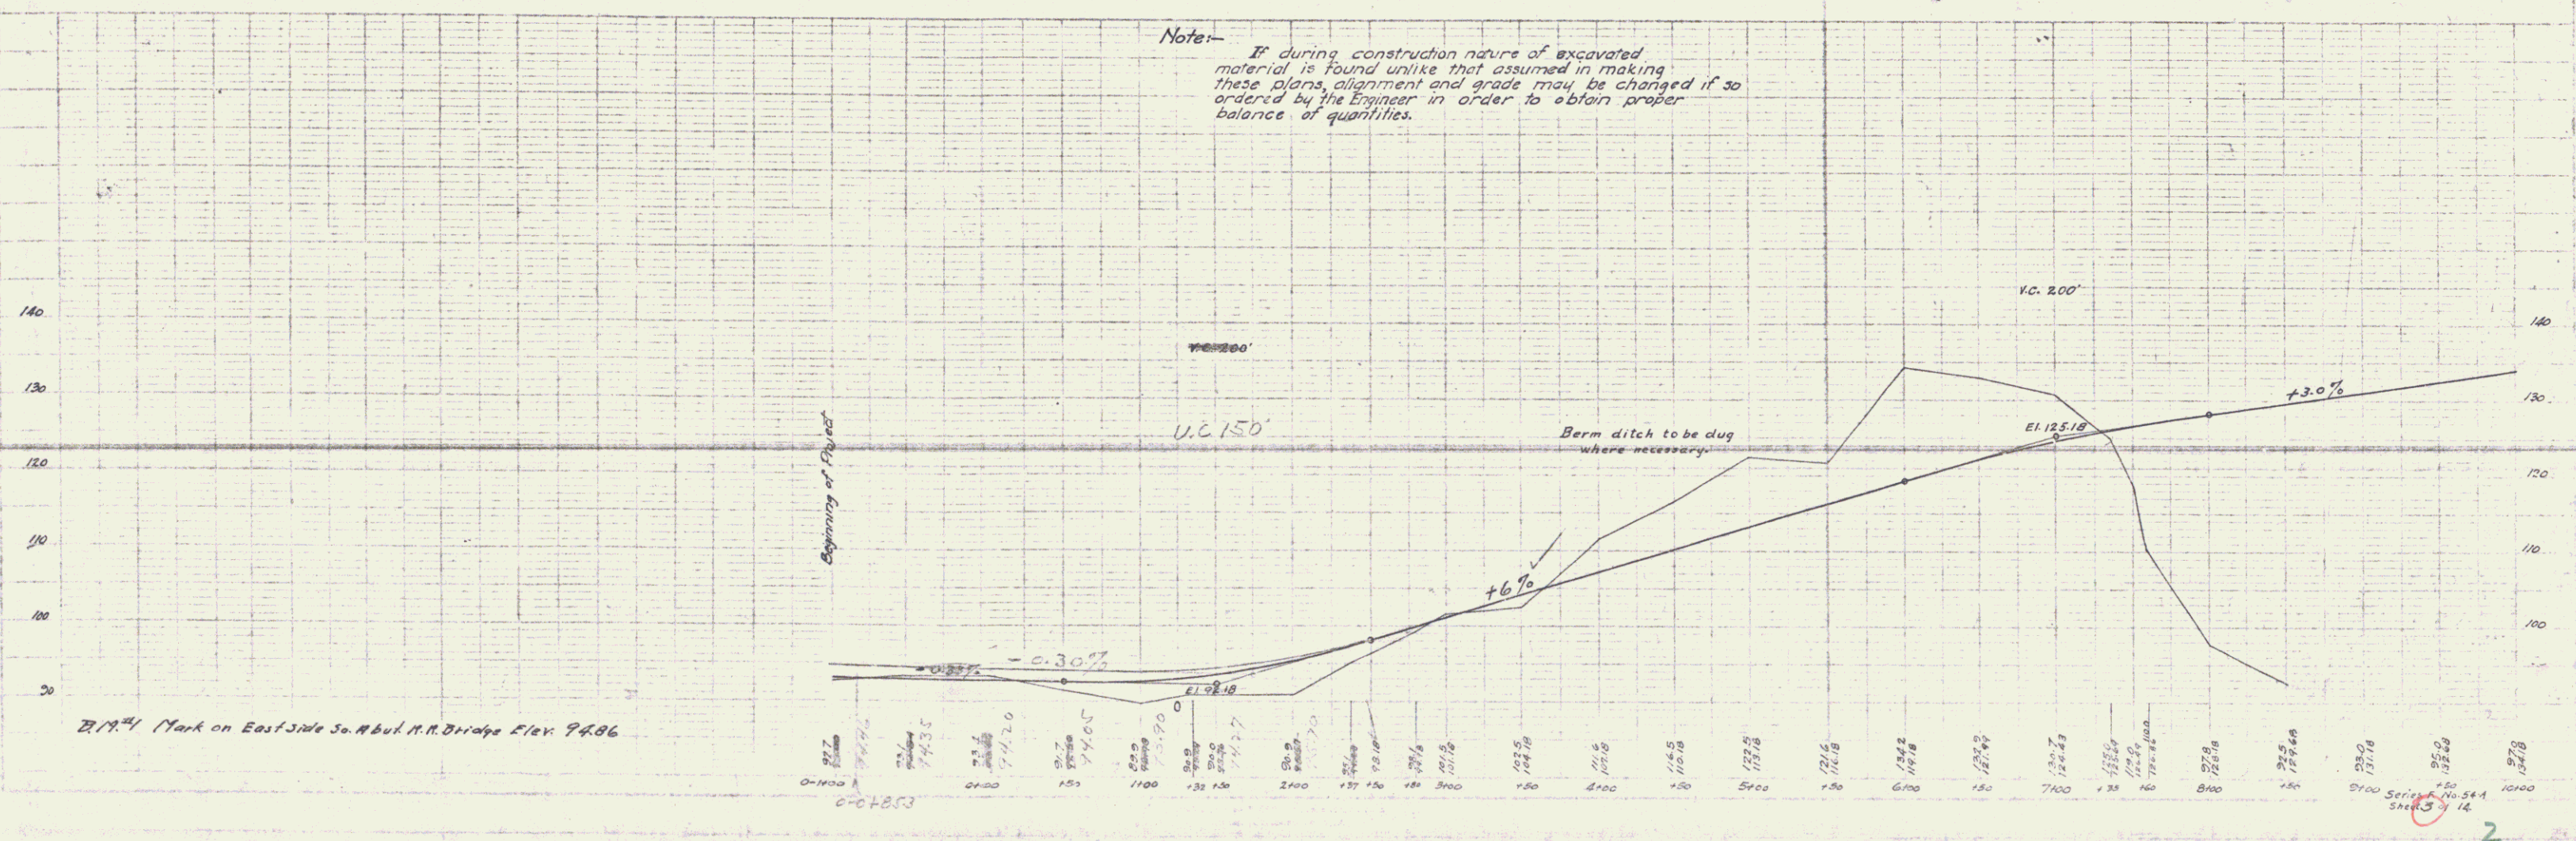

BM Mark on East Side So. Abut. R.R. Bridge Elev. 94.86