


Parcel	Lustr	Date	Grantor	Grantee	Recorded	Book	Page	Date	Remarks
#7	Con.	2-13-53	Don Ward & Alfred Prouty	St. of Vt.	CAVENDISH	30	43-47	2-14-53	
#8	W.D.	4-27-53	Carl E. & Alice L. Russell	"	"	30	71	5-7-53	
#9	W.D.	5-4-53	John E. Pitts	"	"	30	89	5-9-53	
#10	W.D.	4-12-53	John J. & Ruth Davy	"	"	30	98	5-9-53	
#11	W.D.	5-4-53	William A. Richardson	"	"	30	92	5-9-53	
#12	W.D.	4-25-53	Charles M. Moot	"	"	30	100	5-9-53	

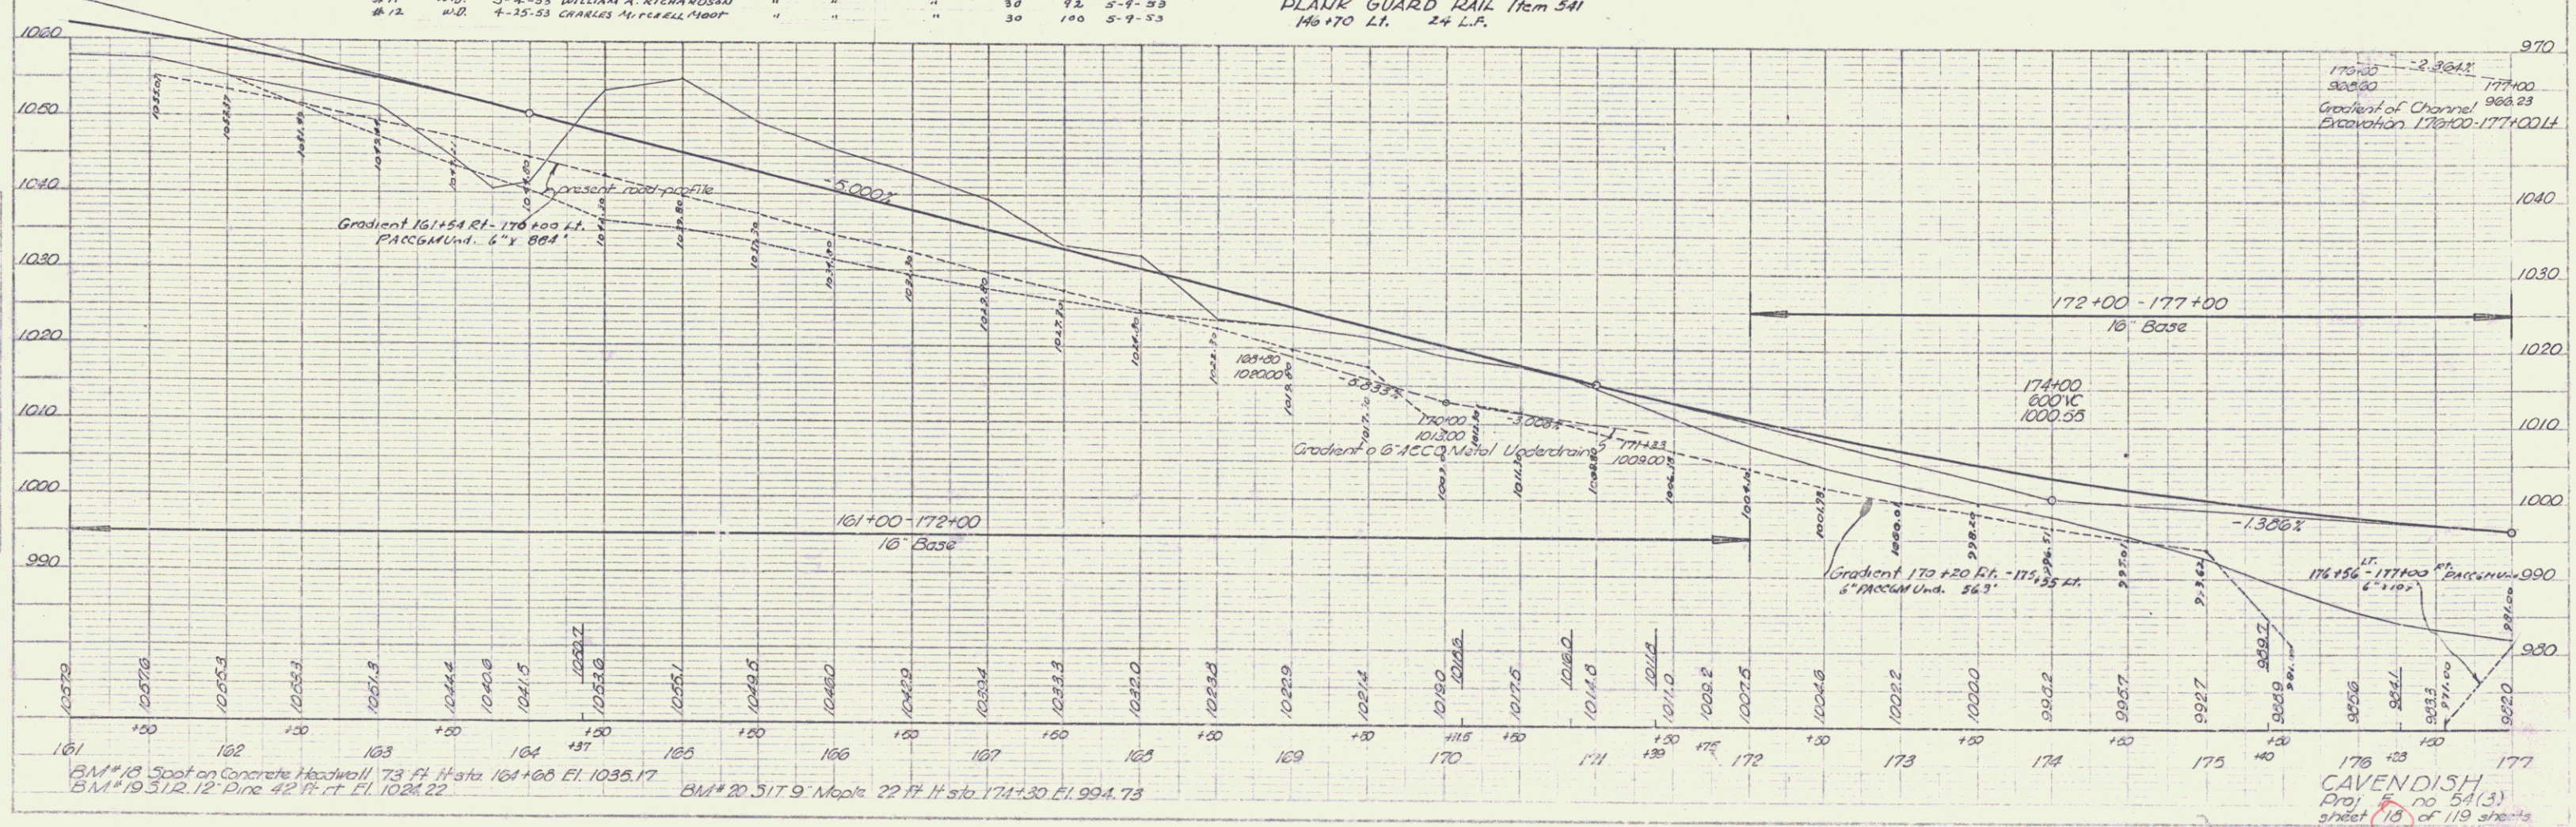

PLW
 2 1/2"
 6 1/2"
 1/4" = 100'

PLW
 1/4" = 100'

CAVENDISH
 Proj. no 54(3)
 sheet 18 of 119 sheets