

INDEX OF SHEETS

SHEET NO.	1	TITLE SHEET	34	BLACK RIVER BRIDGE - ABUT. NO. 1 & NO. 2 DETAILS
2	TYPICAL CROSS-SECTIONS OF IMPROVEMENT	35	BLACK RIVER BRIDGE - REINFORCING STEEL SCHEDULE	
3	TYPICAL CROSS-SECTIONS OF APPROACHES	36	STANDARD SHEET SB-45 - SQUARE - 57, APPROACH SLABS FOR SQUARE BRIDGES	
4	QUANTITY SHEET (ITEMS)	37	STANDARD SHEET SB-20-56, DETAILS FOR W.F. BEAMS	
5	ITEM DETAIL & DRAINAGE SHEET	38	STANDARD SHEET SB-30-56, SOFT COMPOSITE BEAM BRIDGES	
6	EARTHWORK SHEET	39	STANDARD SHEET SB-42-56, SOFT COMPOSITE BEAM BRIDGES	
7	EARTHWORK SUMMARY	40	STANDARD SHEET SB-56-57 (1 OF 2) BRIDGE RAILING & GRANITE CURB	
8	EARTHWORK SUMMARY	41	CANAL BRIDGE - PRELIMINARY INFORMATION SHEET	
9 - 15	PLAN & PROFILE	42	CANAL BRIDGE - PLAN LAYOUT	
16	BOX CULVERT EXTENSION	43	CANAL BRIDGE - PROFILE SHEET	
17	BOX CULVERT REINFORCING STEEL SCHEDULE	44	CANAL BRIDGE - SUPERSTRUCTURE, ELEV. & FRAMING	
18	STANDARD SB-21-56 BOX CULVERTS	45	CANAL BRIDGE - SUPERSTRUCTURE, DECK DETAILS	
19	A-61 DRILLING AND BLASTING	46	CANAL BRIDGE - ABUTMENT DETAILS	
20	B-1 BANKING TABLES	47	CANAL BRIDGE - APPROACH SLABS	
21	B-5 TYPICAL SLOPE GRADING	48	CANAL BRIDGE - REINFORCING STEEL SCHEDULE	
22	B-6 MUCK EXCAVATION	49 - 84	ROAD SECTIONS	
23	B-10 EMBANKMENT ON SLOPE	85 - 84	CHANNEL SECTIONS	
24	B-16 ISLAND DESIGNS	94 - A	PROTECTION OF RAILROAD SIGNS	
25	C-1 CURBS			
26	D-2 C.R.M.			
27	D-4 METAL END SECTIONS, FLUSHING BASINS			
27A	D-8 R.C. D.I. AND P.C. COVER - D.I. BOTTOMS			
27B	D-10 TOPS FOR D.I. W/GRANITE SLOPE EDGING			
27C	D-11 DETAILS OF GRATES FOR D.I.			
27D	E-1 BARRICADES, SIGN AND LIGHTS (ROADWAY)			
27E	G-3 THREE CABLE GUARD RAIL			
27F	G-4 STEEL MARKER POSTS			
27G	J-1 PROJECT AND BOUNDARY MARKERS			
28	BLACK RIVER BRIDGE - PRELIMINARY INFORMATION SHEET			
29	BLACK RIVER BRIDGE - PLAN LAYOUT			
30	BLACK RIVER BRIDGE - PROFILE SHEET			
31	BLACK RIVER BRIDGE - PLAN OF CHANNEL IMPROVEMENT			
32	BLACK RIVER BRIDGE - SUPERSTRUCTURE DETAILS			
33	BLACK RIVER BRIDGE - PIER NO. 1 & NO. 2 DETAILS			

STATE OF VERMONT  
DEPARTMENT OF HIGHWAYS

PROPOSED IMPROVEMENT


FEDERAL AID PROJECT

TOWN OF CAVENDISH  
COUNTY OF WINDSOR  
VT. ROUTE 103  
CAVENDISH-PROCTORSVILLE BYPASS

PROJECT: CAVENDISH F-025-1(10)  
BEGINNING AT A POINT 0.643 MILES ALONG VT. ROUTE 103 SOUTHERLY OF THE  
INTERSECTION OF VT. ROUTES 103 & 131 AND EXTENDING NORTHWESTERLY 5,225.91 FEET,  
EXCLUDING RAILROAD CROSSING  
LENGTH OF PROJECT 5,225.91 FEET = 0.990 MILE  
LENGTH OF ROADWAY 5,009.37 + 0.195 MILE - LENGTH OF BRIDGES 216.54 + 0.041 MILES


DESIGN DESIGNATION

ADT (1958) 1800 - 2800
ADT (1980) 2800 - 4500
DHV (1960) 400 - 820
D 91% - 95%
T 8%
V 50 MPH

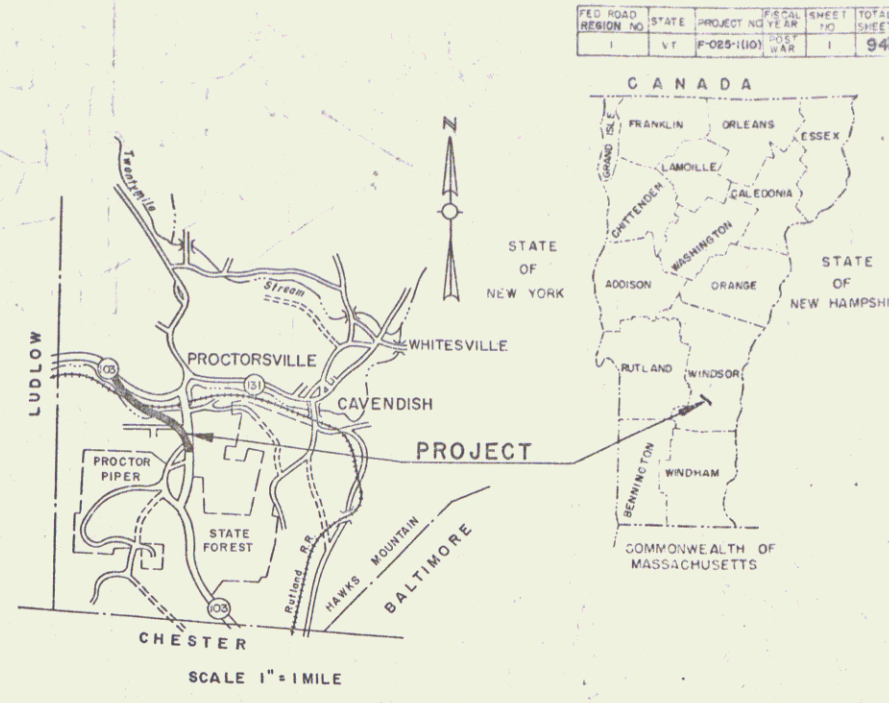

RIGHT-OF-WAY DIVISION  
TOWN FILE

PERPETUAL  
Town of Ut 103  
(To Be Returned To R.O.W. Division)

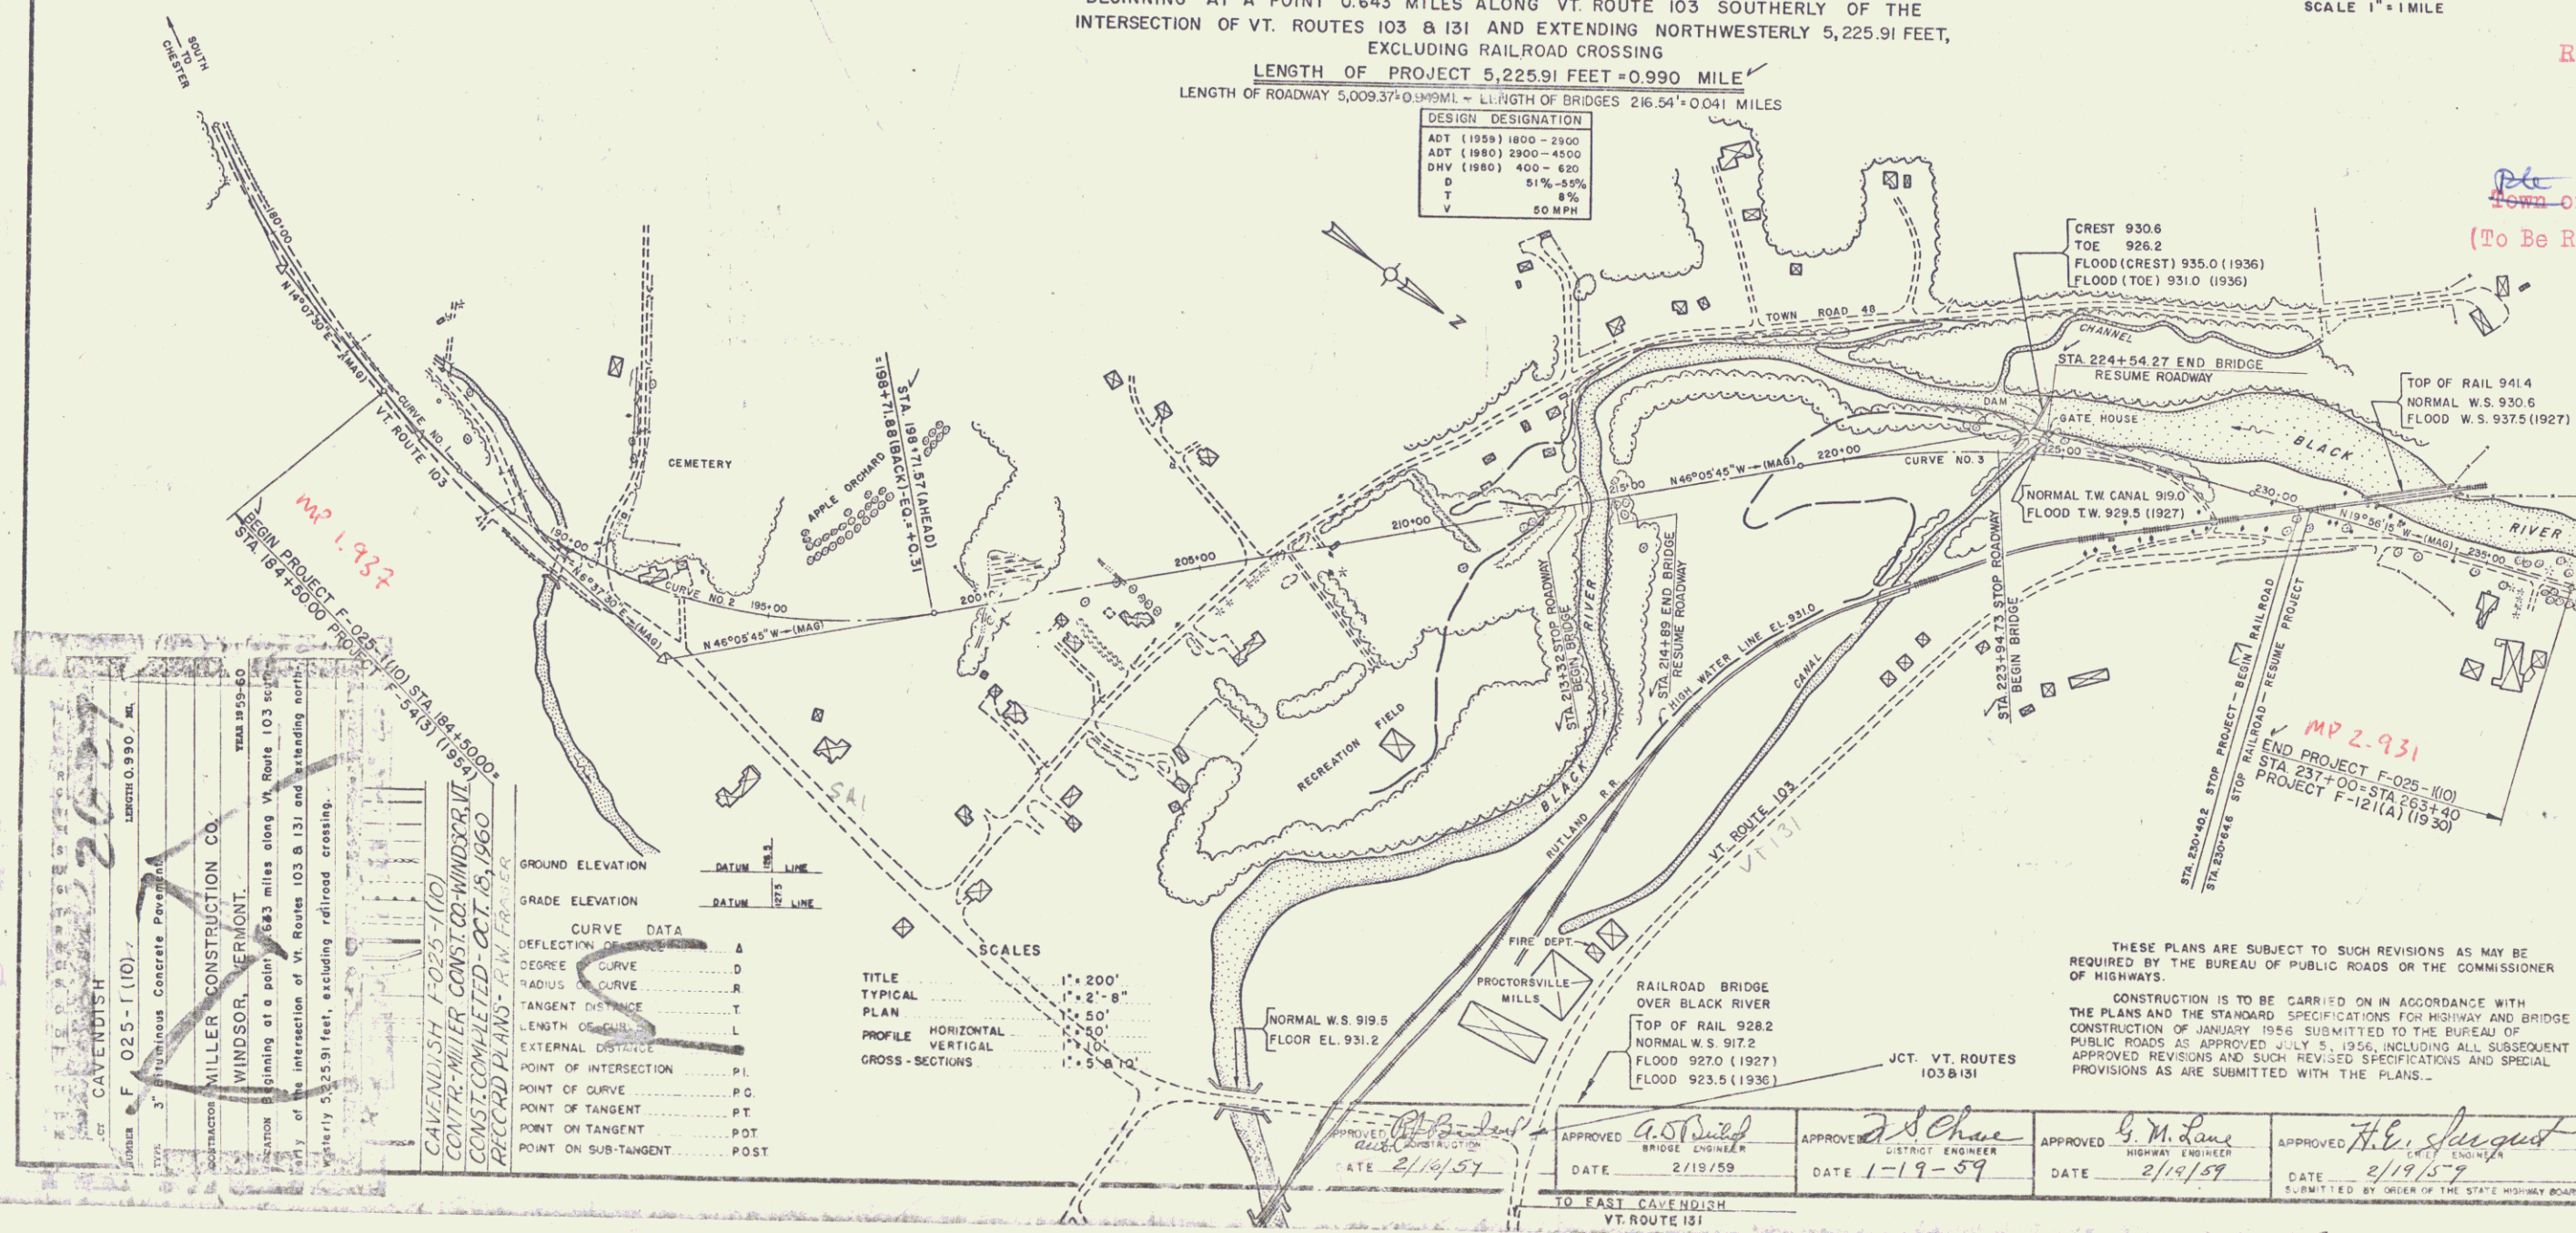

CAVENDISH F-025-1(10)  
MILLER CONSTRUCTION CO.  
WINDSOR, VERMONT.  
CONSTRUCTION OF  
CAVENDISH F-025-1(10)  
CENTRE-MILLER CONST. CO. WINDSOR, VT.  
CONSTRUCTION COMPLETED - OCT. 15, 1960  
PRELIMINARY PLANS - P.W. FRIEDER

GROUND ELEVATION DATUM P.B. LINE

GRADE ELEVATION DATUM P.B. LINE

CURVE DATA

DEFLECTION ANGLE	A
DEGREE	D
RADIUS	R
TANGENT DISTANCE	T
LENGTH OF CHORD	L
EXTERNAL DISTANCE	E
POINT OF INTERSECTION	P.I.
POINT OF CURVE	P.C.
POINT OF TANGENT	P.T.
POINT ON TANGENT	P.O.T.
POINT ON SUB-TANGENT	POST

SCALES

TITLE	1" = 200'
TYPICAL	1" = 2' - 8"
PLAN	1" = 50'
PROFILE HORIZONTAL	1" = 50'
PROFILE VERTICAL	1" = 10'
CROSS-SECTIONS	1" = 5' - 0"

THESE PLANS ARE SUBJECT TO SUCH REVISIONS AS MAY BE  
REQUIRED BY THE BUREAU OF PUBLIC ROADS OR THE COMMISSIONER  
OF HIGHWAYS.

CONSTRUCTION IS TO BE CARRIED ON IN ACCORDANCE WITH  
THE PLANS AND THE STANDARD SPECIFICATIONS FOR HIGHWAY AND BRIDGE  
CONSTRUCTION OF JANUARY 1956 SUBMITTED TO THE BUREAU OF  
PUBLIC ROADS AS APPROVED JULY 5, 1956, INCLUDING ALL SUBSEQUENT  
APPROVED REVISIONS AND SUCH REVISED SPECIFICATIONS AND SPECIAL  
PROVISIONS AS ARE SUBMITTED WITH THE PLANS.

APPROVED DATE 2/19/59	APPROVED DATE 1-19-59	APPROVED DATE 2/15/59	APPROVED DATE 2/19/59
--------------------------	--------------------------	--------------------------	--------------------------

DEPARTMENT OF COMMERCE  
BUREAU OF PUBLIC ROADS

APPROVED \_\_\_\_\_ DATE \_\_\_\_\_

DIVISION ENGINEER \_\_\_\_\_ DATE \_\_\_\_\_

PROJECT NO. 025-1(10)

SHEET 1 OF 94 SHEETS