



PLAN
 JEWETT
 FAYON & ACES
 1-59
 1-58
 SHEET NO. 14
 TOWN OF
 B.E. BOYD

JEWETT
 BOYD
 1-59
 1-58
 SHEET NO. 14
 TOWN OF
 B.E. BOYD

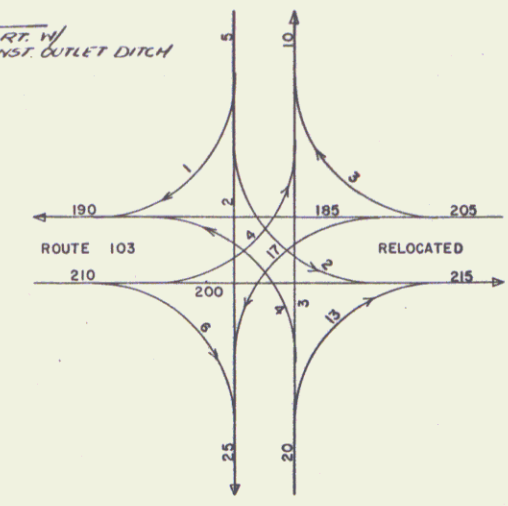

TURNING MOVEMENT DIAGRAM
 SHOWING 1980 30TH PEAK HOUR VOLUME

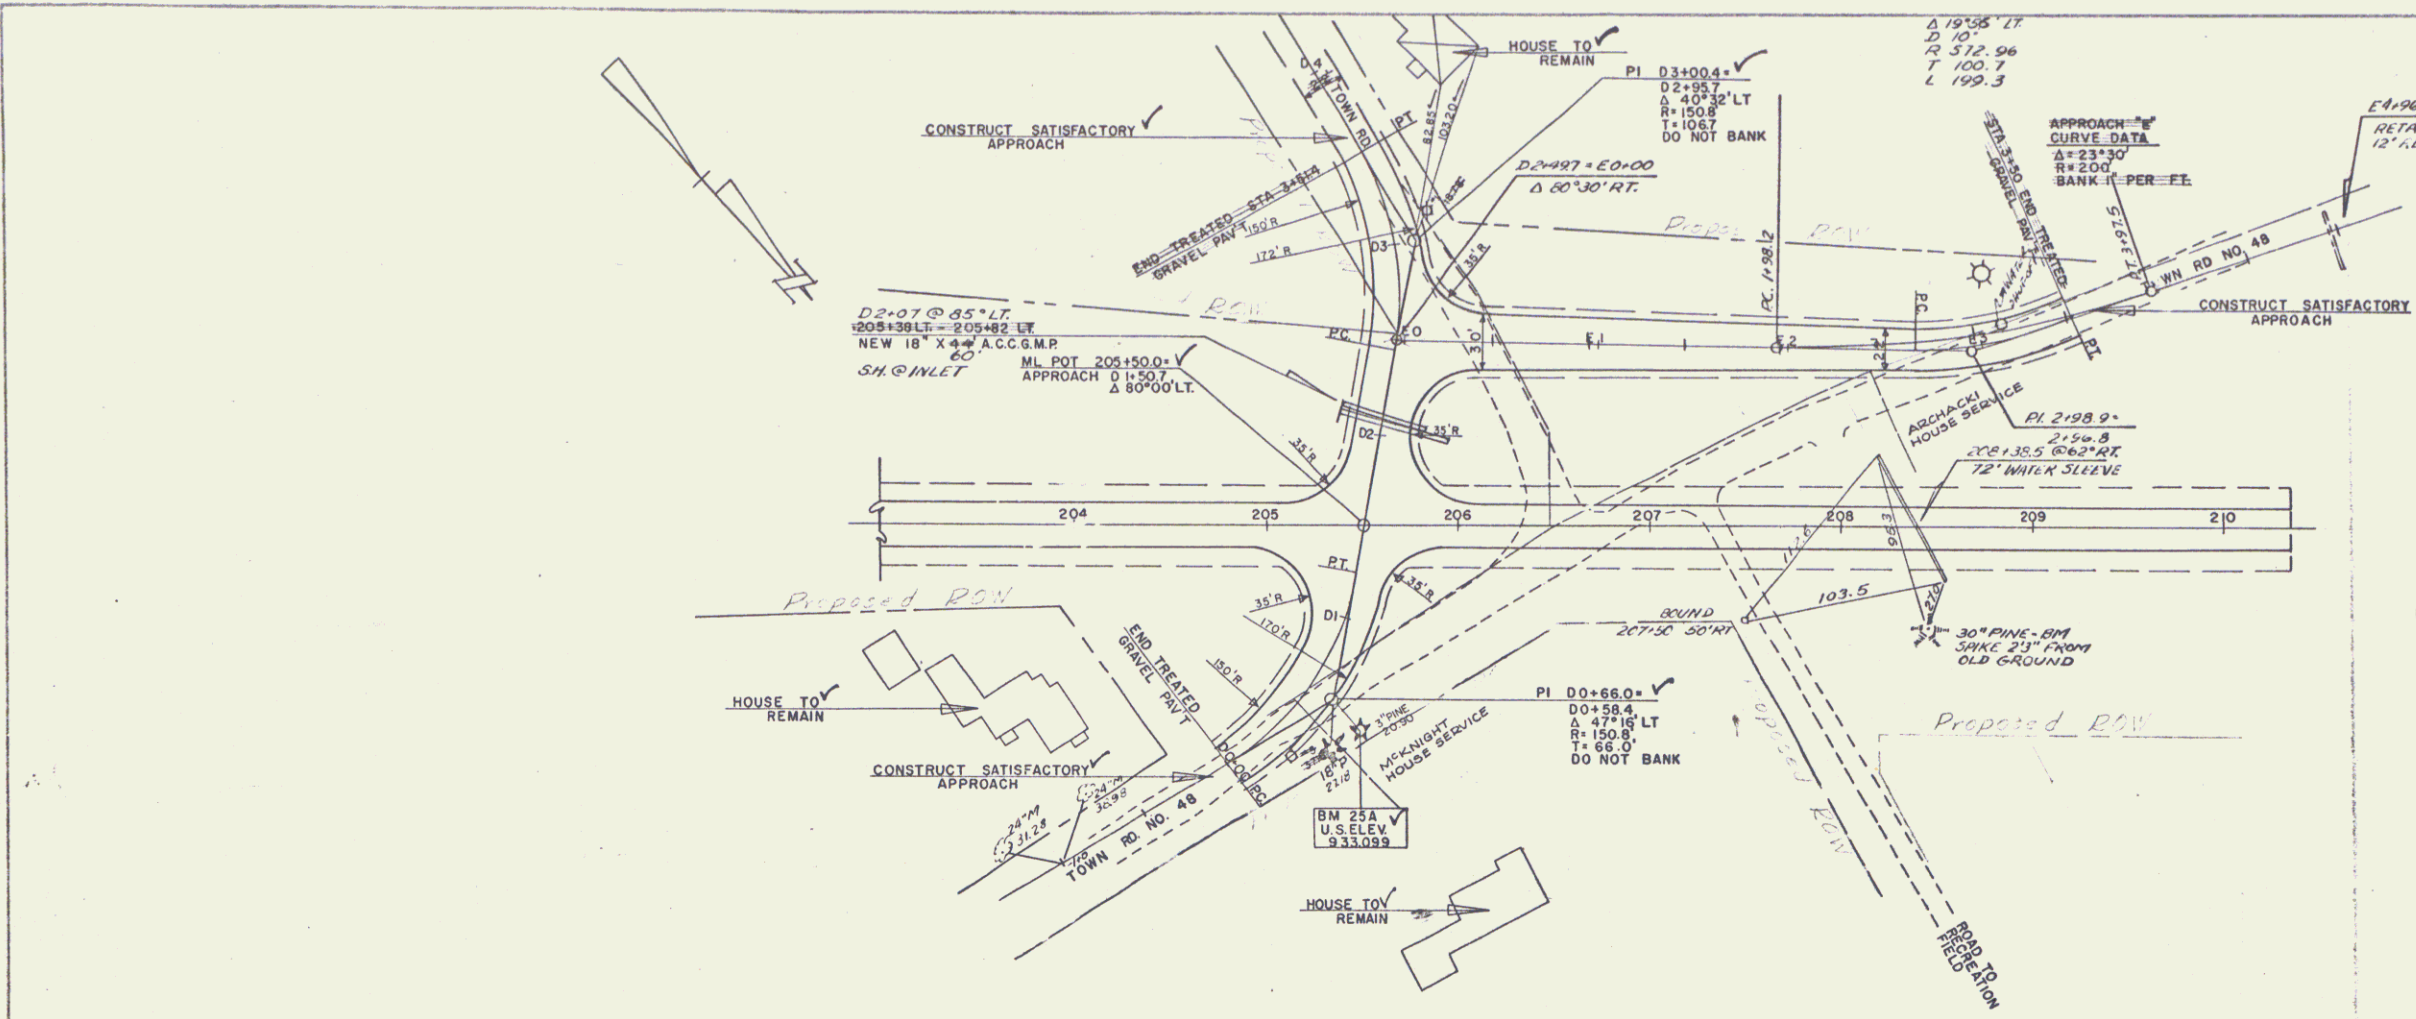