




VT HIGHWAYS DEPT.
 PERCY S. KETTER ASSOC.
 5-98

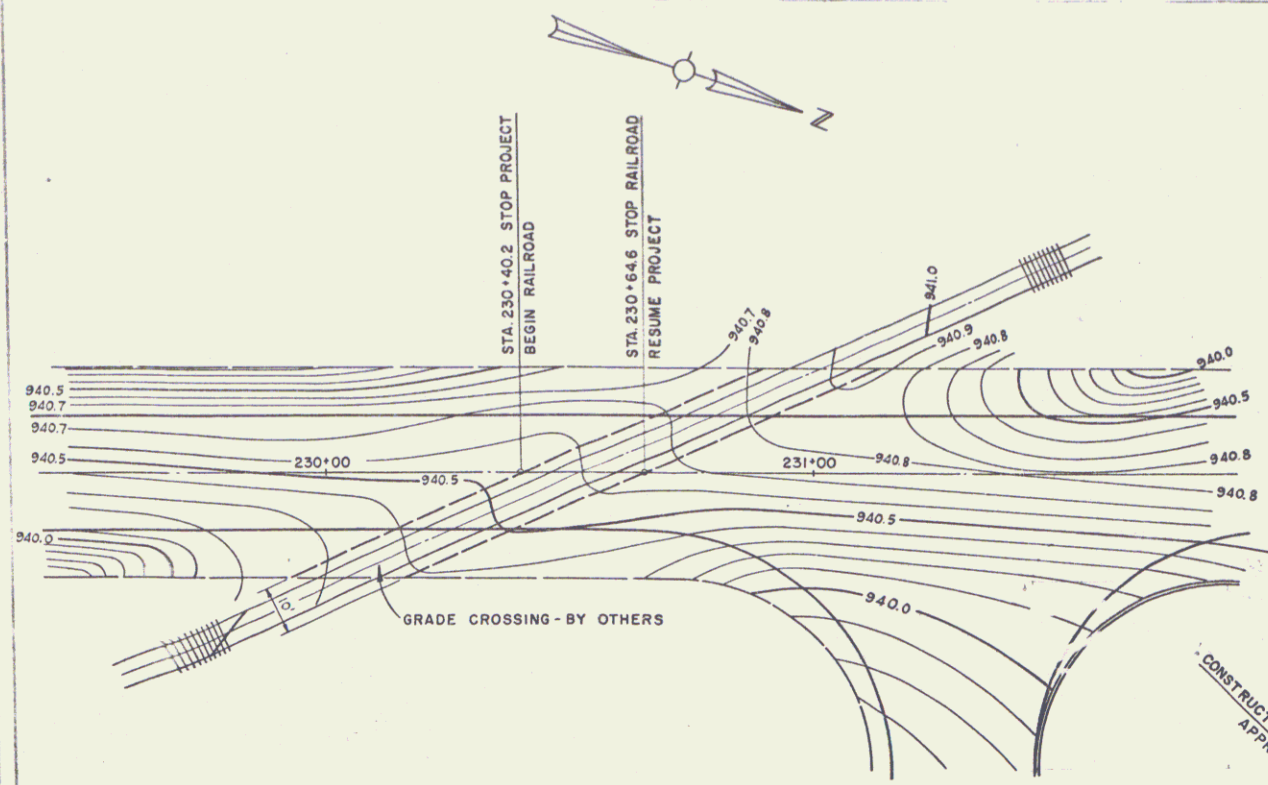

RAILROAD INTERSECTION GRADE PLAN
 SCALE 1"=20'

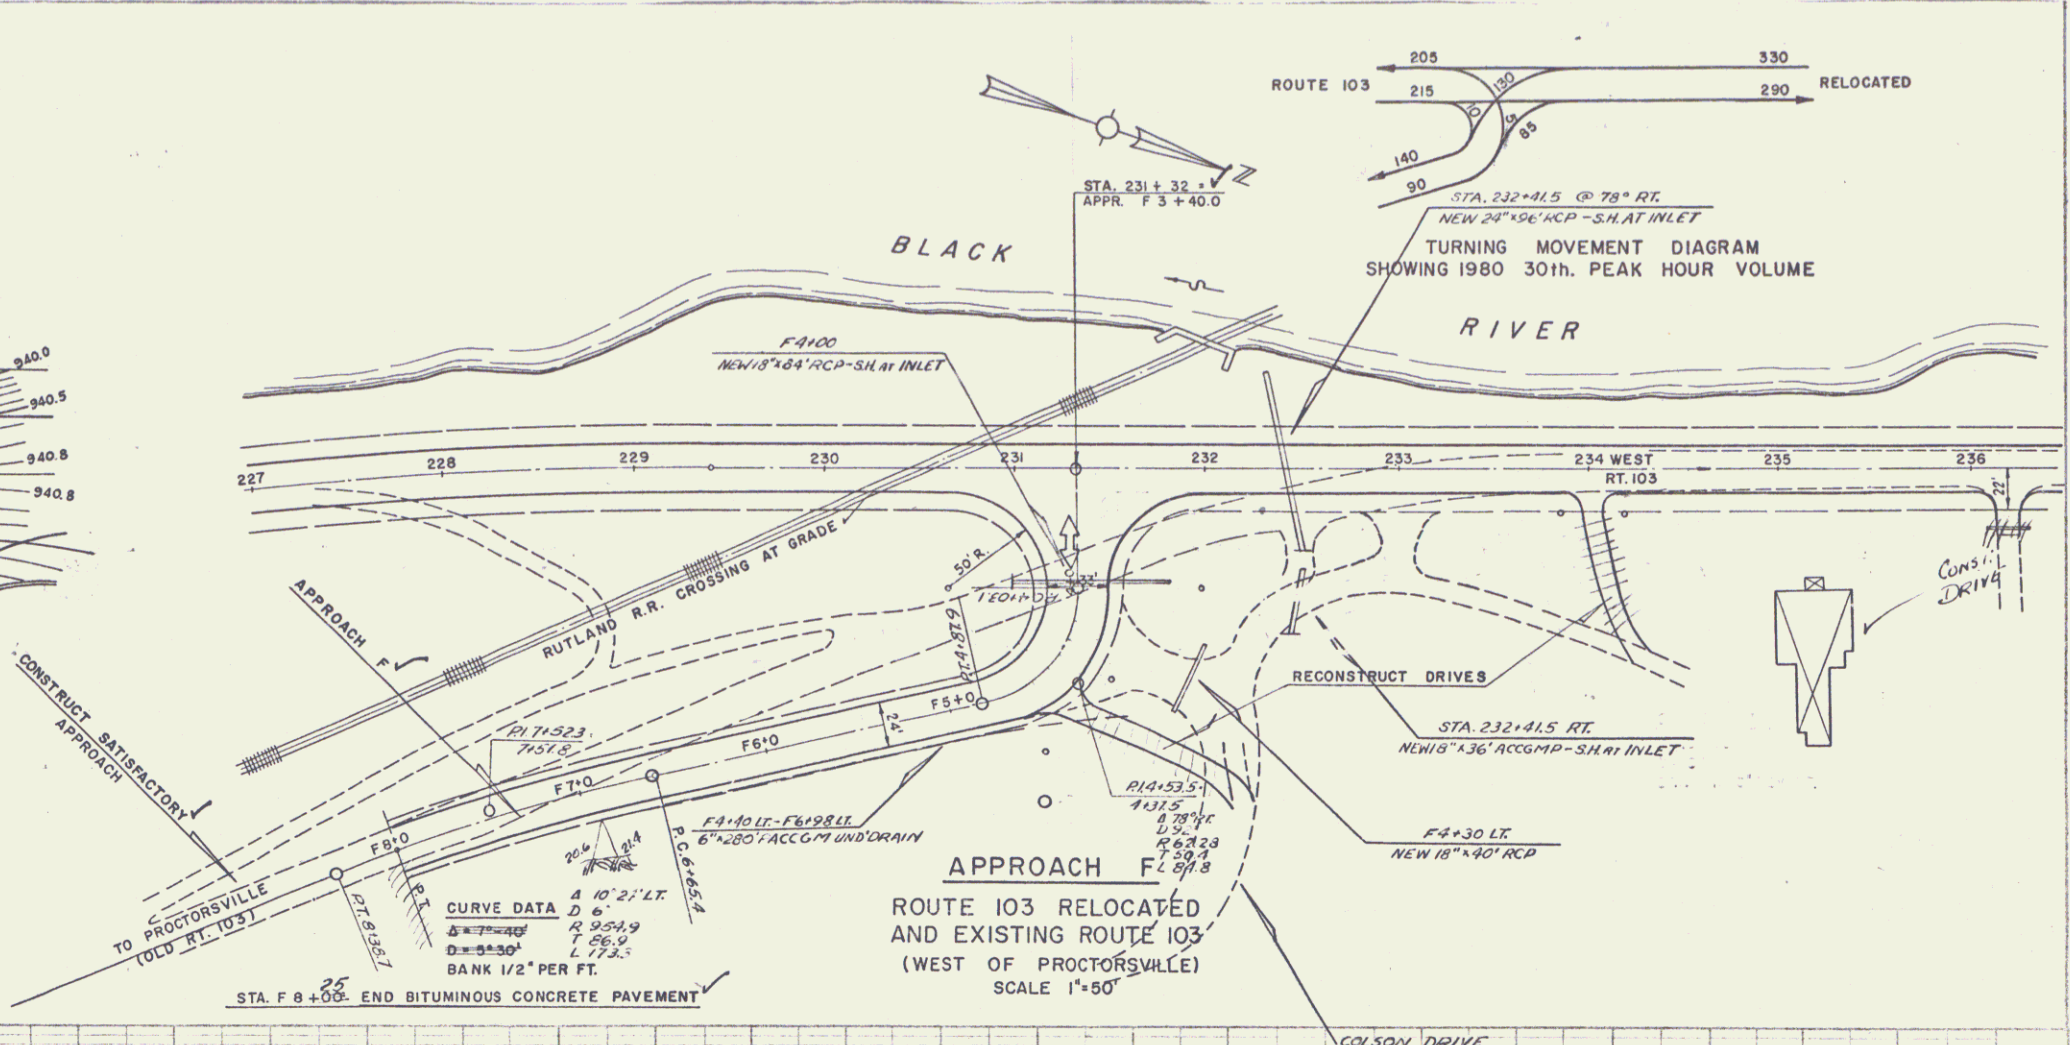

ROUTE 103 RELOCATED
 AND EXISTING ROUTE 103
 (WEST OF PROCTORSVILLE)
 SCALE 1"=50'

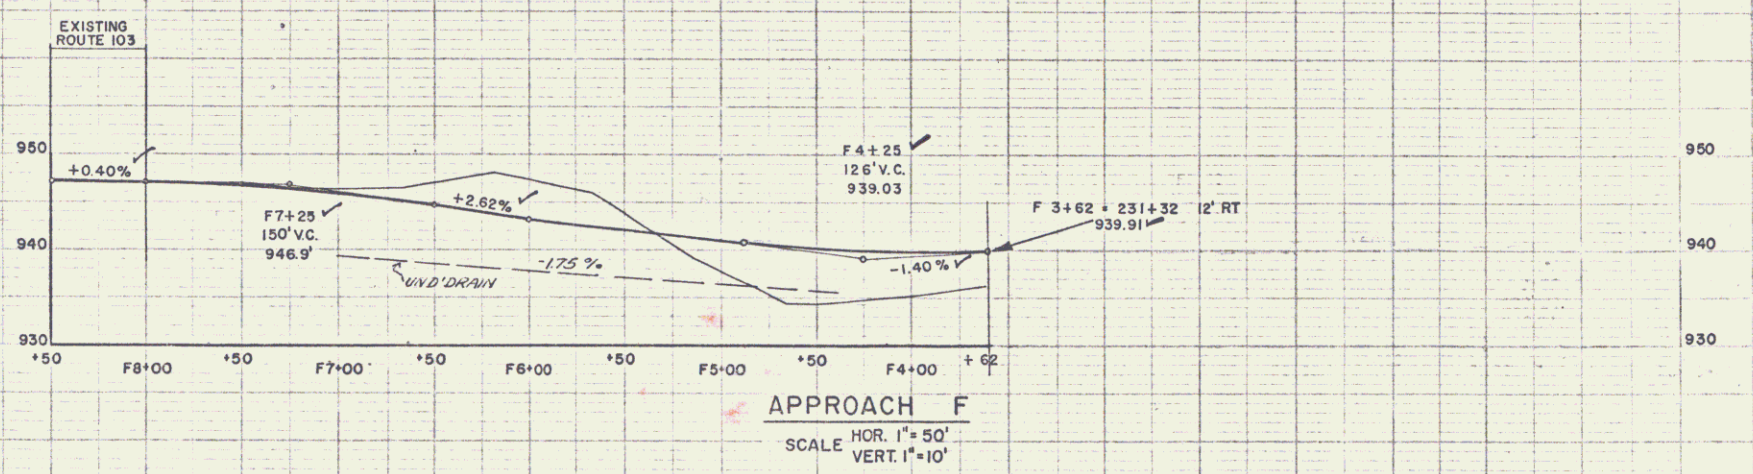

APPROACH F
 HOR. 1"=50'
 SCALE VERT. 1"=10'

VT HIGHWAYS DEPT.
 PERCY S. KETTER ASSOC.
 5-98