
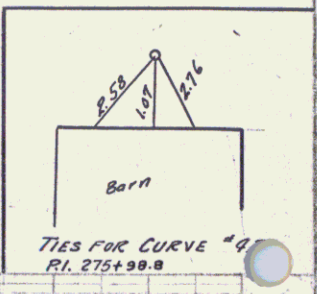
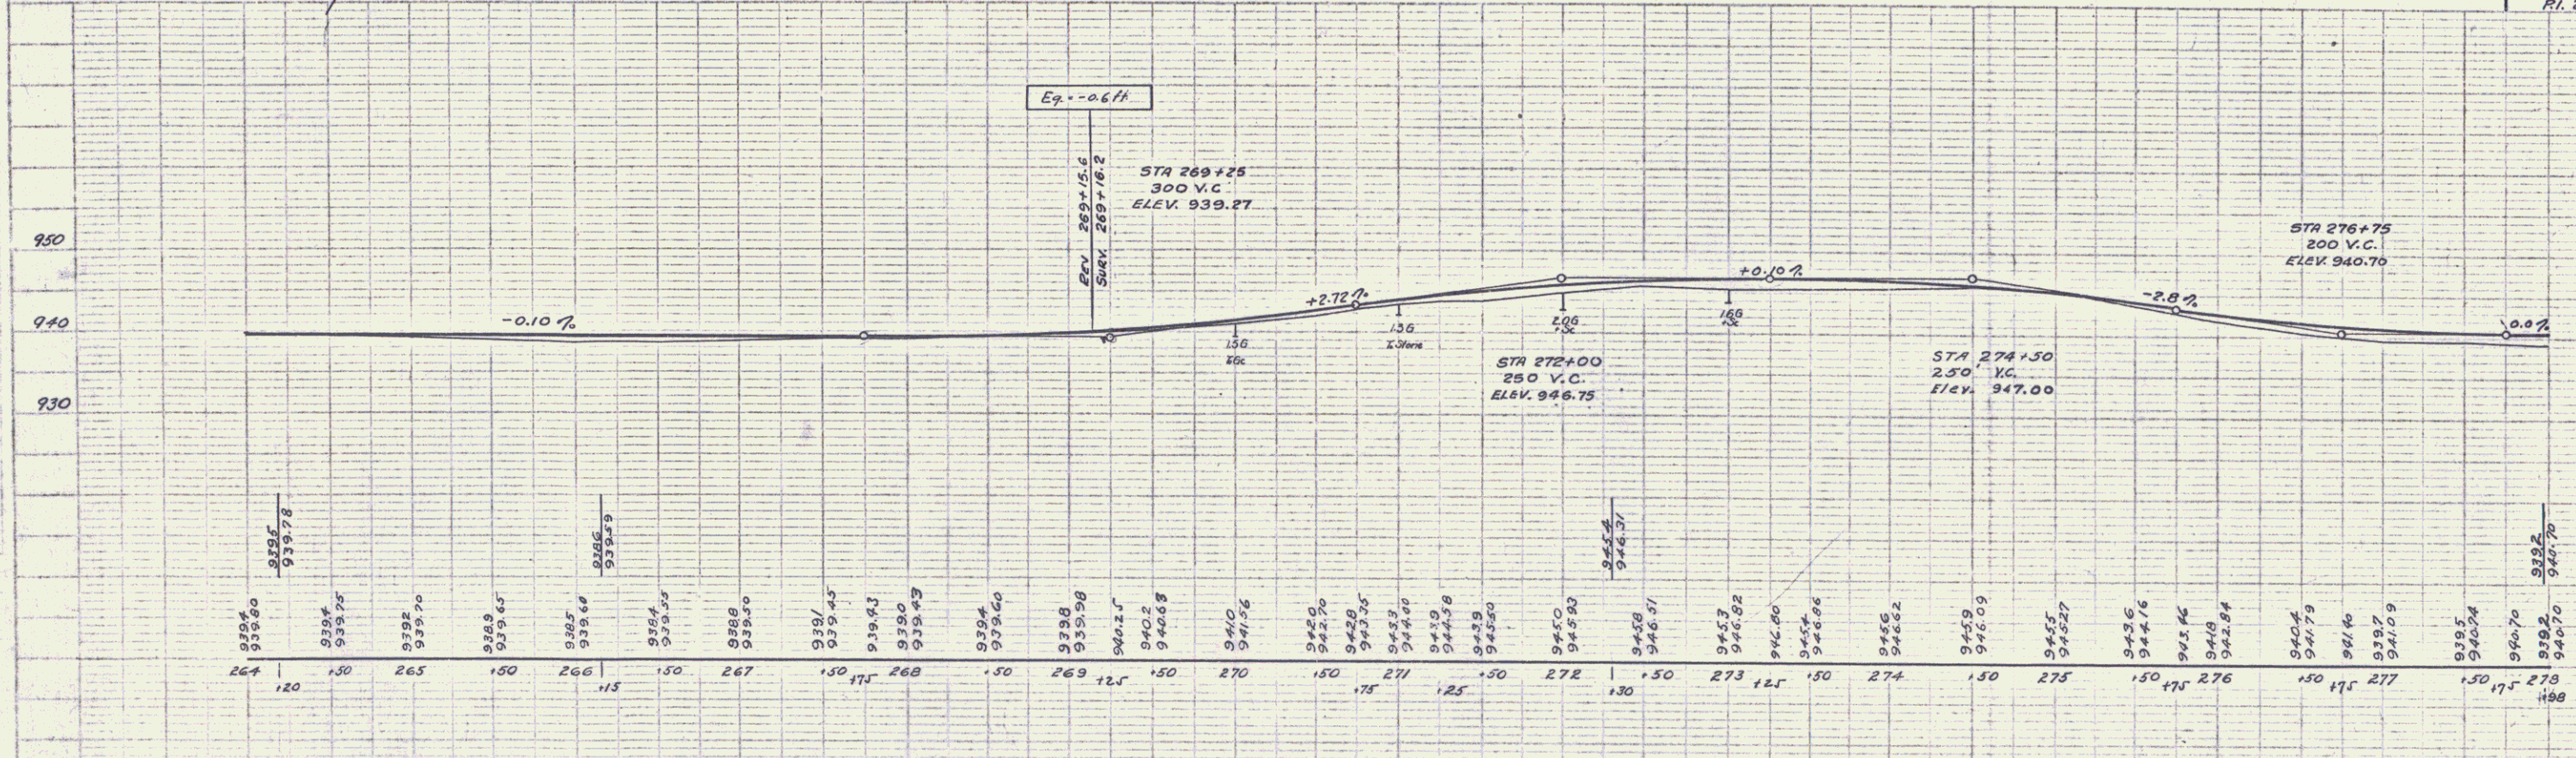


| WOOD GUARD RAIL REQUIRED | | | CABLE GUARD RAIL REQUIRED | | | WOOD GUIDE POSTS REQUIRED | | | NEW REIN CONC PIPE CULVERTS REQUIRED | | | | | | |
|--------------------------|------|-------|---------------------------|------|-------|---------------------------|------|-------|--------------------------------------|------|--------|-------|--------|------------|-------|
| CULV. STA | LEFT | RIGHT | STATIONS | LEFT | RIGHT | CULV. STA | LEFT | RIGHT | CULV. STA | DIAM | LENGTH | CONCR | COSE C | REIN STEEL | GRATE |
| 266+15 | - | 24' | 269+26-269+74 | - | 48' | 278+00 | 1 | - | 278+00 | 15" | 32' | 1.4% | 1.2% | 116.165 | 1 |

| | | | |
|-----------|-----------|--------------|----------|
| DATE | 11/10/20 | SCALE | 1" = 40' |
| PROJECT | NO. 121-R | YEAR | 2020 |
| SHEET NO. | 18 | TOTAL SHEETS | 57 |

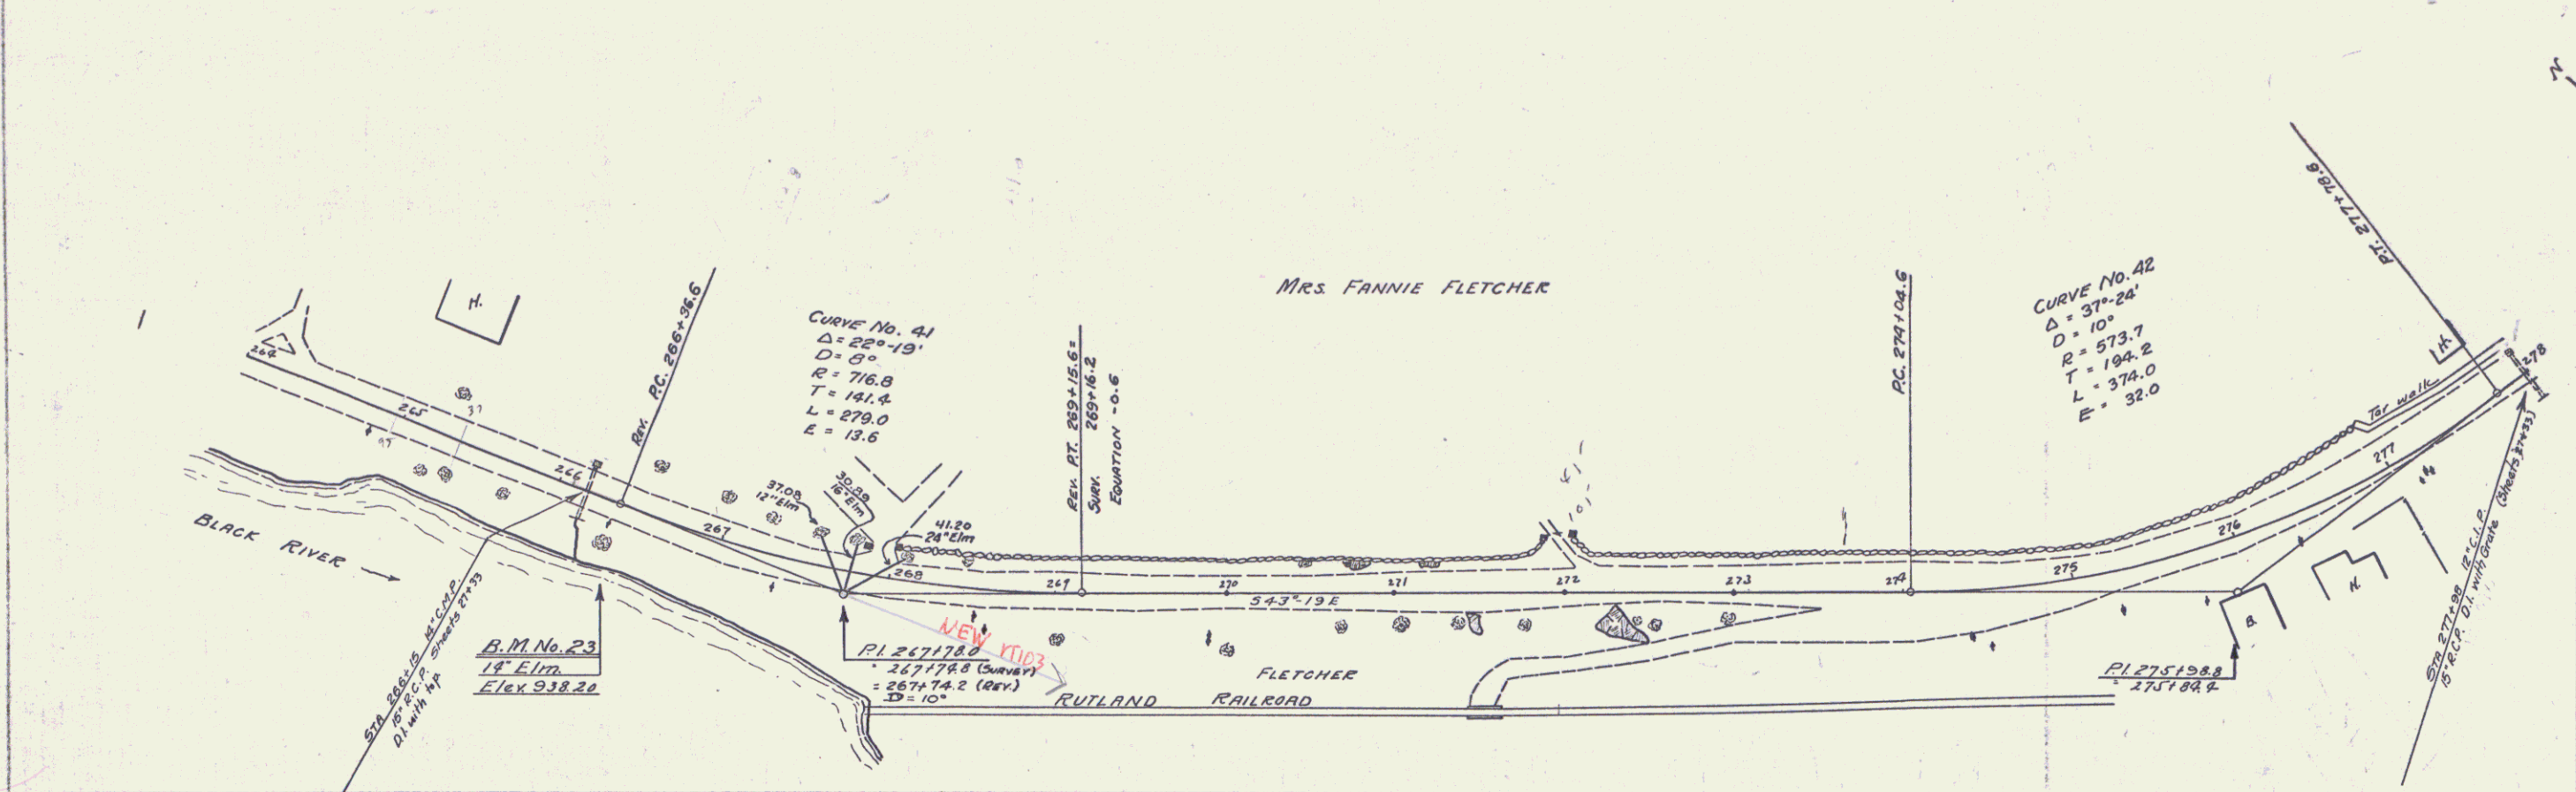

MAN
DATE
SCALE
PROJECT
SHEET NO.

MAN
DATE
SCALE
PROJECT
SHEET NO.