

INDEX OF SHEETS

SHEET NO.	Title Page
2-3	Typical Cross sections of Improvement
4-5	Quantity Summary Sheets
6-7	Item Detail and Drainage Sheets
8-11	Earthwork Sheets
12-13	Blank
14-15	R.O.M. Detail Sheets
16-33	Plan and Profile Sheets
34	Blank
35	A-6 Solid Rock Excavation
36	B-1 Banking Tables
37	B-5 Typical Slope Grading
38	B-6 Rock Excavation
39	B-7 Embankment on a Slope
40	Blank
41	B-7 Details of Rest Area
42	C-1 Curb
43	D-1 Precast Reinforced Concrete Pipe Drop Inlet
44	D-2 Underdrain and Headwalls
45	D-3 Jute Matting
46	D-4 Elbows and Flushing Basins
47	D-5 Details of Grates and Covers for Use with Catch Basins
48	D-6 Concrete Catch Basin or Manhole
49	D-7 Precast Reinforced Concrete Curb Drop Inlet
50	E-1 Barricades, Signs and Lights
51	E-2 Federal Aid Construction Identification Signs
52	G-3 Trench Cable Guard Rail with Steel Posts
53	G-3a Dead End Anchorage at Bridge Approach
54	G-4 Wood and Steel Harker and Guide Posts
55	J-1 Project and Boundary Markers
56	J-2 Standard Concrete Steps
57	J-4 Field Office
58-59	Blank
60	SR - SCD 30-42
61	SR - SCD 31-42
62	SR - SCD 32-42
63	SR - SCD 33-42
64	SR - SCD 34-42
65	SR - SCD 35-42
66	SR - SCD 36-42
67	SR - SCD 37-42
68	SR - SCD 38-42
69	SR - SCD 39-42
70	Blank
71	SR-1 Superstructure Details (M.L.)
72	SR-2 Earthwork and Bridge Quantity Sheet
73	SR-3 Details of Joint No. 1
74	SR-4 Details of Joint No. 2
75	SR-5 Approach Slab #1
76	SR-6 Approach Slab #2
77	SR-7 Reinforcing Steel Schedule
78	Blank
79	SR-8 Standard Structures SB-PA #2 (Pipe Arch)
80	Blank
81	SR-9 Plan and Elevation (Vt. Rte. 103)
82	SR-10 Bridge Quantity Sheet
83	SR-11 Preliminary Information Sheet
84	SR-12 Boring Log
85	SR-13 Joint No. 1 Details
86	SR-14 Joint No. 2 Details
87	SR-15 Approach Slab #1
88	SR-16 Approach Slab #2
89	SR-17 Reinforcing Steel Schedule
90	Blank
91-94	Roadway Cross Sections
95	Blank
96-105	Bridge and Channel Sections

Sheets added in Plans
 5 Earthwork Sheets
 11 Revised X Section Sheets
 20 Drainage Sheets
 3 Channel Section Sheets
 3 Details (Interchange R/L 103 & R/O 103)
 7 Prints of Bridge Detail Plans



(To Be Returned to R.O.M. Division)
 Form of 10-103
 PERMITAL
 NON FILE
 RIGHT-OF-WAY DIVISION

**STATE OF VERMONT
 DEPARTMENT OF HIGHWAYS**

PROPOSED IMPROVEMENT

FEDERAL AID PROJECT

TOWNS OF MT. HOLLY-LUDLOW
COUNTIES OF RUTLAND AND WINDSOR
VT. ROUTE 103
RUTLAND-BELLOWS FALLS ROAD

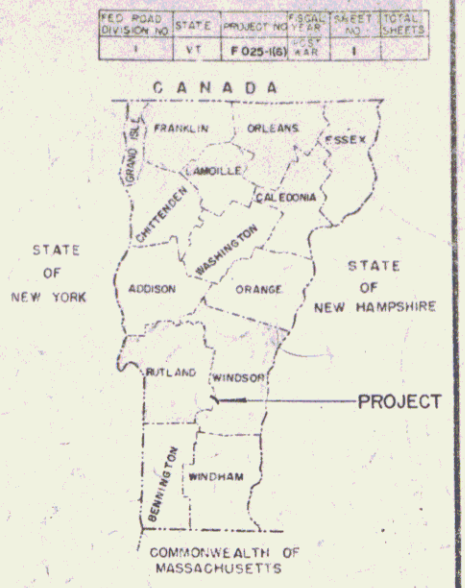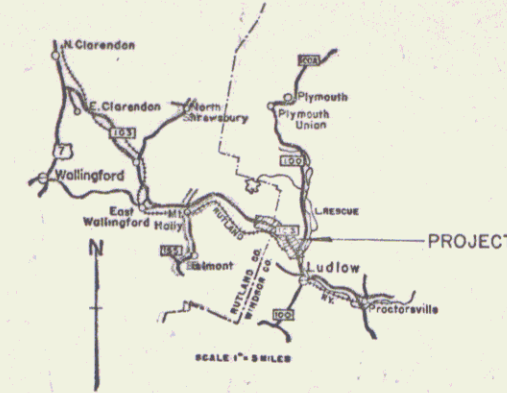

PROJECT NAME & NUMBER TYPE PAVT. AREA
 MT. HOLLY-LUDLOW F 025-1(6) BIT. CONC. 43,163 S.Y.

RECORD PLANS

MATERIALS

SUBBASE OF GRAVEL-PIERCE HIT & LAMPERT PIT-LUDLOW, VT.
 SUBBASE OF SAND-FISH & GAME PIT-LUDLOW, VT.
 SUBBASE OF CRUSHED ROCK, PENETRATION MACADAM CRUSHED
 STONE BASE COURSE & PEA STONE-KELLEY QUARRY-MT. HOLLY, VT.
 GRAVEL BACKFILL & SHOULDERS-PIERCE PIT-LUDLOW, VT.
 REFINED TAR-HUGGING REFINERY-MALDEN, MASS.
 TANK EMULSION & JOINT SEALER-HOT POURED-TRIRAM CORP-FRAMINGHAM, MASS.
 CUTBACK ASPH. & ASPH. CEVENT-HUMBLE OIL CO.-EVERETT, MASS.
 BITUMINOUS CONC. PAVT.-COLD RIVER HOT MIX, INC.-N. WALPOLE, N.H.
 CONCRETE CLASS A A S B-JOSEPH P. CARRARA & SONS INC.-RUTLAND, VT.
 & CHARLESTOWN READY MIX INC.-CHARLESTOWN, N.H.
 REINFORCING STEEL-BETHLEHEM STEEL CO.-ALBANY, N.Y.
 STRUCTURAL STEEL & PRE-FORMED JOINT SEALER-VERMONT
 STRUCTURAL STEEL CORE-BURLINGTON, VT.
 ASPHALTIC ASBESTOS COATING-W. W. WYMAN, INC.-GREENFIELD, MASS.
 BRIDGE RAILING-WARD WELLS, CO., INC.-NEWTON LOWER FALLS, MASS.
 REL. LEAF PAINT-WATERPROOF PAINT & VARNISH CO.-WATERTOWN, MASS.
 BRIDGE PAINT-GRAY-MASTER PAINT & COLOR WORKS-NEW ANDOVER, MASS.
 BRIDGE PAINT-GRAY-MASTER PAINT & COLOR WORKS-NEW ANDOVER, MASS.
 METAL CULVERT PIPE-NEW ENGLAND METAL CULVERT CO., INC.-WHITE
 RIVER JUNCTION, VT.
 REINFORCED CONCRETE PIPE-FRECH, C.C.D.I. & GUARD RAIL ITEMS -
 S.T. GRISWOLD & CO. INC.-WILKISTON, VT.
 TREES, SHRUBS & VINES-PUTNEY NURSERIES, INC.-PUTNEY, VT.

BEGINNING AT A POINT 1.09 MILES WESTERLY OF THE MOUNT HOLLY-
 LUDLOW TOWN LINE AND EXTENDING SOUTHEASTERLY 3.065 MILES.

LENGTH OF ROADWAY 16,101.69 FEET = 3.049 MILES
 LENGTH OF BRIDGE 8451 FEET = 0.016 MILE
 LENGTH OF PROJECT 16,186.20 FEET = 3.065 MILES

1965 ADT	2850-4000
1965 ADT	4400-5700
1965 DHV	580-740
D	60%
T	8-10%
V	50 M.P.H.

CONTRACTOR-S.V. ROSSI CONSTR. CO., INC.
 TORRINGTON, CONN.
 RESIDENT ENGINEER-ROBERT W. BUTLER
 INSPECTORS-M. SANDERSON, J. ST. PETER &
 H. DUKE JR.
 RECORD PLANS-A.G. SPIDLE


CONTRACT
 DATED--JANUARY 6, 1965.
 STARTED--JANUARY 18, 1965.
 COMPLETED--JULY 13, 1966.
 ACCEPTED--JULY 15, 1966.

PROJECT: Mt. Holly-Ludlow
 DIVISION: F 025-1(6)
 TYPE: BITUMINOUS CONCRETE PAVEMENT

CONTRACTOR: S.V. ROSSI CONSTR. CO., INC.
 TORRINGTON, CONN.

Location: Beginning at a point 1.09 miles westerly of the Mt. Holly-Ludlow
 town line and extending southeasterly 3.065 miles.

3691 Box 249

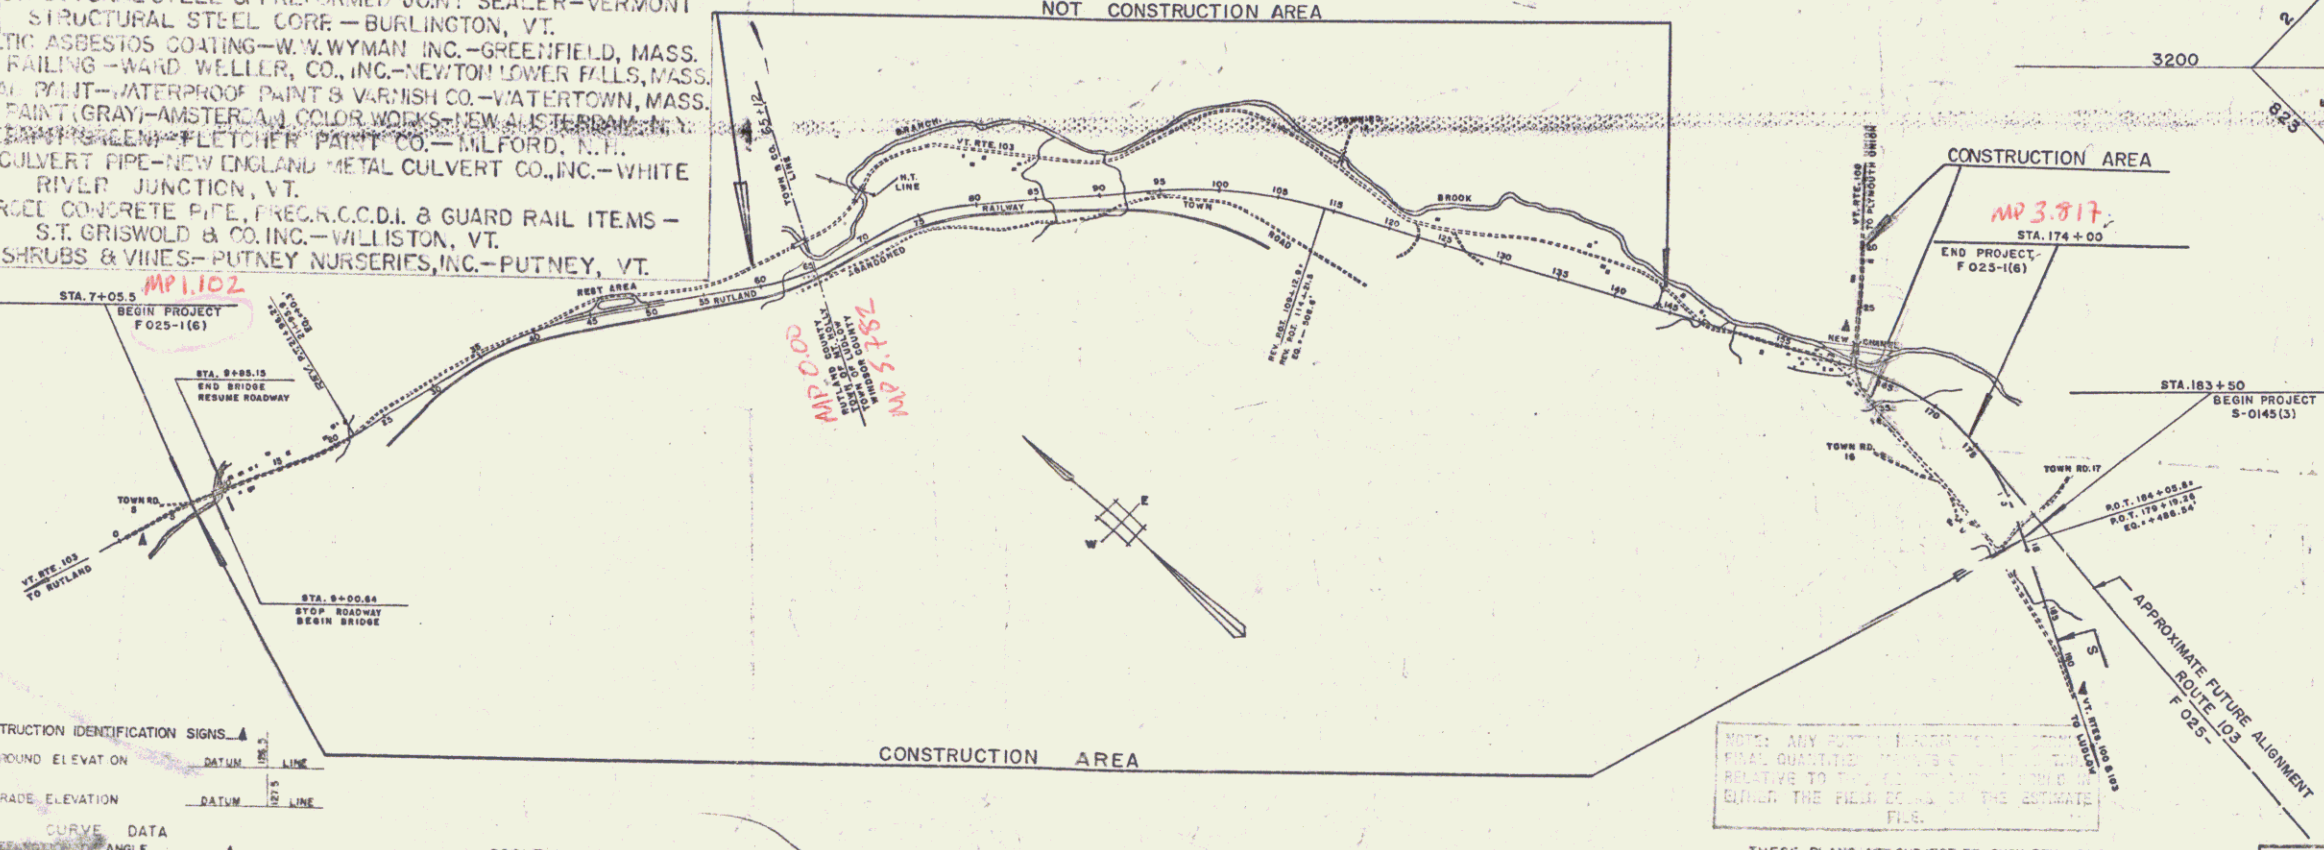

THESE PLANS ARE SUBJECT TO SUCH REVISIONS AS MAY BE
 REQUIRED BY THE BUREAU OF PUBLIC ROADS OR THE COMMISSIONER
 OF HIGHWAYS.

CONSTRUCTION IS TO BE CARRIED ON IN ACCORDANCE WITH
 THE PLANS AND THE STANDARD SPECIFICATIONS FOR HIGHWAY AND BRIDGE
 CONSTRUCTION OF JANUARY 1958 SUBMITTED TO THE BUREAU OF
 PUBLIC ROADS AS APPROVED JULY 5, 1959, INCLUDING ALL SUBSEQUENT
 APPROVED REVISIONS AND SUCH REVISED SPECIFICATIONS AND SPECIAL
 PROVISIONS AS ARE SUBMITTED WITH THE PLANS.

APPROVED: [Signature] DATE: 7/5/63	APPROVED: [Signature] DATE: 6/27/63	APPROVED: [Signature] DATE: 6/25/63	APPROVED: [Signature] DATE: 7/1/63	APPROVED: [Signature] DATE: 6/29/63	APPROVED: [Signature] DATE: June 26, 1963
---------------------------------------	--	--	---------------------------------------	--	--

DEPARTMENT OF COMMERCE
 BUREAU OF PUBLIC ROADS

PROJECT: F 025-1(6)

SHEET 1 OF 1