
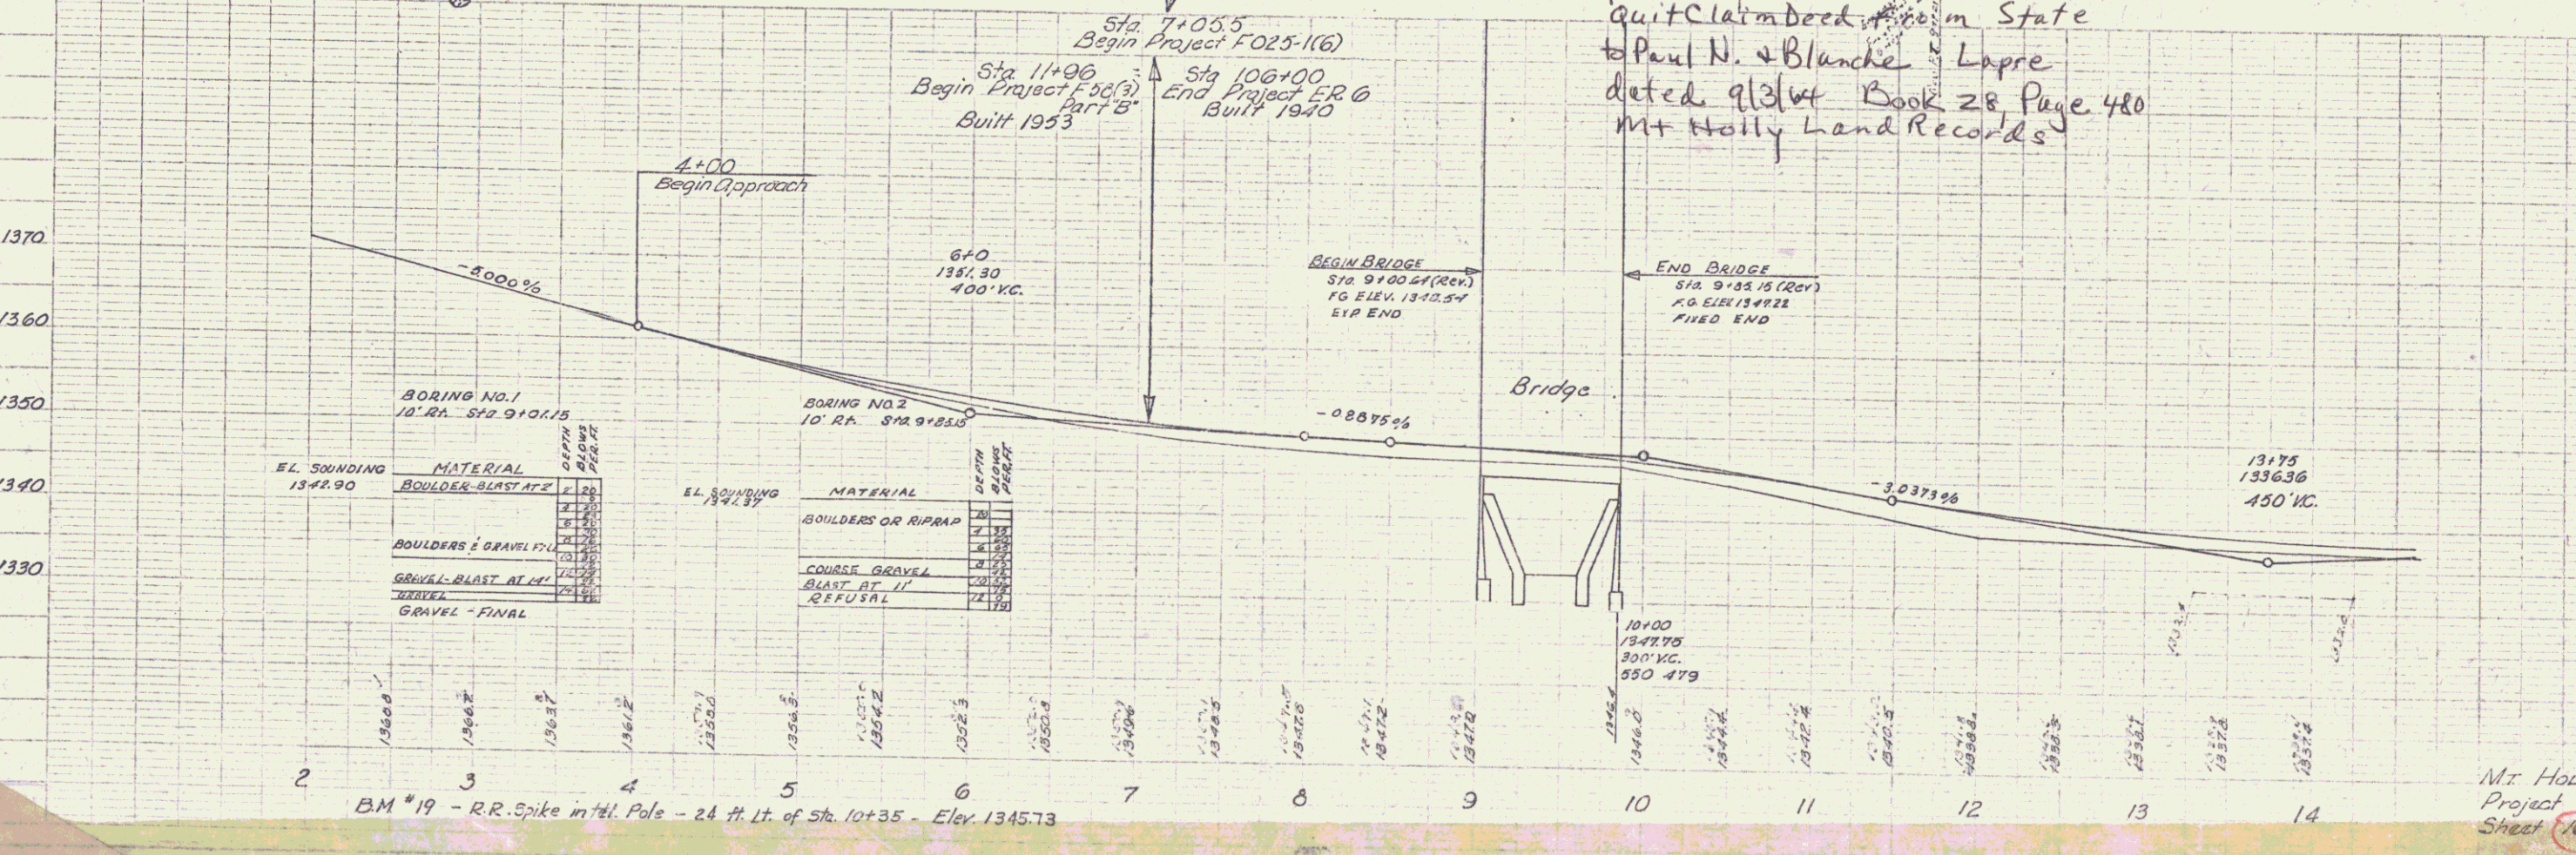


DATE	1/14/60
BY	W. J. LUDLOW
CHECKED	W. J. LUDLOW
SCALE	AS SHOWN
PROJECT	MT HOLLY
SHEET	116
TOTAL SHEETS	196

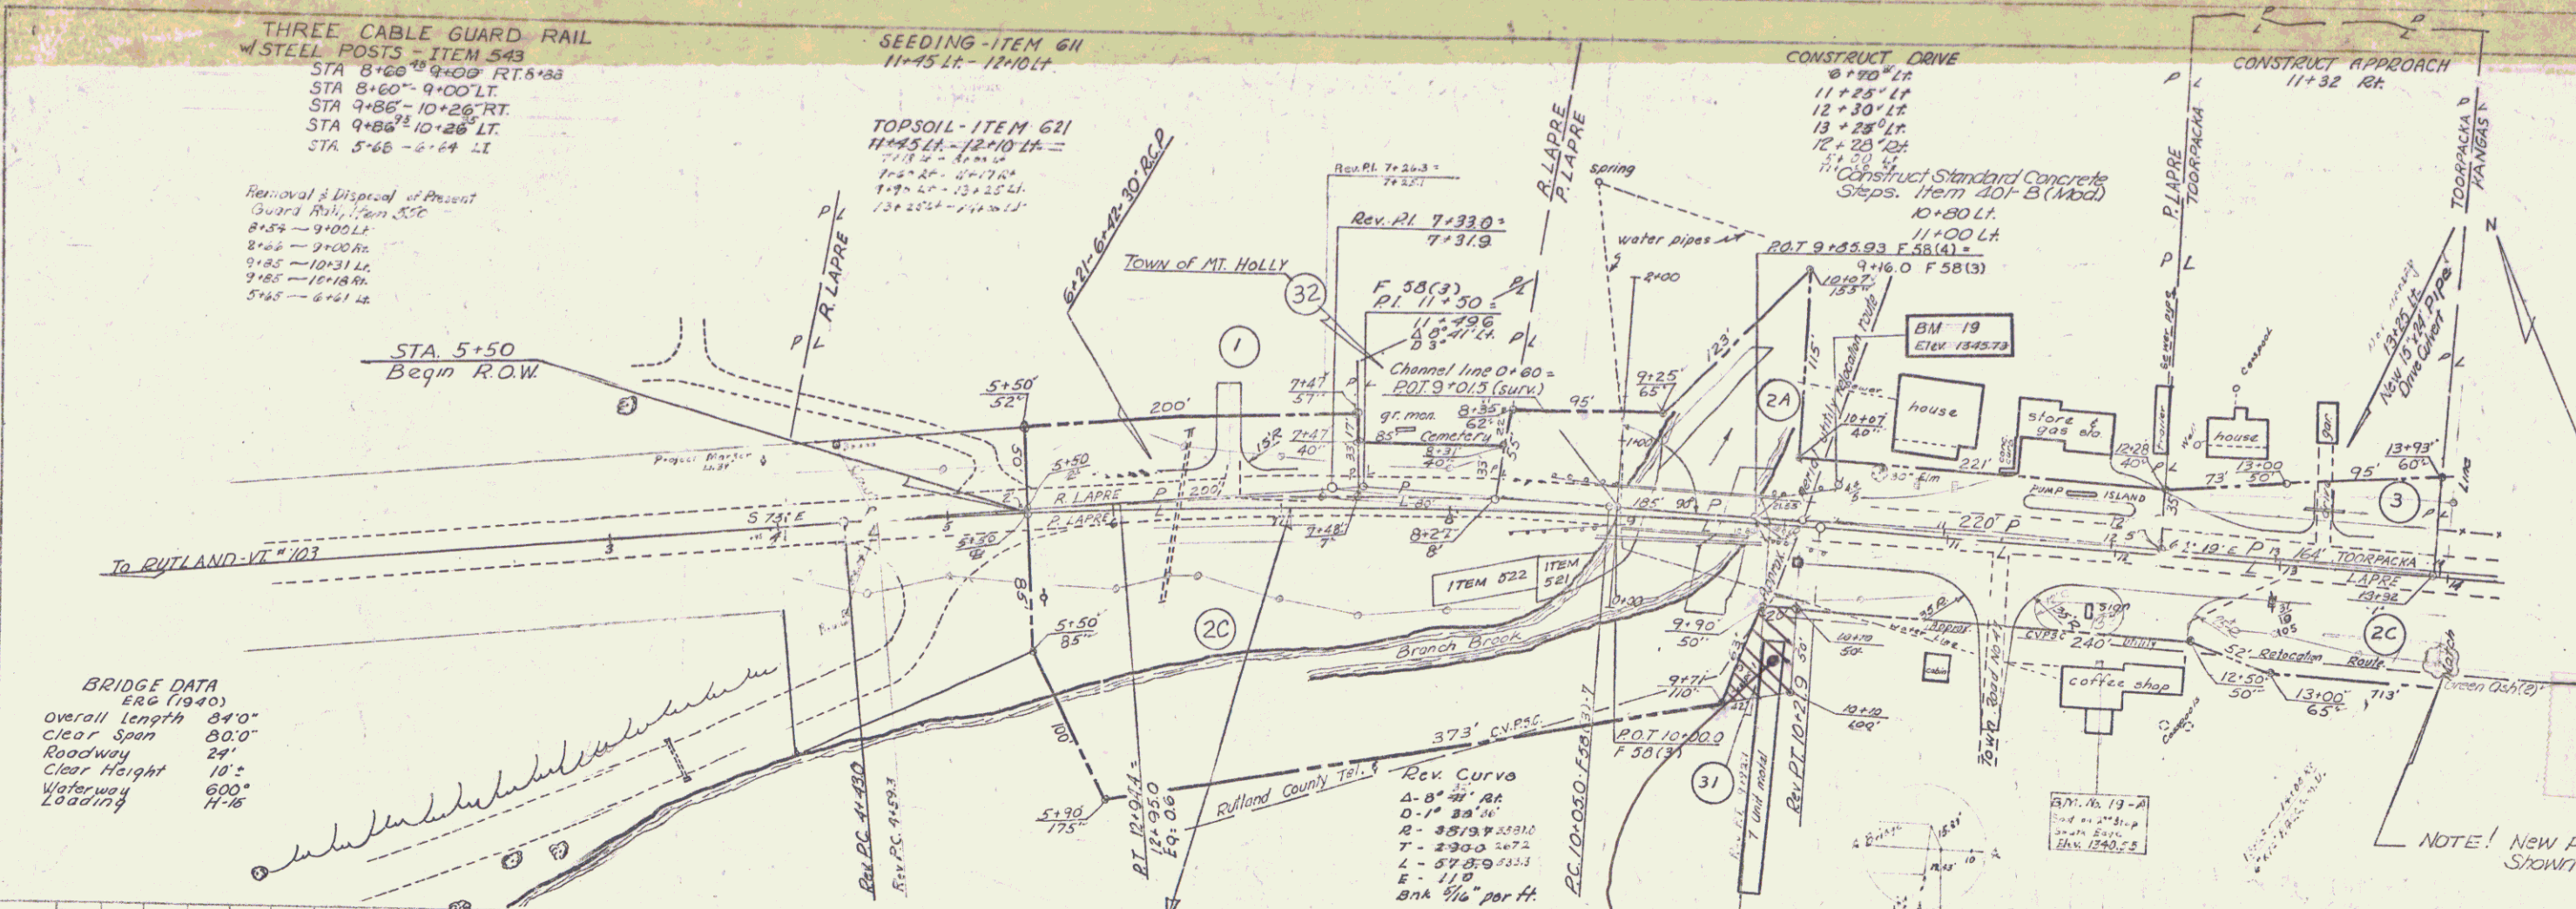

Quit Claim Deed from State
to Paul N. & Blanche Lapre
dated 9/3/44 Book 28 Page 480
Mt Holly Land Records