
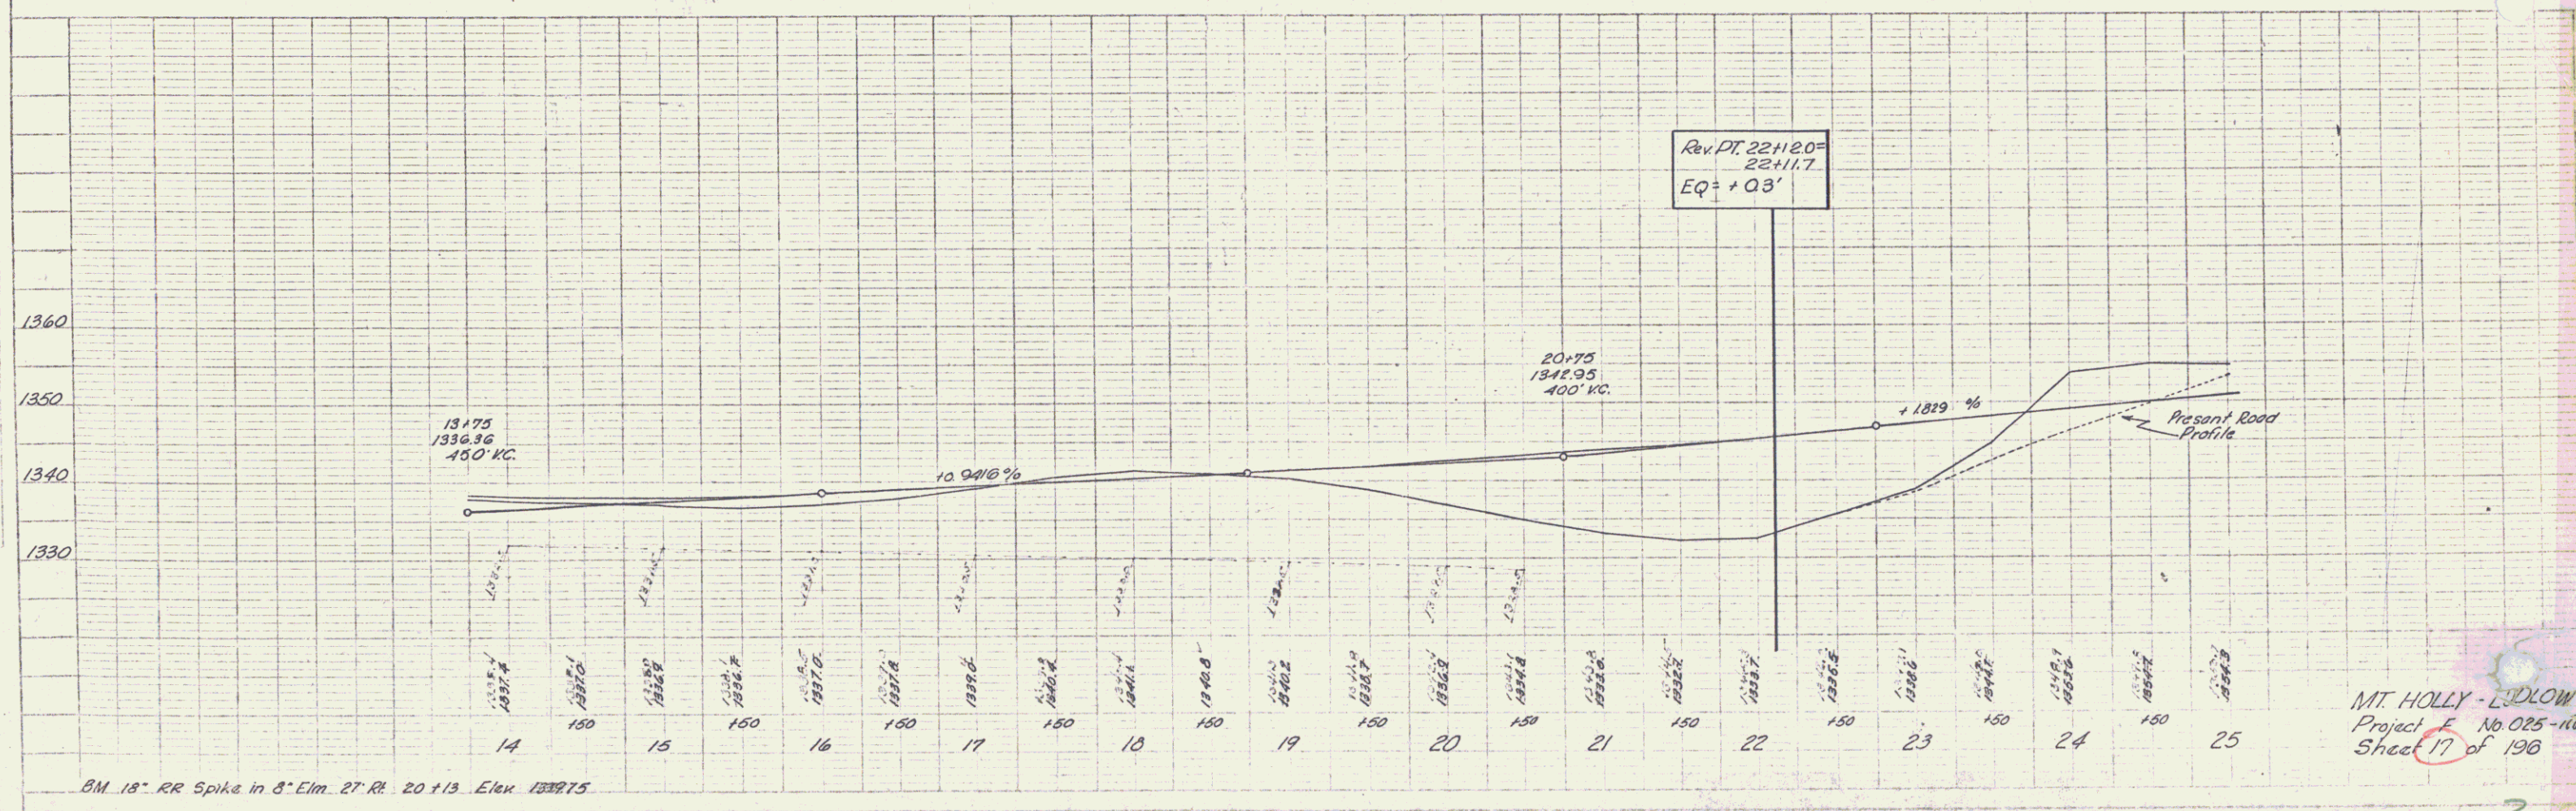


PLAT	1/4	1/60
DATE	1/15/19	
BY	...	
CHECKED	...	
APPROVED	...	

PROFILE	1/4	1/60
DATE	1/15/19	
BY	...	
CHECKED	...	
APPROVED	...	

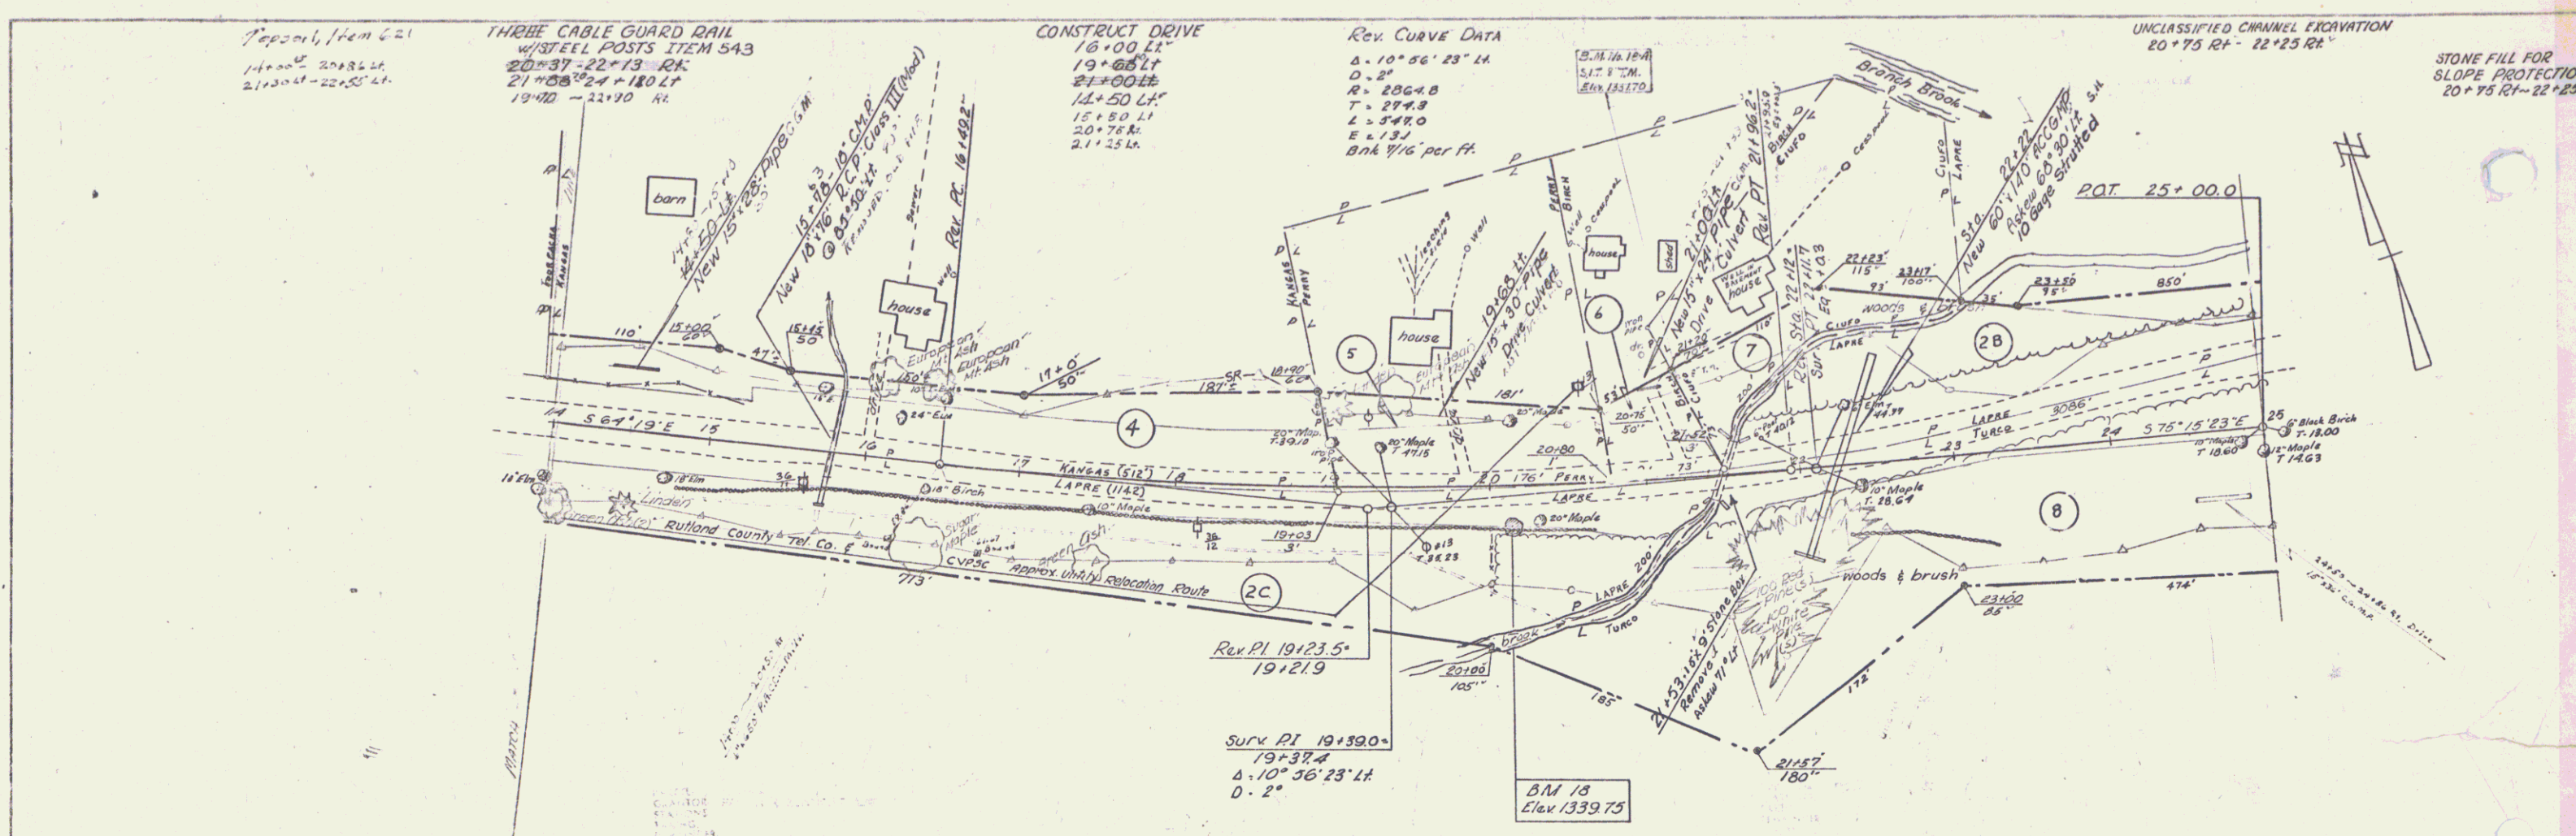

MT HOLLY - LADLOW  
Project E No. 025-nw  
Sheet 17 of 196