



PLAN
 DATE: 1/15/10
 DRAWN BY: [Signature]
 CHECKED BY: [Signature]
 TYPED BY: [Signature]

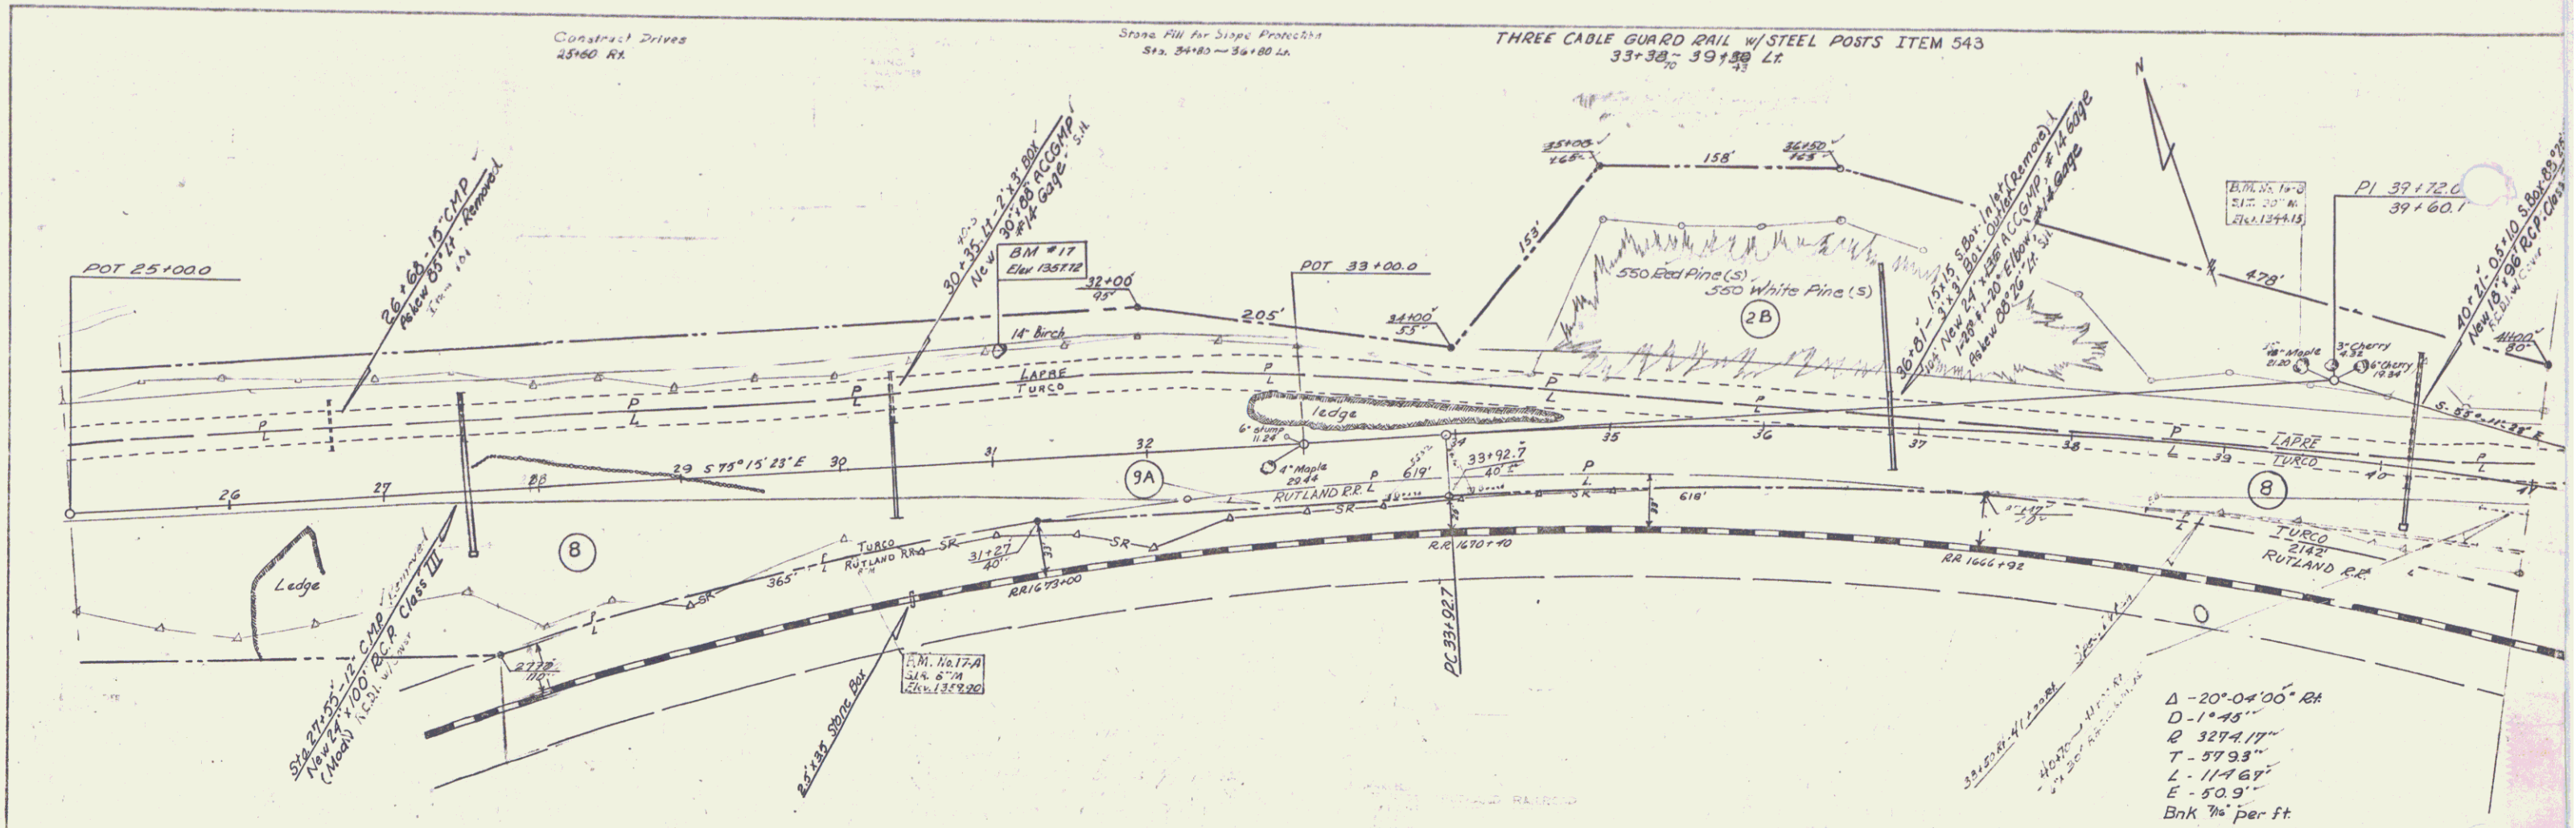

PROFILE
 DATE: 1/15/10
 DRAWN BY: [Signature]
 CHECKED BY: [Signature]
 TYPED BY: [Signature]

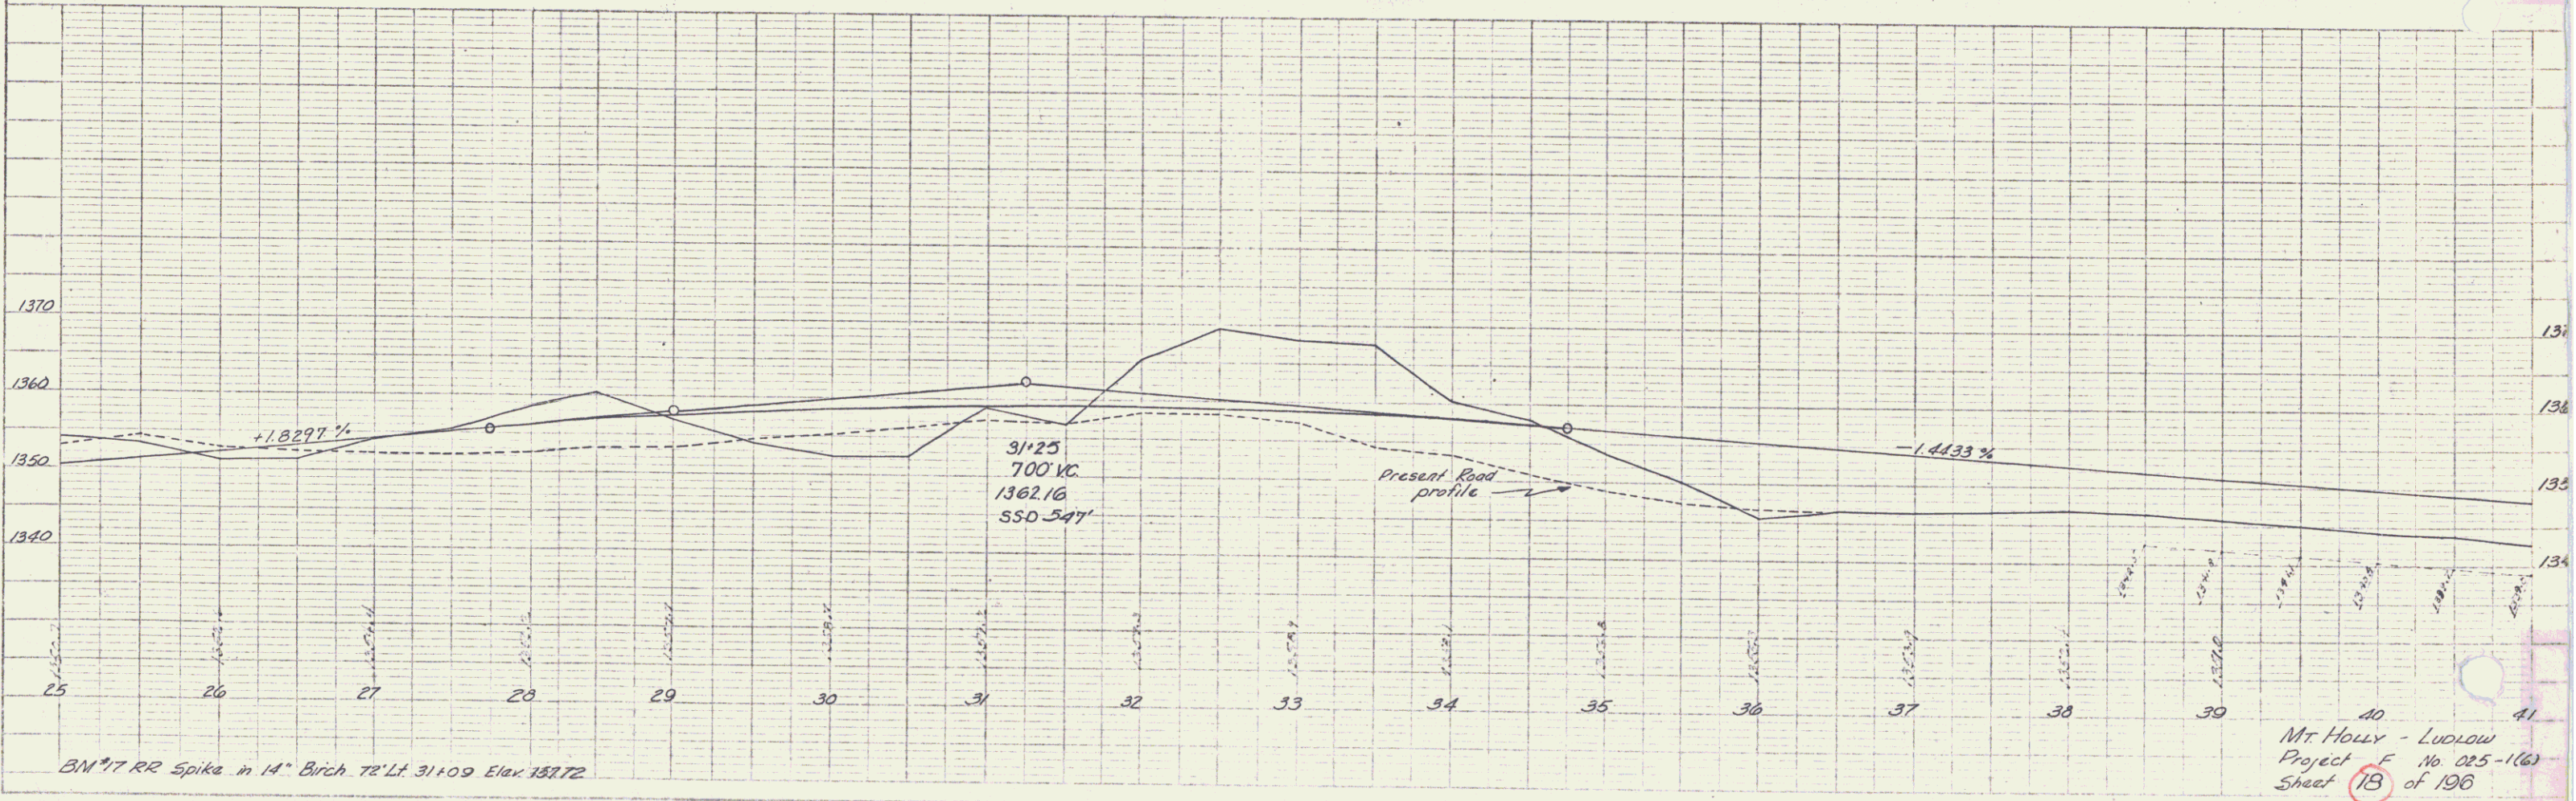

Mt Holly - Ludlow
 Project F No 025-1(6)
 Sheet 18 of 196