
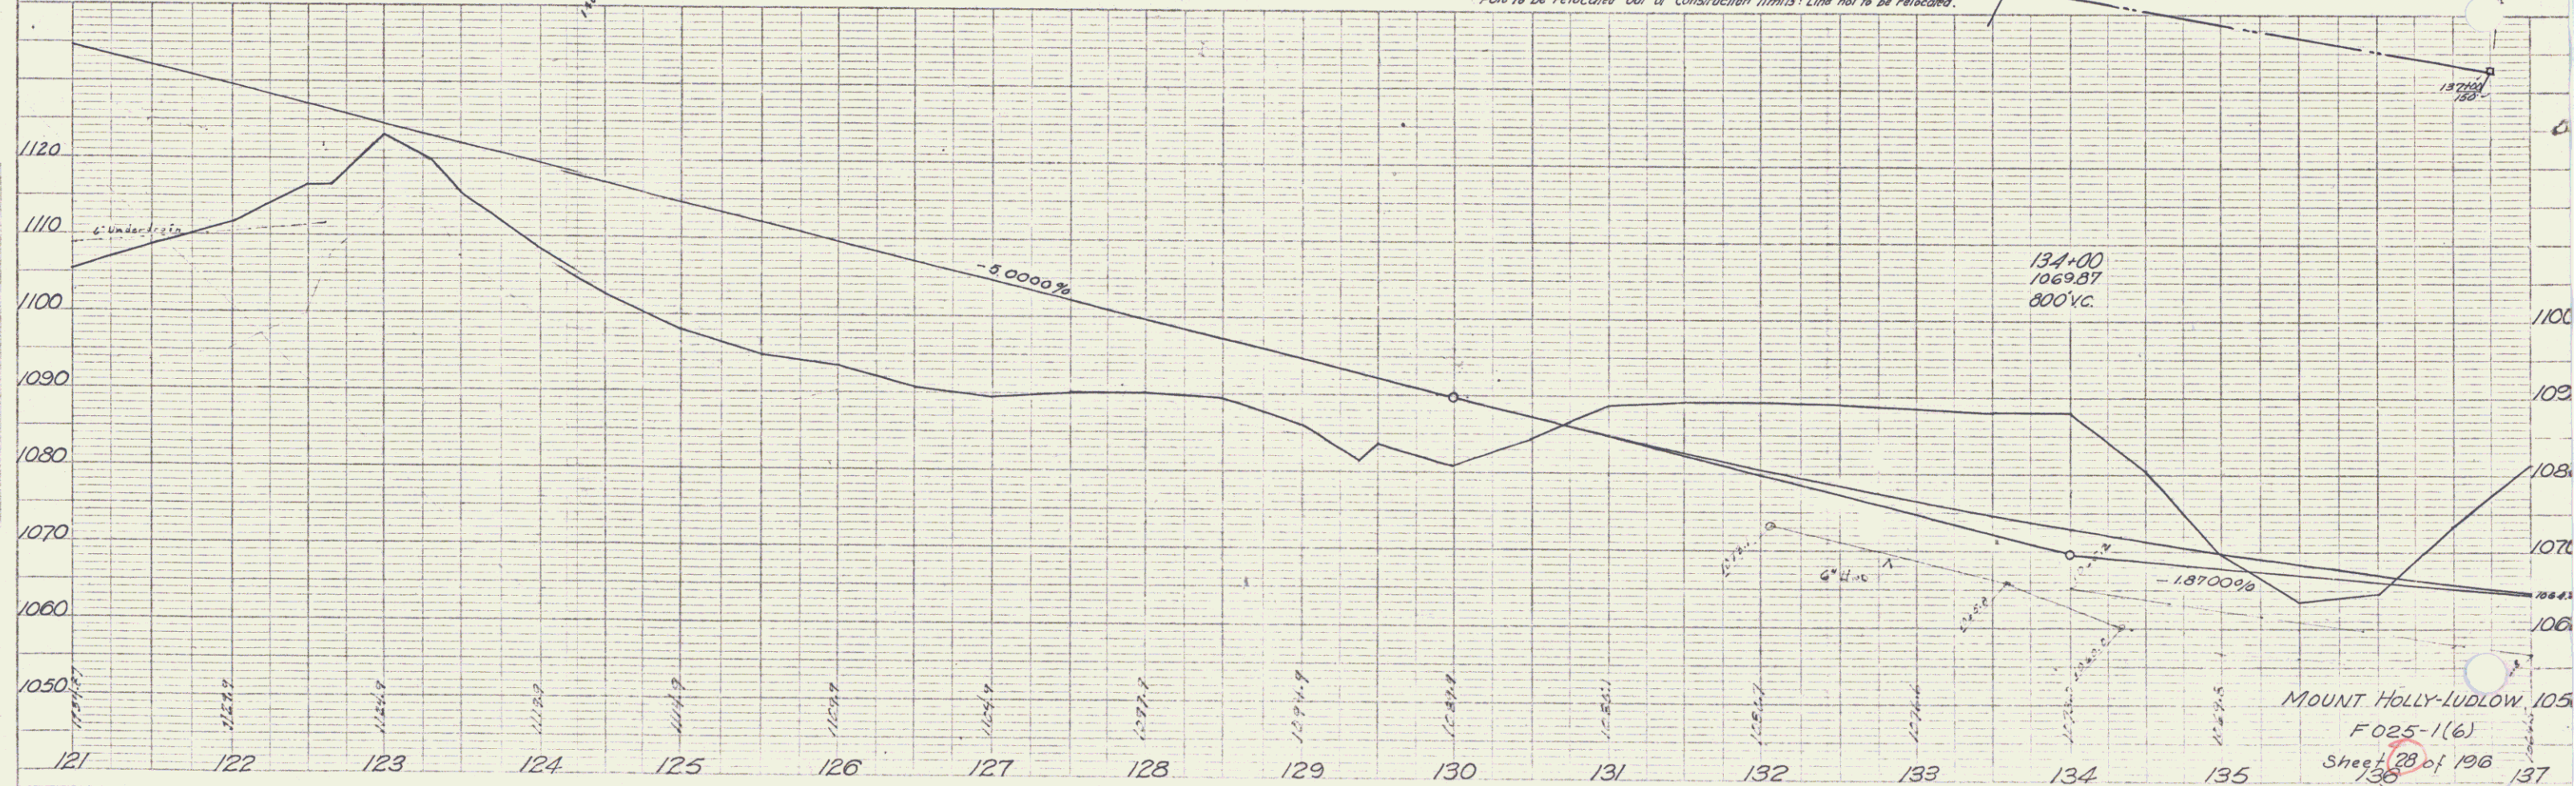


PLAN
 DRAWN BY
 CUMMINGS
 12/21/1916

PROFILE
 DRAWN BY
 CUMMINGS
 12/21/1916

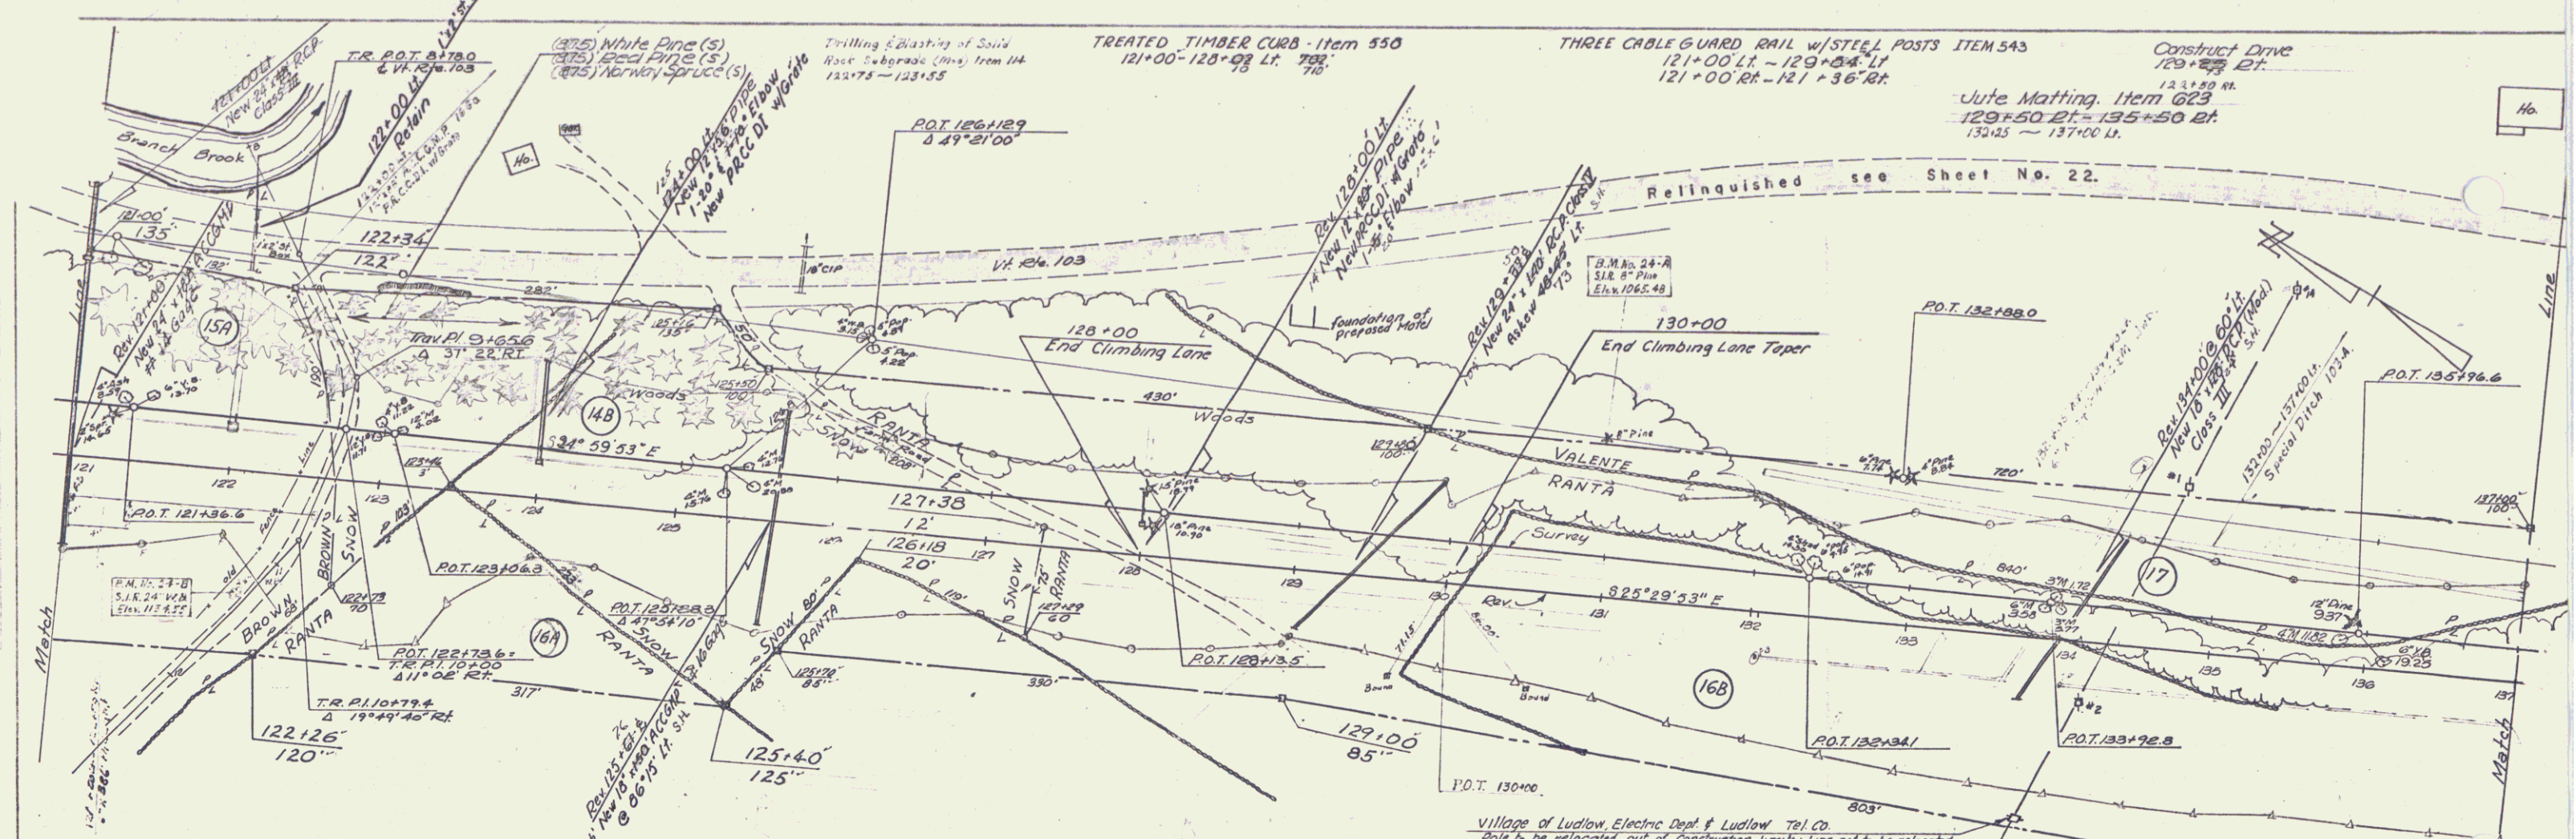

MOUNT HOLLY-LUDLOW 105
 F025-1(6)
 Sheet 28 of 196

10