

Drilling & Blasting of solid rock (See Section 114) Item 114
 144+60 - 148+15
 152+50 - 159+00
 Matting Item 623
 153+75 Lt.

Muck Excavation
 142+50 - 144+00
 144+10 to (Live Road)

Three Cable Guard Rail w/Steel Posts Item 543
 149+72 Lt. - 152+40 Lt.
 150+32 Lt. - 151+18 Lt.

Construct Drive
 151+00 Rt.

Construct Approach
 146+50 Lt.
 144+80 Lt.



Unclass Chan Excav.
 149+75 Lt. - 152+25 Lt.

Stone Fill For Slope Protection
 149+75 Lt. - 152+25 Lt.

Stone Fill Heavy Type
 Sta. 149+46 - 153+00 Lt.

PLAN	DATE	BY	CHECKED

PROFILE	DATE	BY	CHECKED

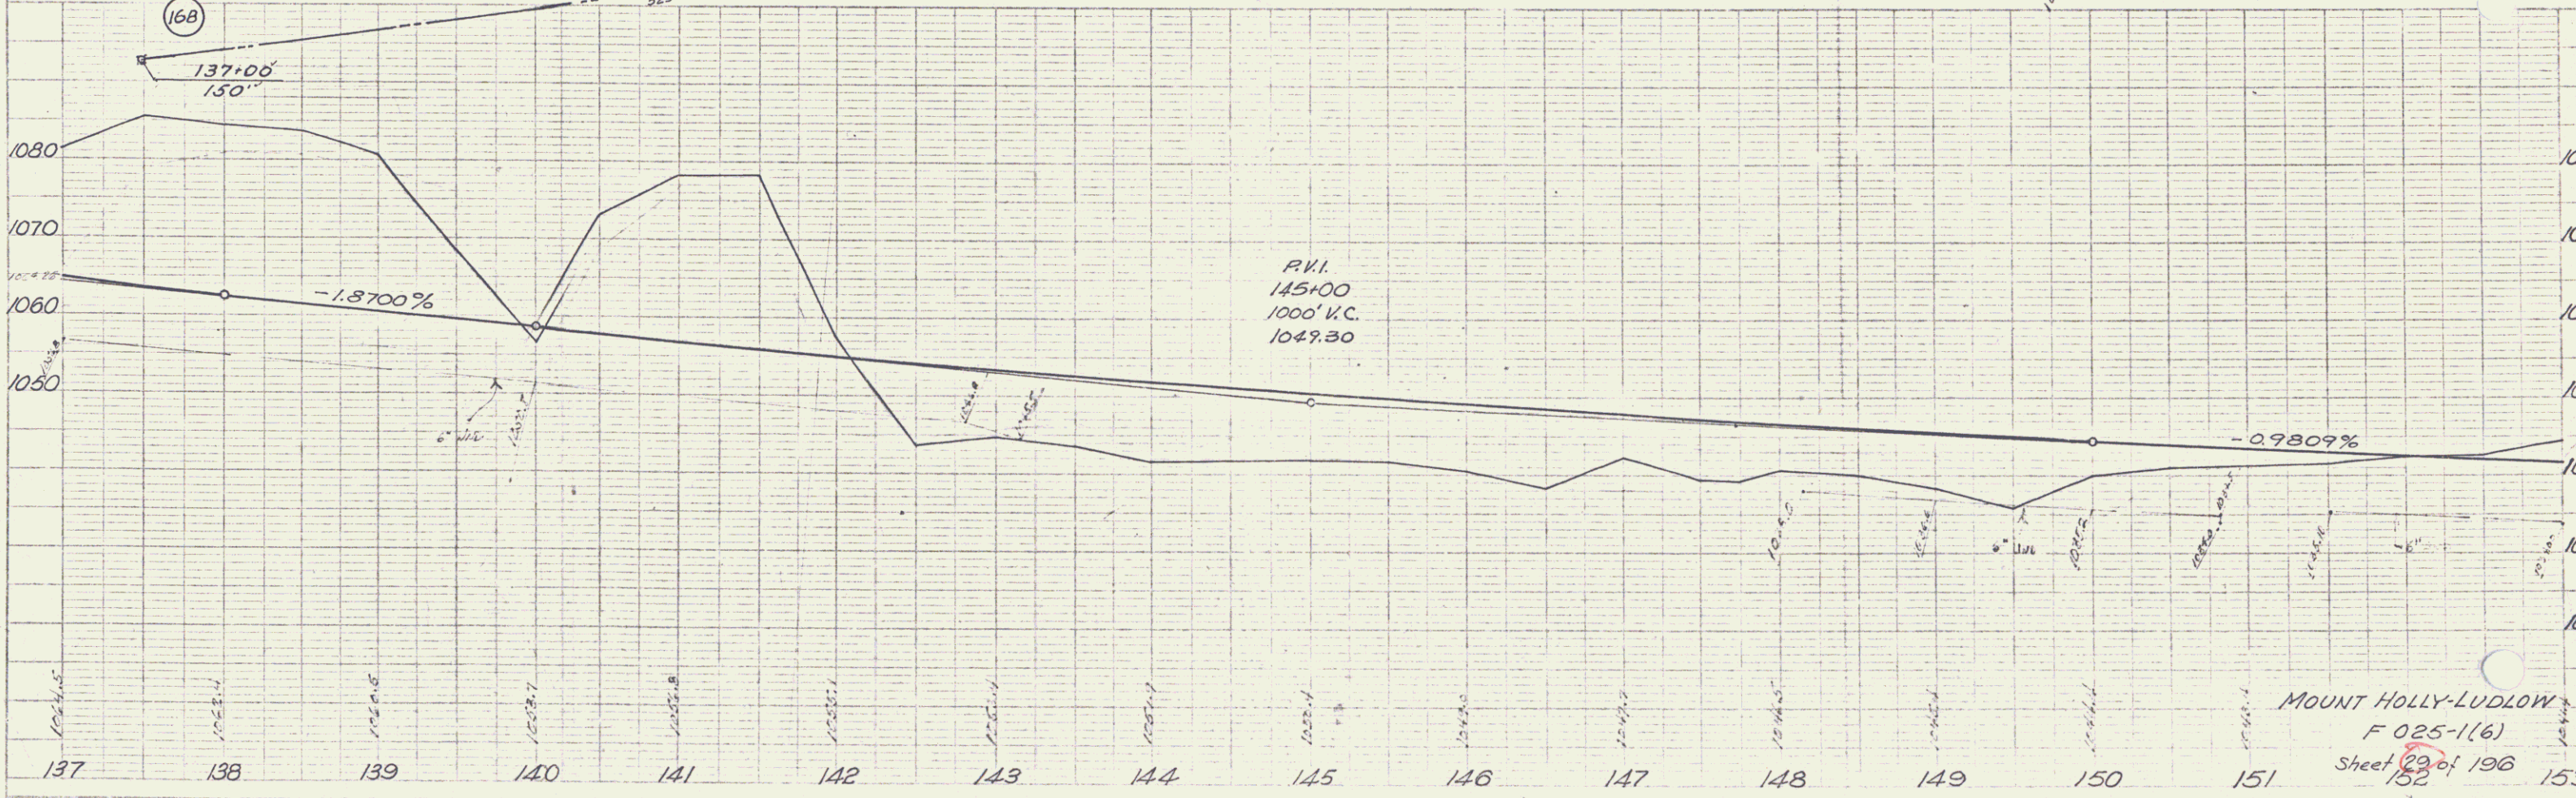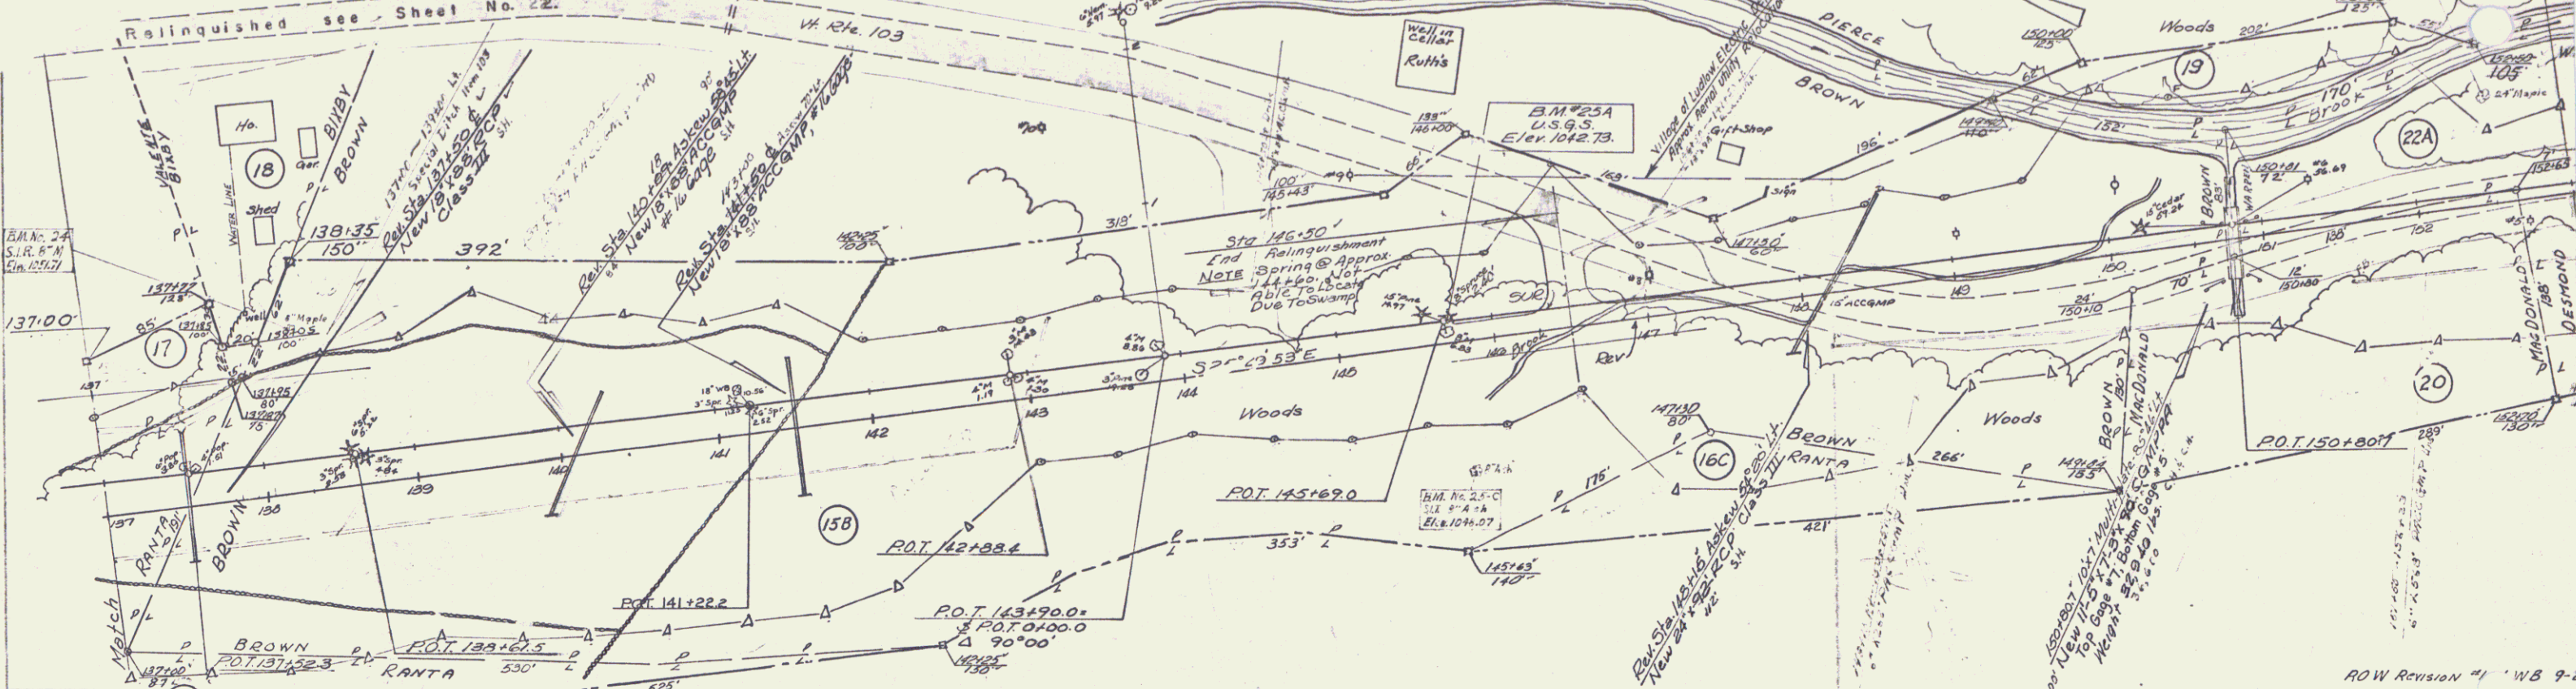

MOUNT HOLLY-LUDLOW
 F 025-1(6)
 Sheet 29 of 196