


PARCEL	8-A	STA. 189+68 - 212+91.2
GRANTOR	STANLEY FURGAT & KAROLINA	
TAKING RIGHTS	5.88A ±	
TITLE TAKEN	CULVERT	STA. 190+30, 193+63, 198+00
RECORDED	COND 10/3/58	203+00, 206+50
	ROCKINGHAM	bk. 113 pg. 49 DT. 10/3/58

PARCEL	7	STA. 184+65 - 190+32
GRANTOR	MYRTLE S. SPENCER	
TAKING RIGHTS	1.65 A ±	REM.
TITLE TAKEN	WD 5/20/58	
RECORDED	ROCKINGHAM	bk. 138 p. 418 DT. 5/28/58

THE SECTION OF HIGHWAY, BEGINNING AT A POINT IN THE CENTER OF FORMER VERMONT ROUTE 103, ± 975 FEET SOUTHEASTERLY FROM ITS INTERSECTION WITH TOWN ROAD NO. 31, AND 58 FEET RIGHT OR NORTHEASTERLY OF STA. 174+00 OF HIGHWAY PROJECT-ROCKINGHAM F 025-1(1); THENCE CONTINUING ± 0.872 MILE NORTHWESTERLY TO A POINT IN THE CENTER OF SAID FORMER HIGHWAY, 50 FEET RIGHT OR NORTHEASTERLY FROM STA. 209+50 OF SAID HIGHWAY PROJECT, IS HEREBY RELINQUISHED AND RETURNED TO THE TOWN OF ROCKINGHAM AND RECORDED IN BOOK 113, PAGE 208 OF LAND RECORDS OF THE TOWN OF ROCKINGHAM, DECEMBER 13, 1963.

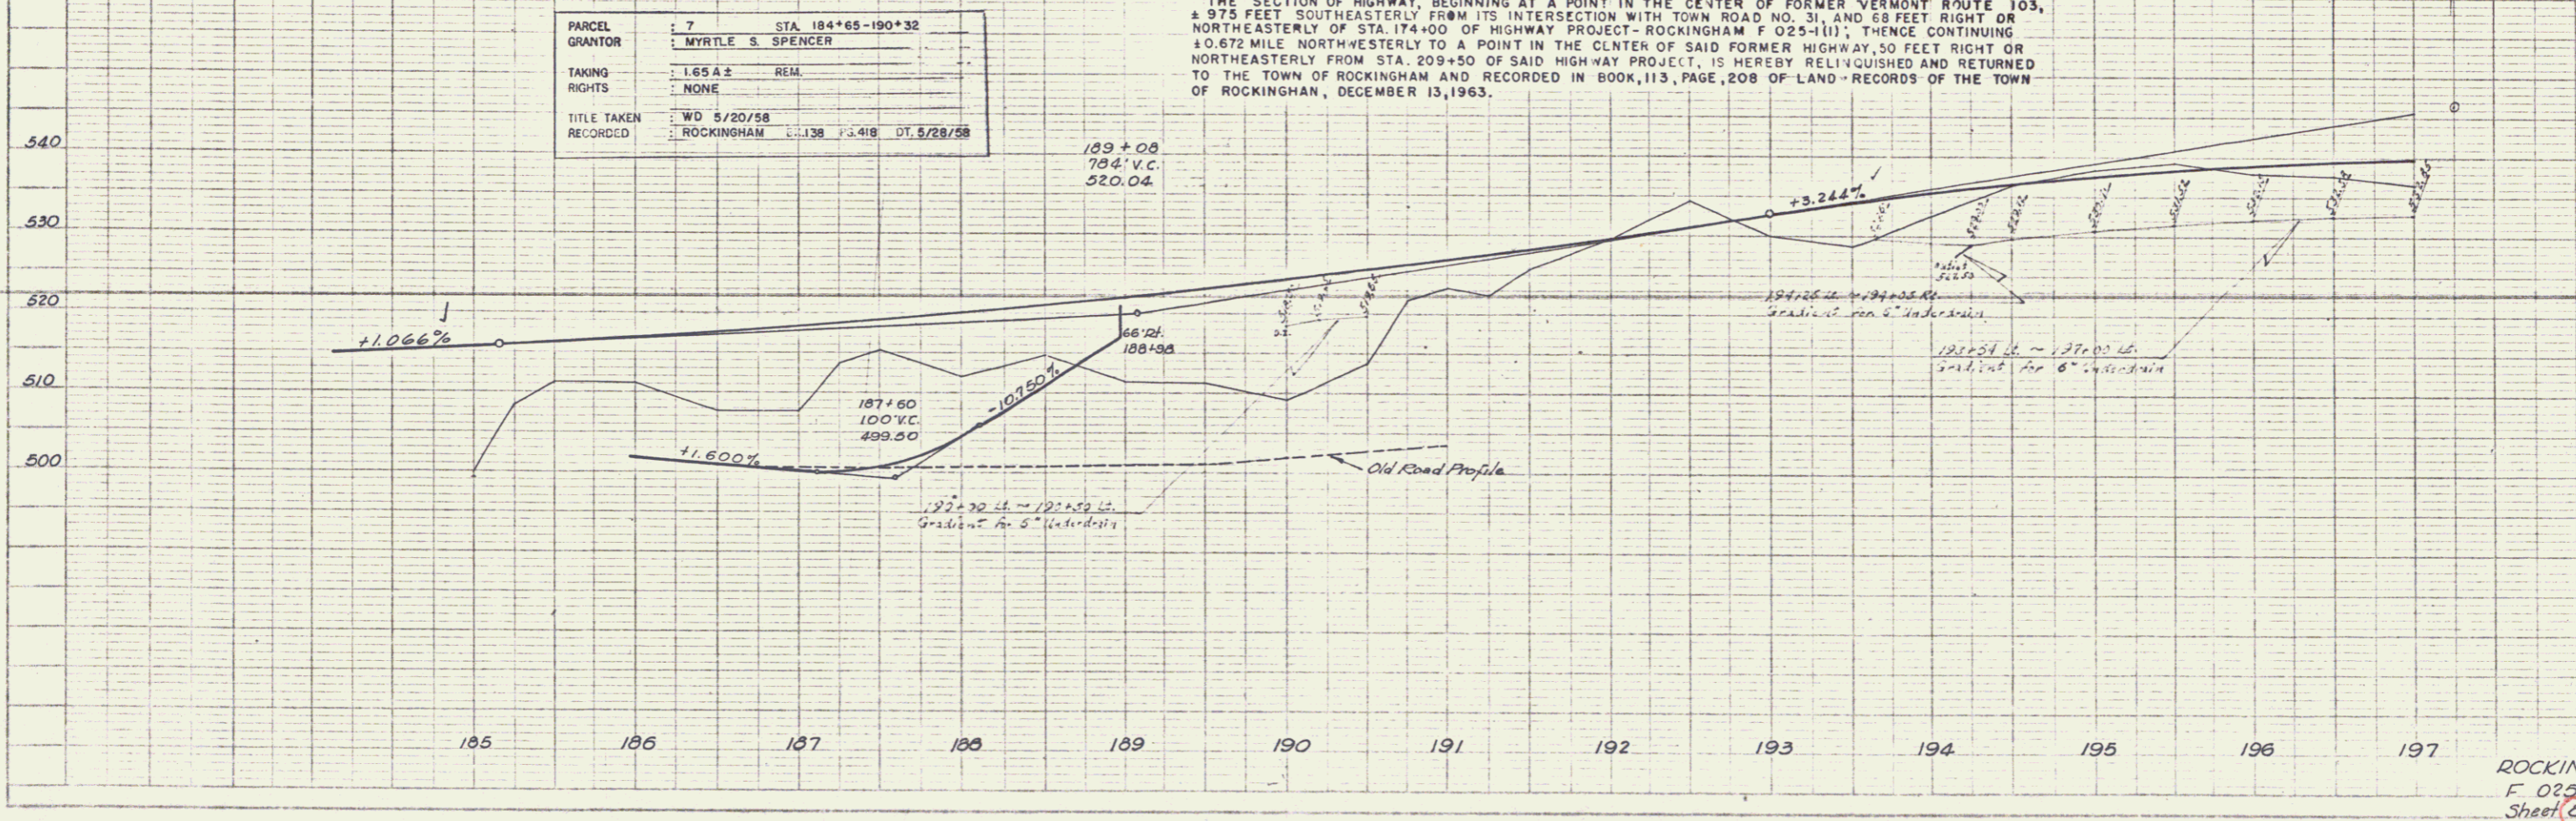

ROCKINGHAM
F 025-1(1)
Sheet 8 of 33