


DATE	BY	REVISION
3-30-60	W. J.
3-30-60	W. J.
3-30-60	W. J.

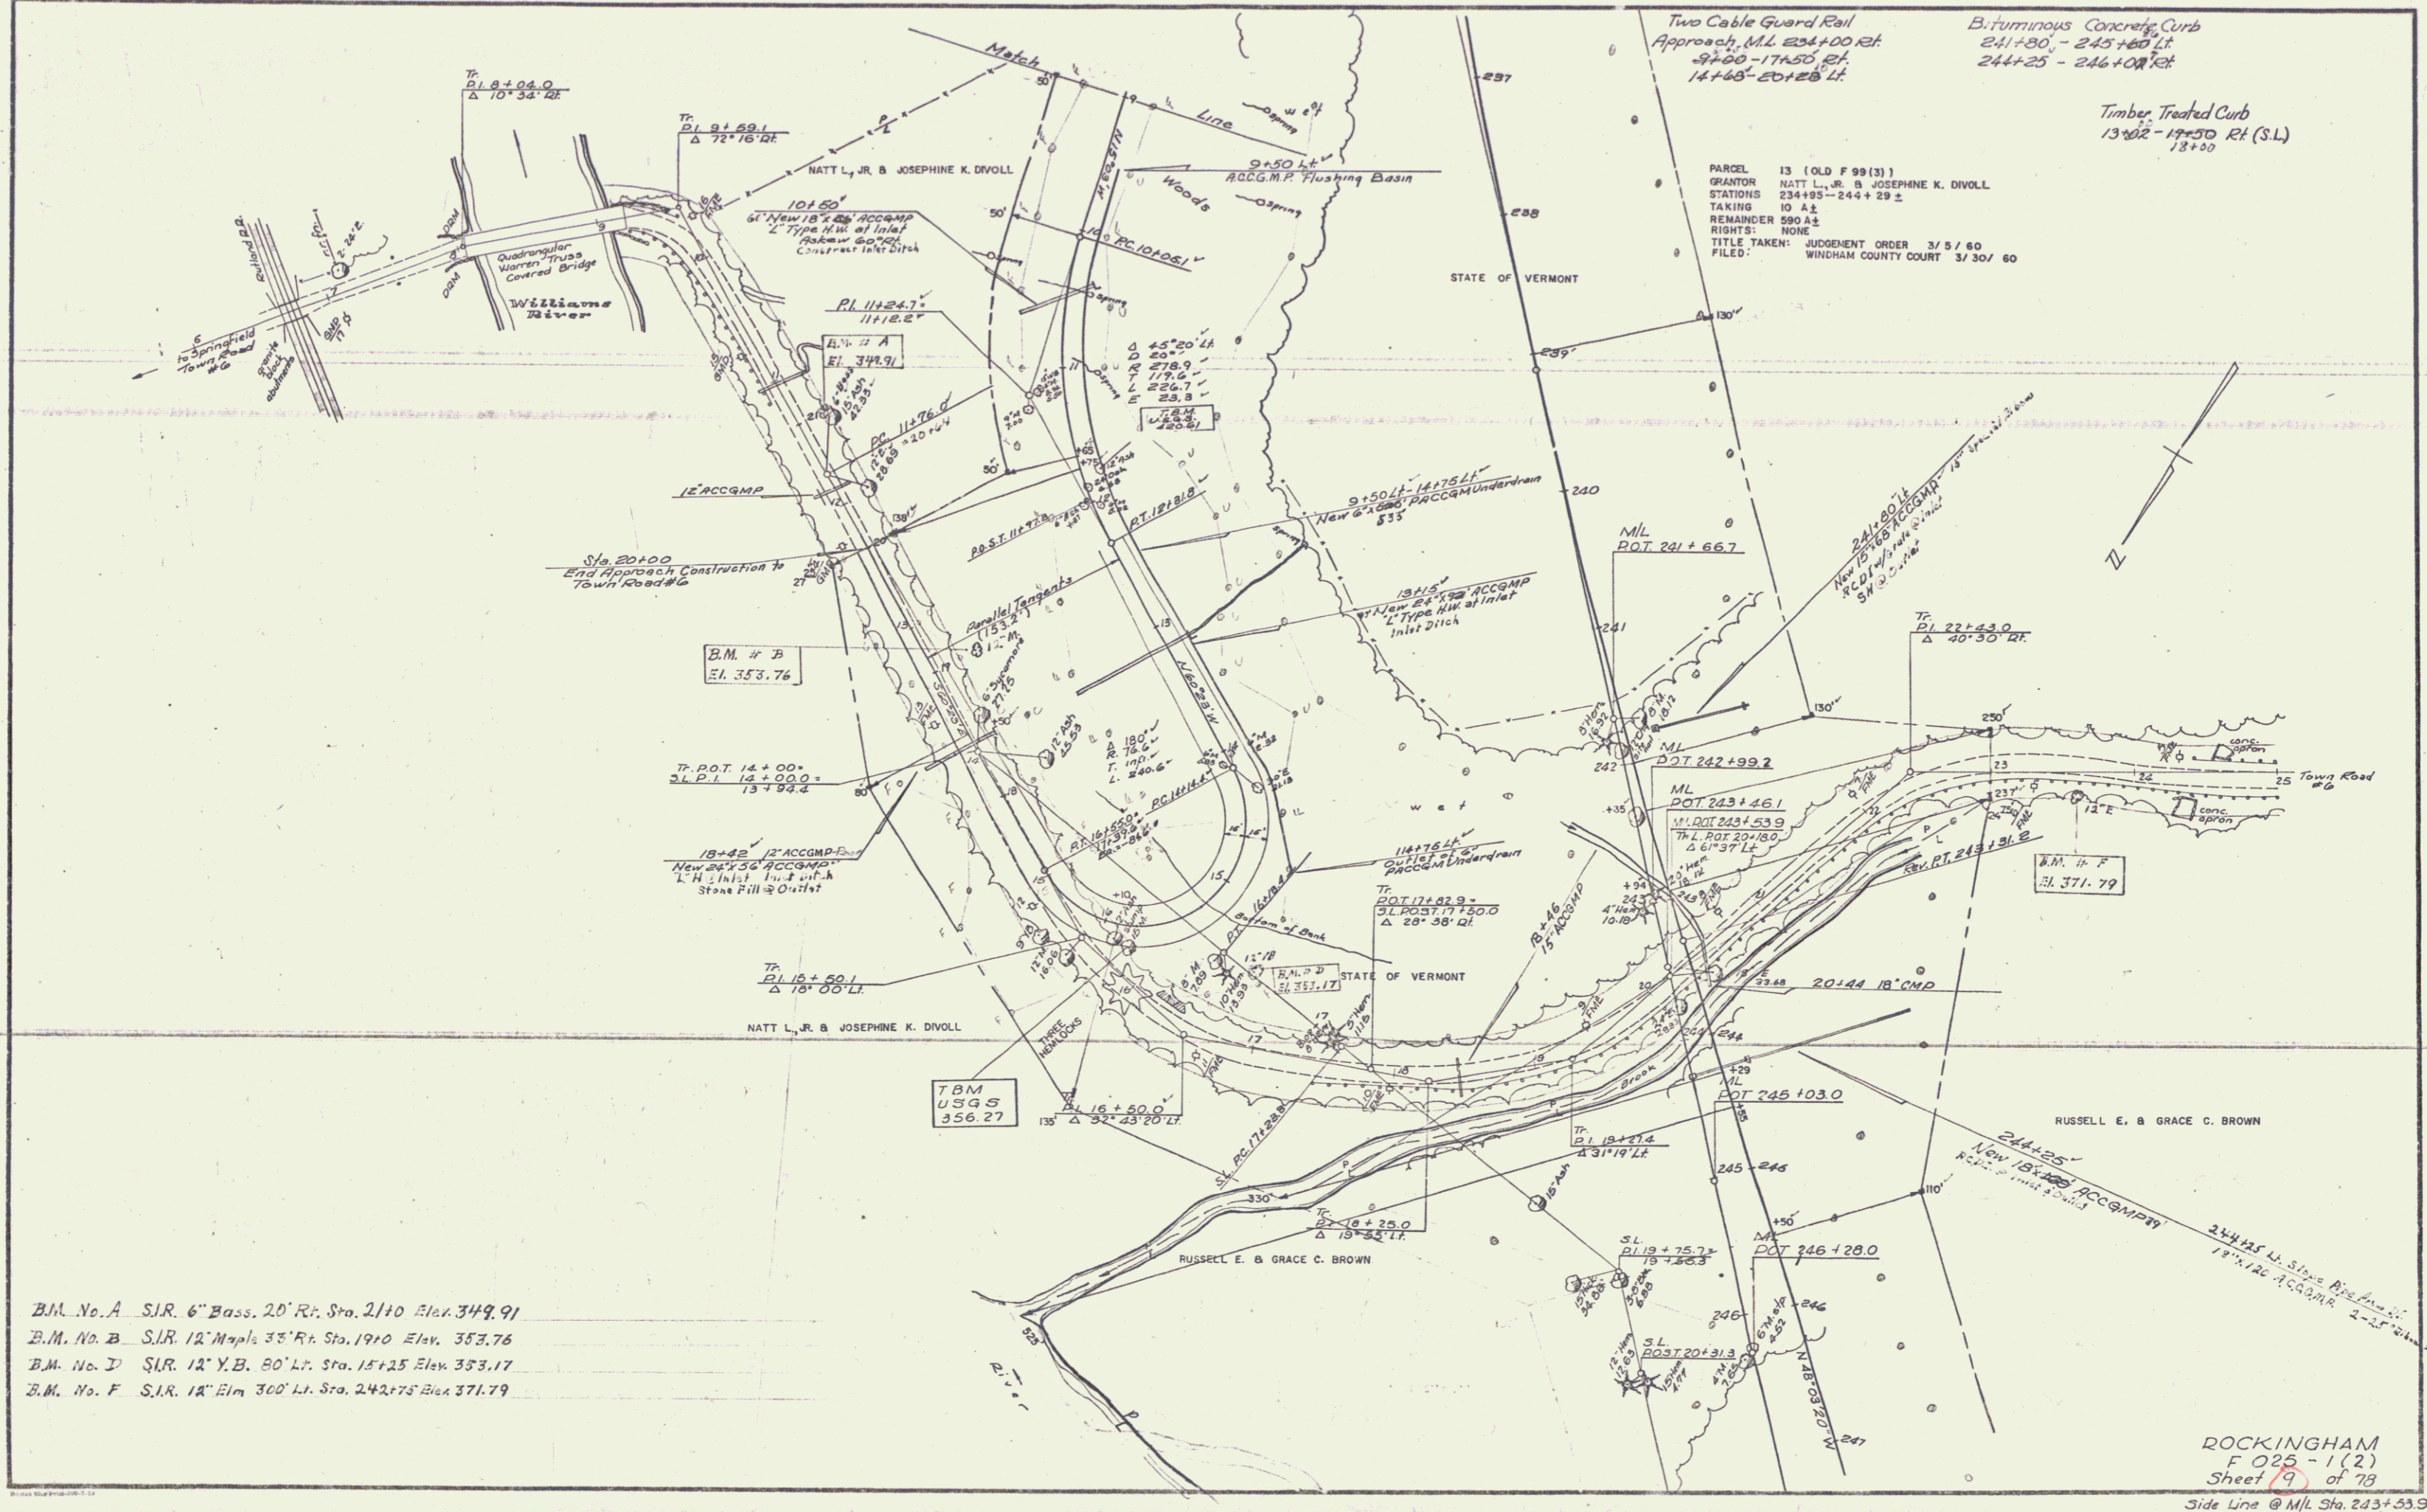

B.M. No. A S.I.R. 6" Bass. 20' R.H. Sta. 2110 Elev. 349.91
 B.M. No. B S.I.R. 12" Maple 33' R.H. Sta. 1910 Elev. 353.76
 B.M. No. D S.I.R. 12" Y.B. 80' L.H. Sta. 15+25 Elev. 353.17
 B.M. No. F S.I.R. 18" Elm 300' L.H. Sta. 242+75 Box 371.79

ROCKINGHAM
 F 025-1(2)
 Sheet 19 of 78
 Side Line @ M.L. Sta. 243+53.9