
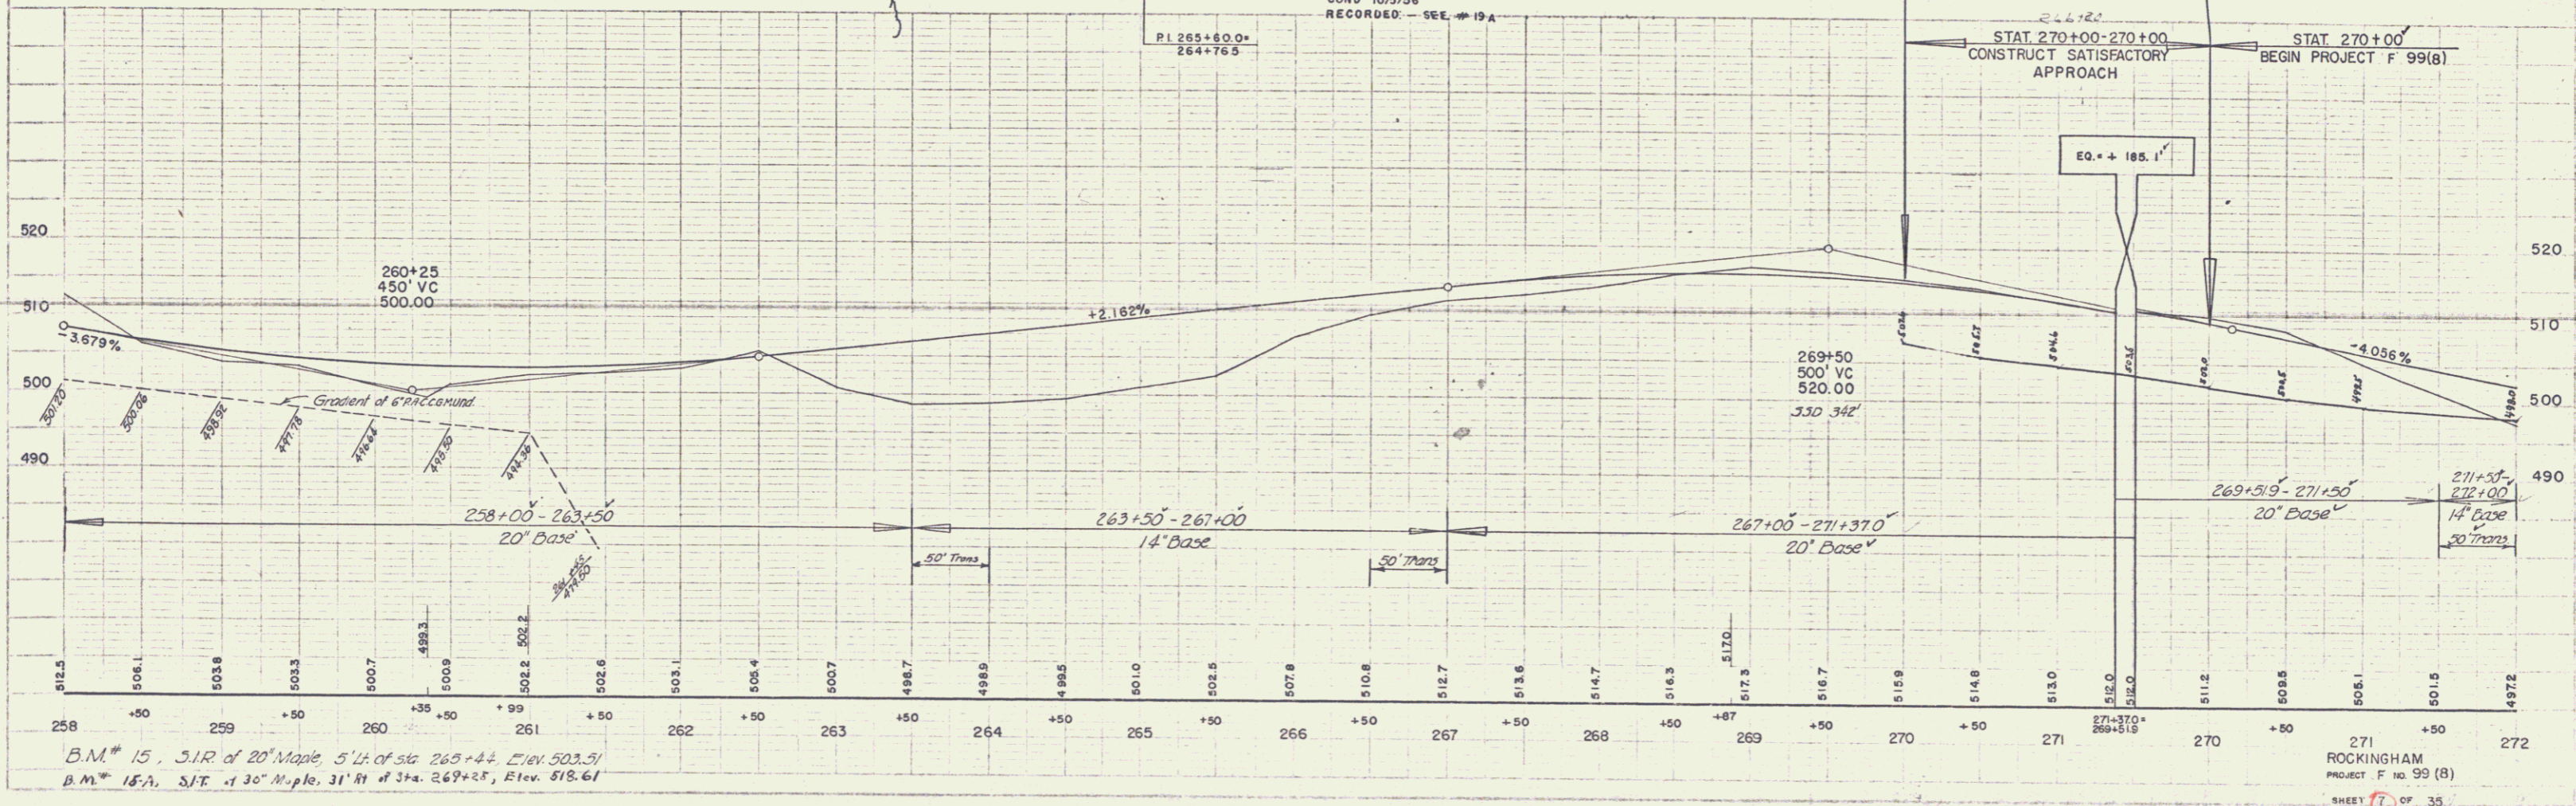


PLAN	SECTION	POSSIBLE	DATE
DATE BOOK	DATE BOOK	DATE BOOK	DATE BOOK
NO.	NO.	NO.	NO.

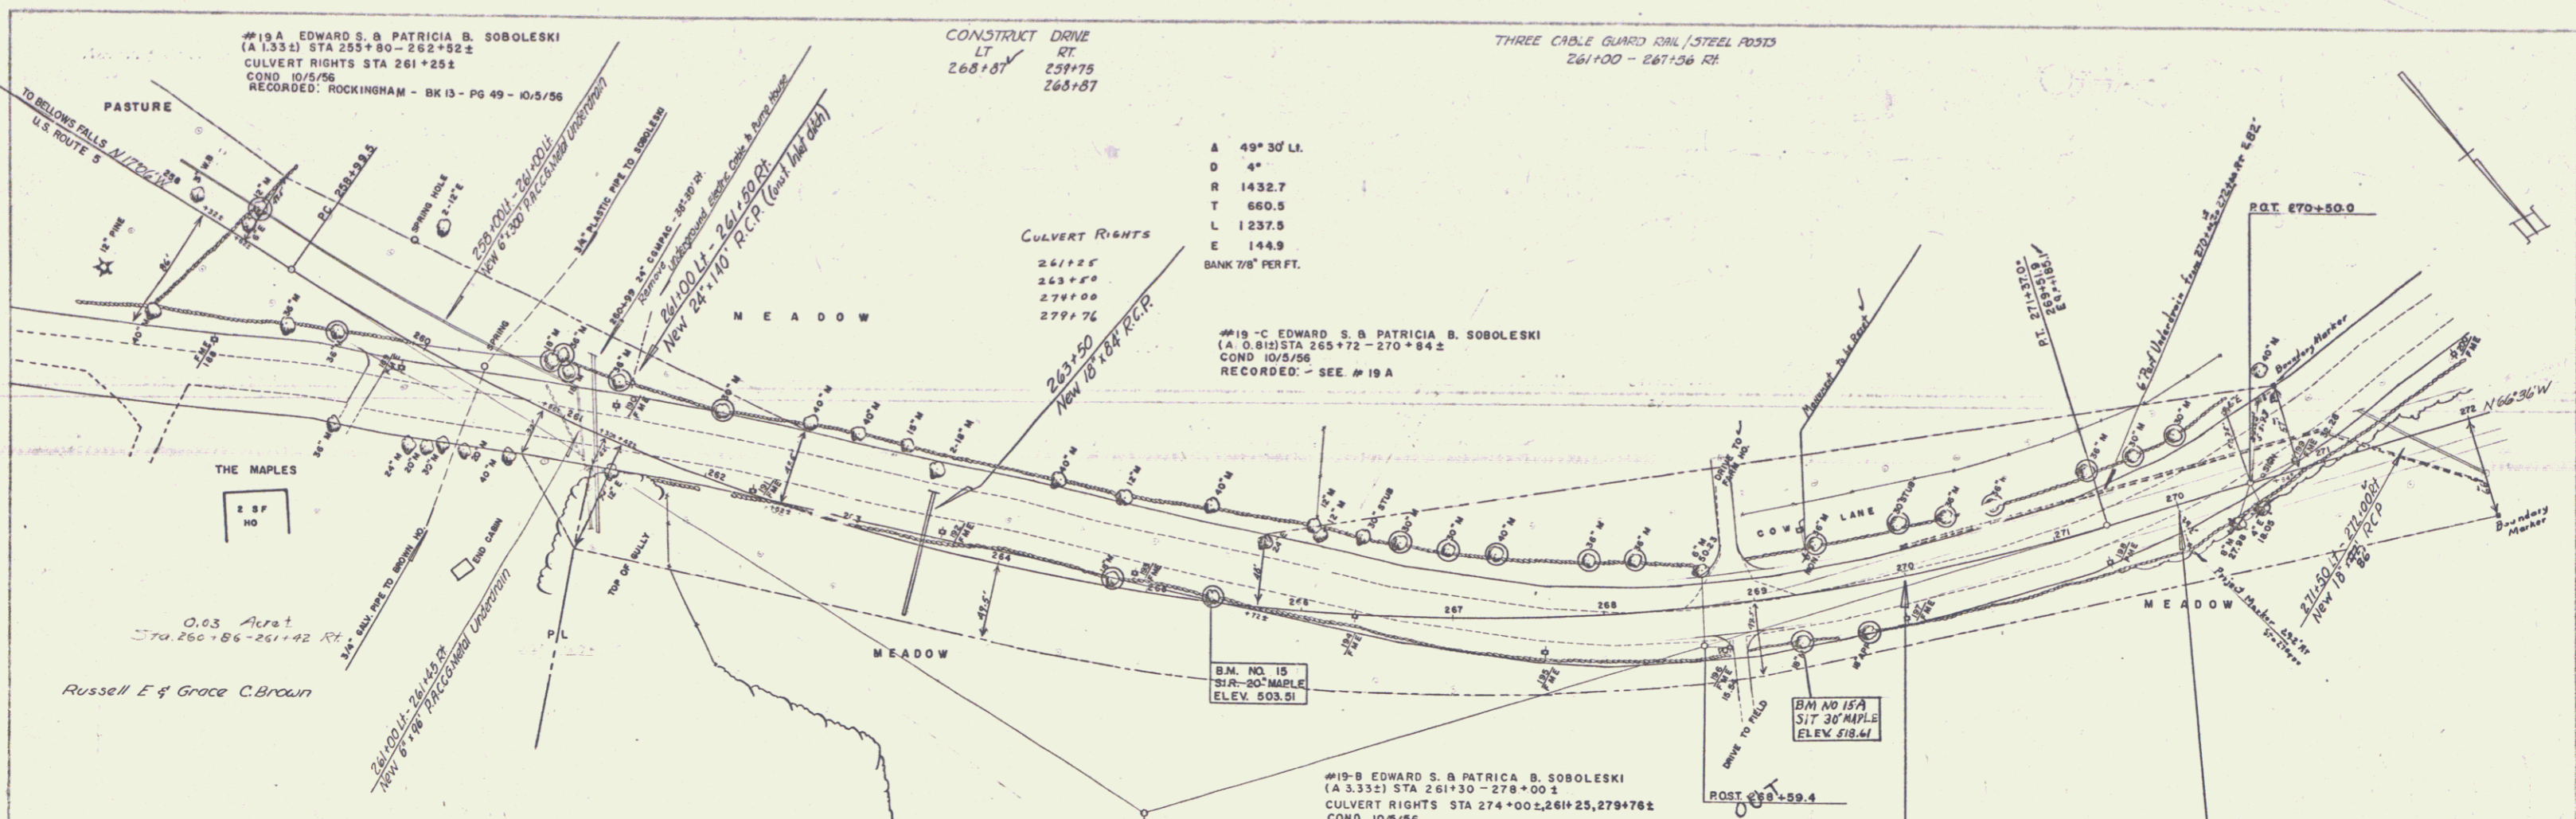

B.M. # 15, S.I.R. of 20' Maple, 5' W. of sta. 263+42, Elev. 503.51  
 B.M. # 15A, S.I.R. of 30' Maple, 31' N. of sta. 269+28, Elev. 518.61

ROCKINGHAM  
 PROJECT F 99 (B)  
 SHEET 7 OF 35