
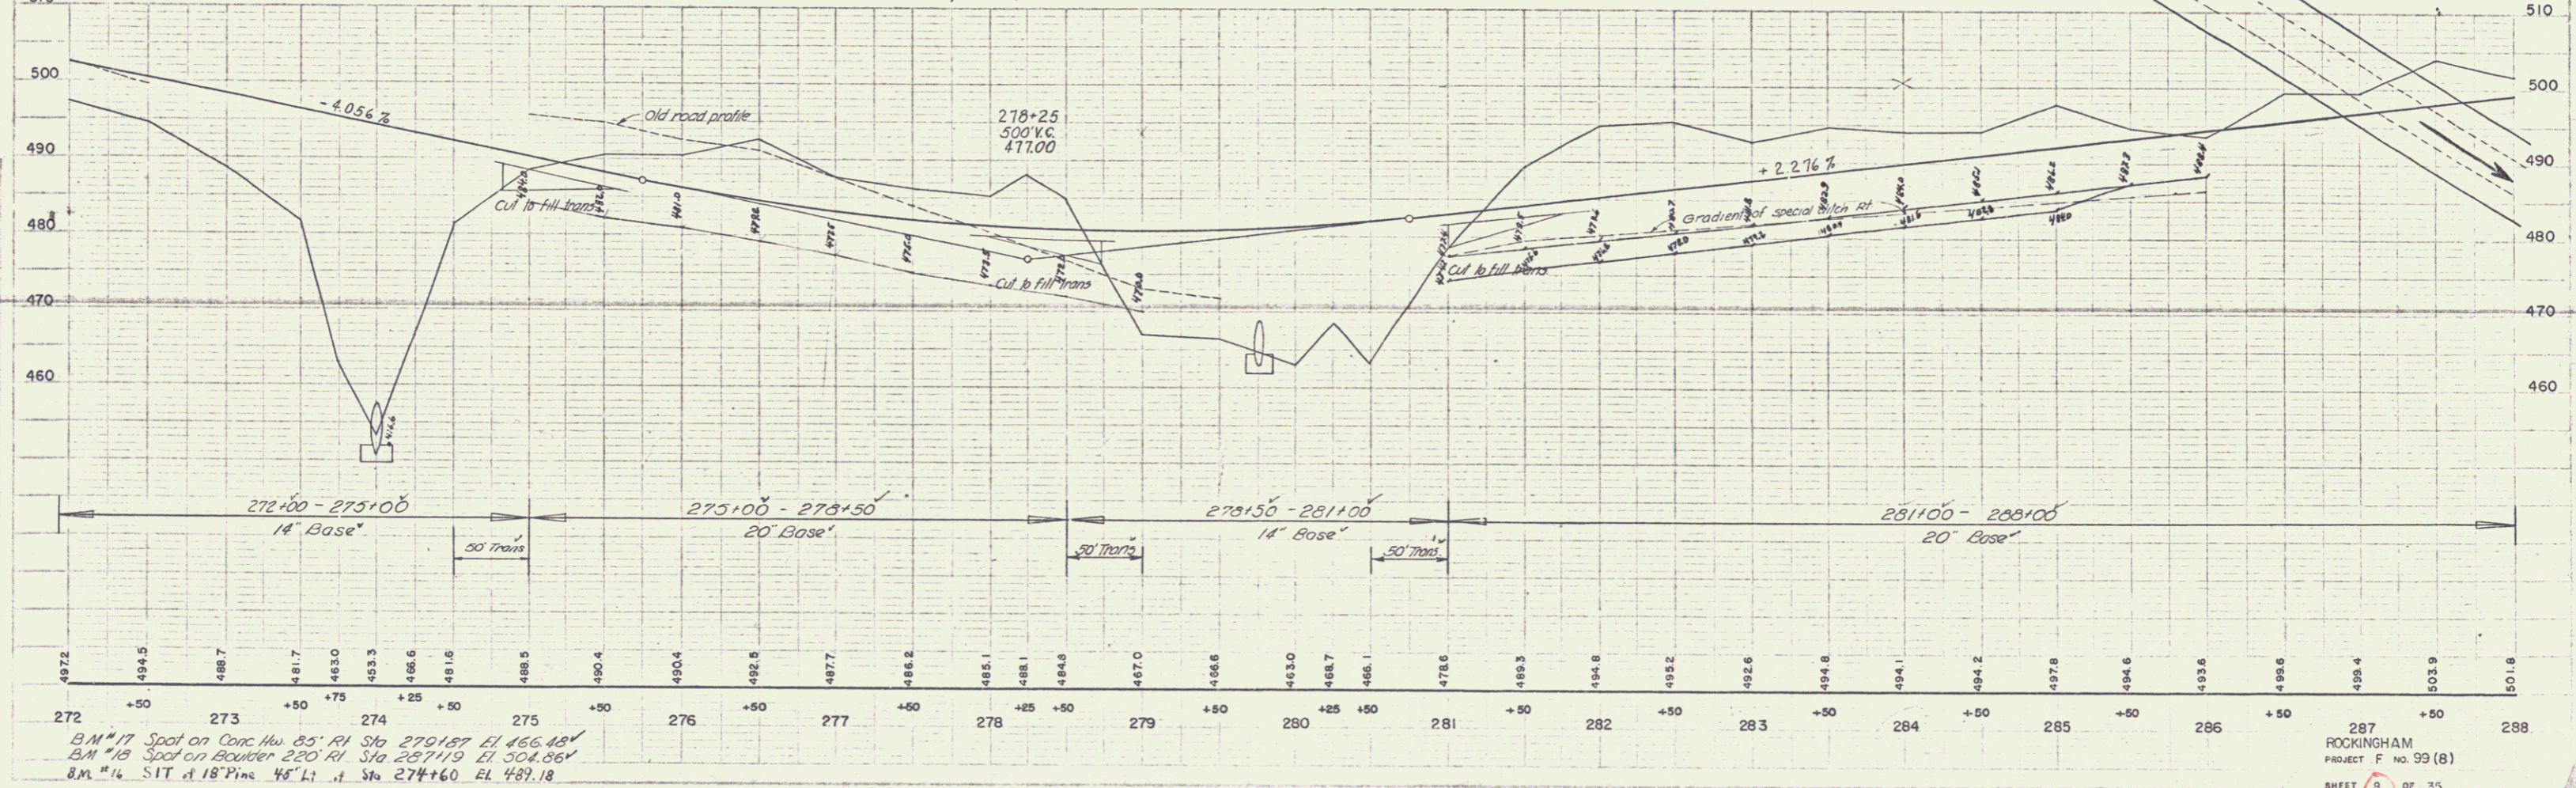


PLAN
 POINT
 A1A
 B-34
 B-34
 P-34
 TR

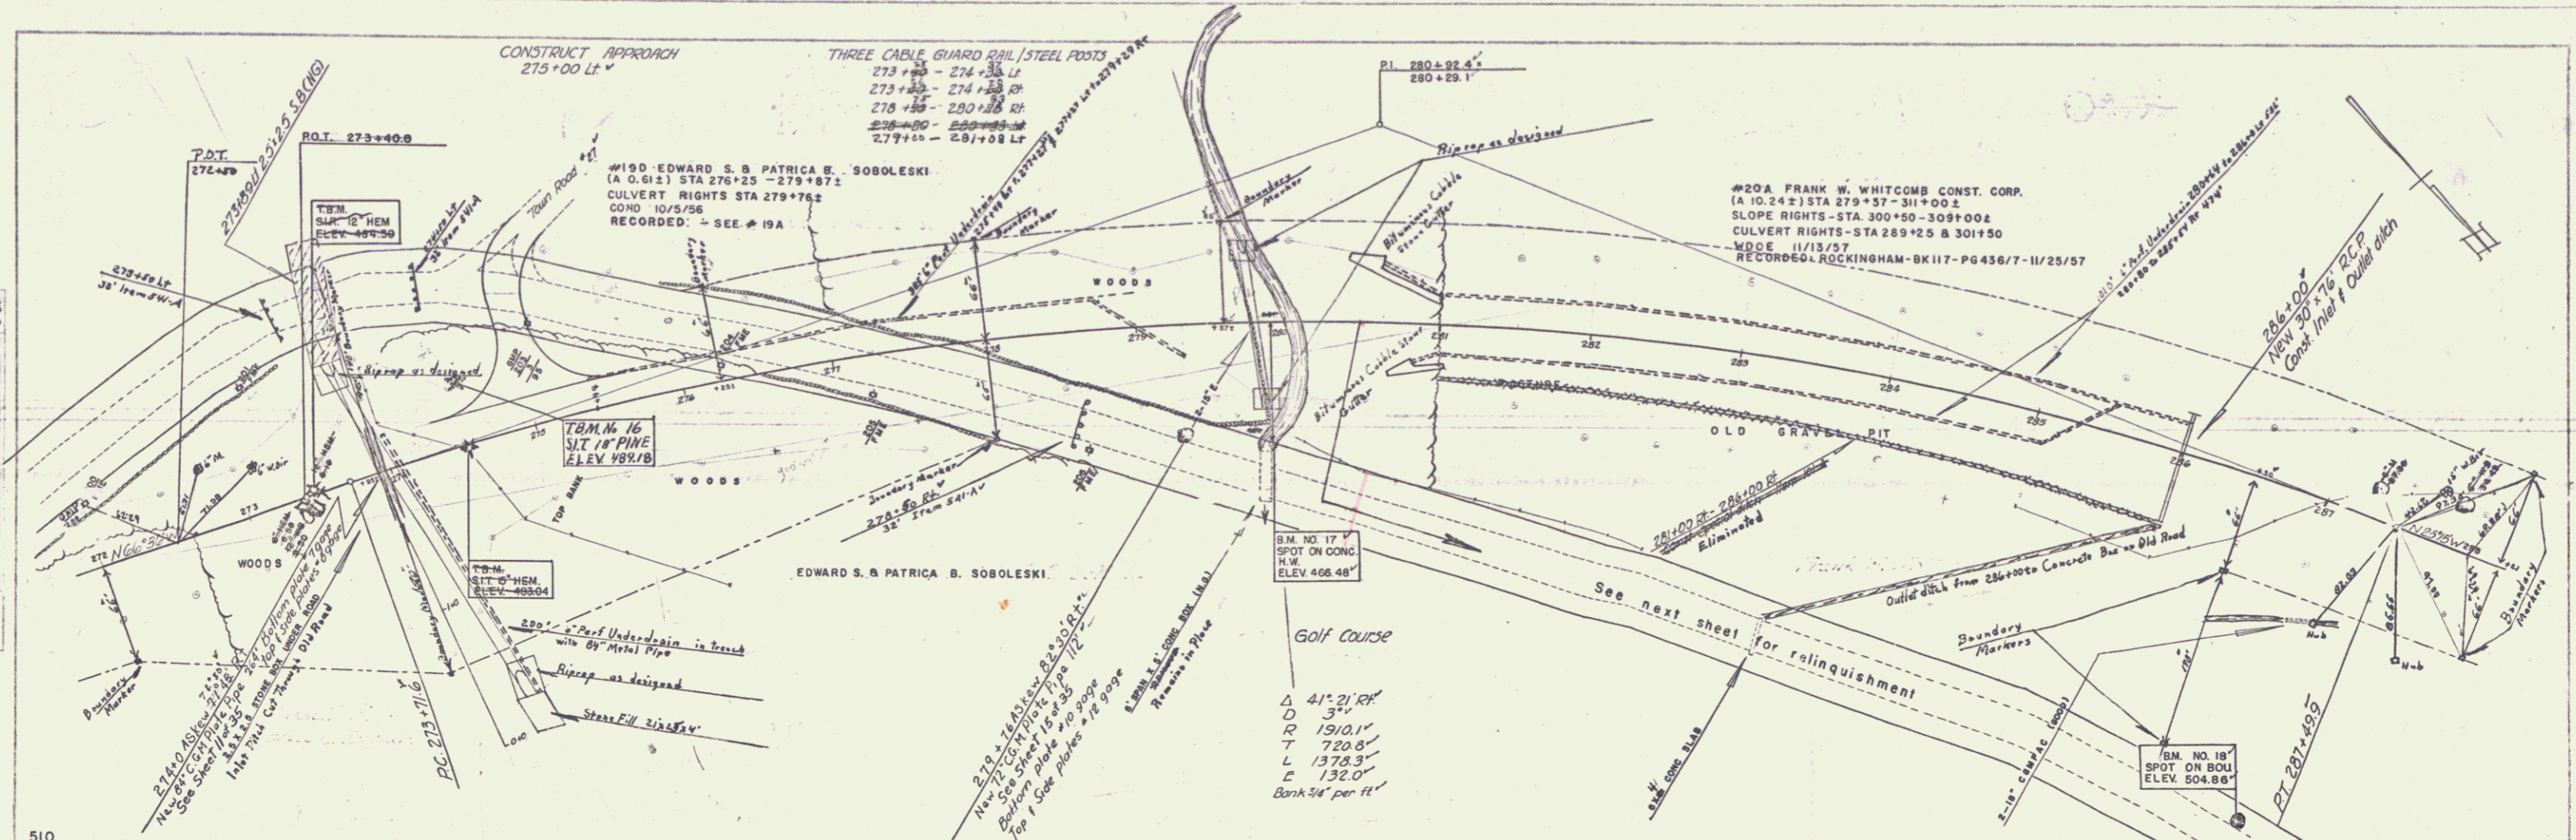

B.M. #17 Spot on Conc. No. 85' RI Sta 270+87 EL 456.42
 B.M. #18 Spot on Boulder 220' RI Sta 287+19 EL 504.96
 B.M. #14 SIT A 18' Pine 48' LI Sta 274+60 EL 489.18

287
 ROCKINGHAM
 PROJECT NO. 93 (B)
 SHEET 8 OF 35