
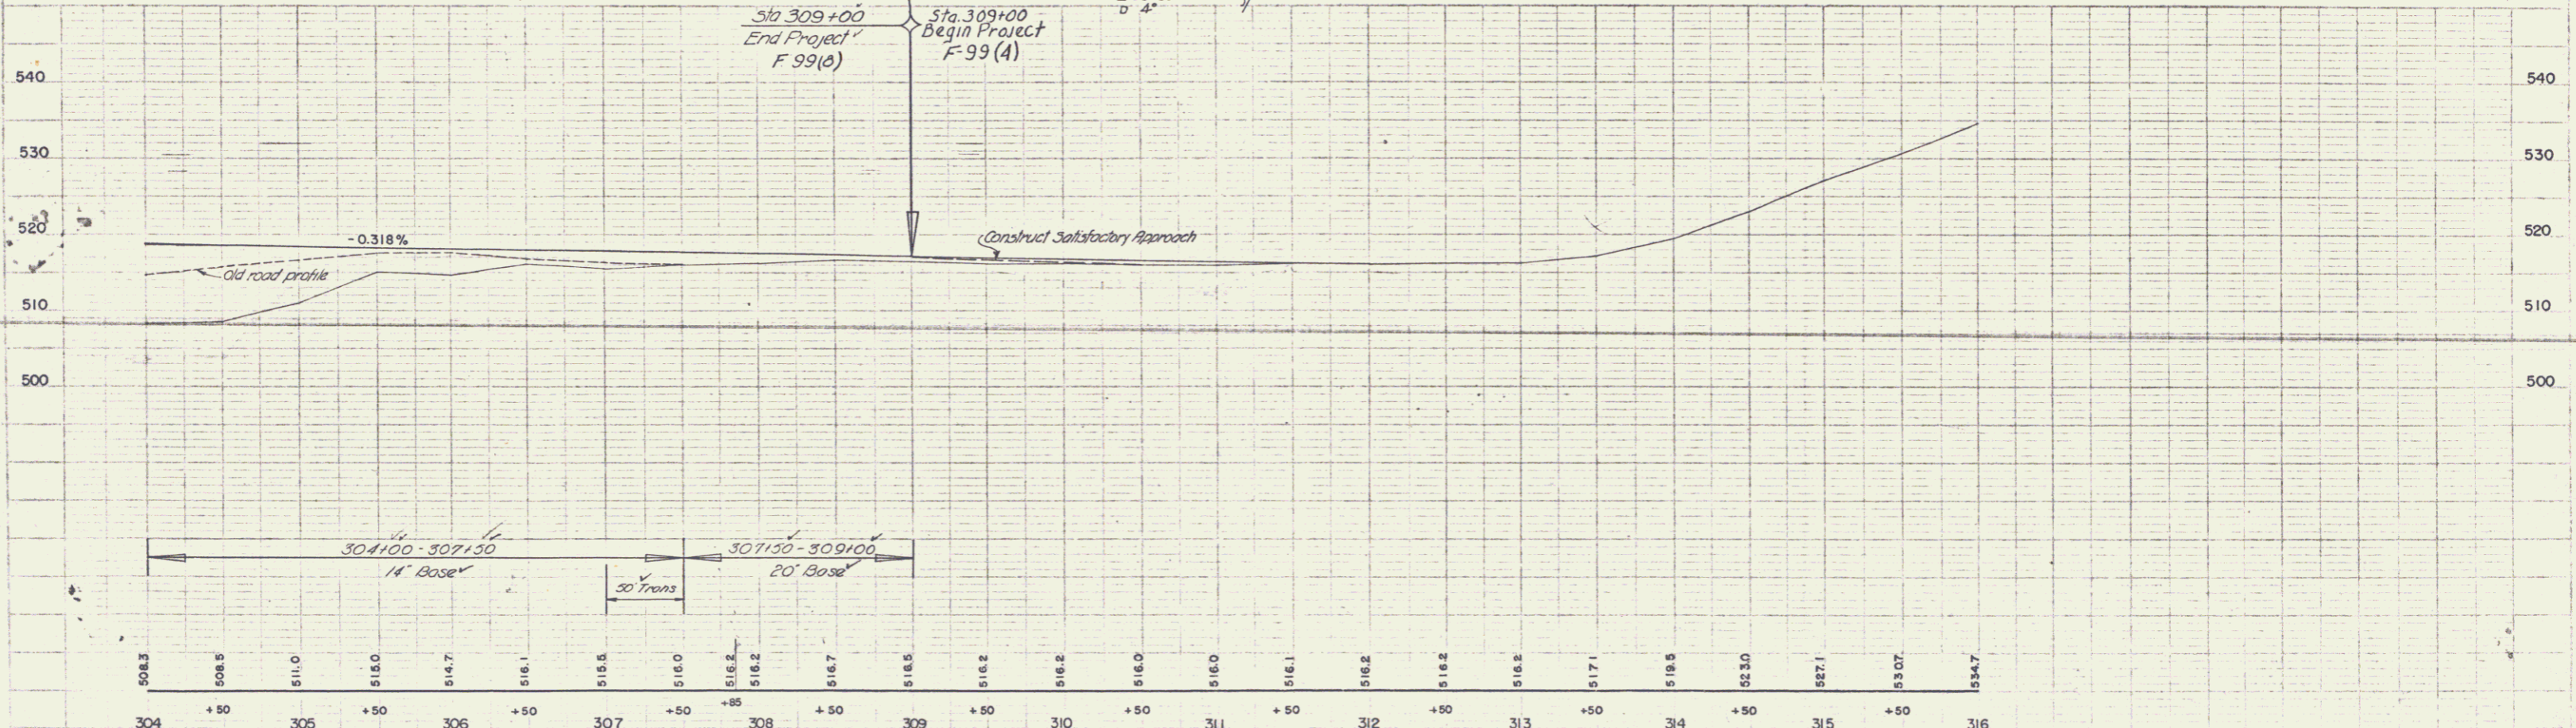


PLAN
 DATE 8-54
 DRAWN BY J.A.A.
 CHECKED BY J.A.A.
 TITLE
 NO.

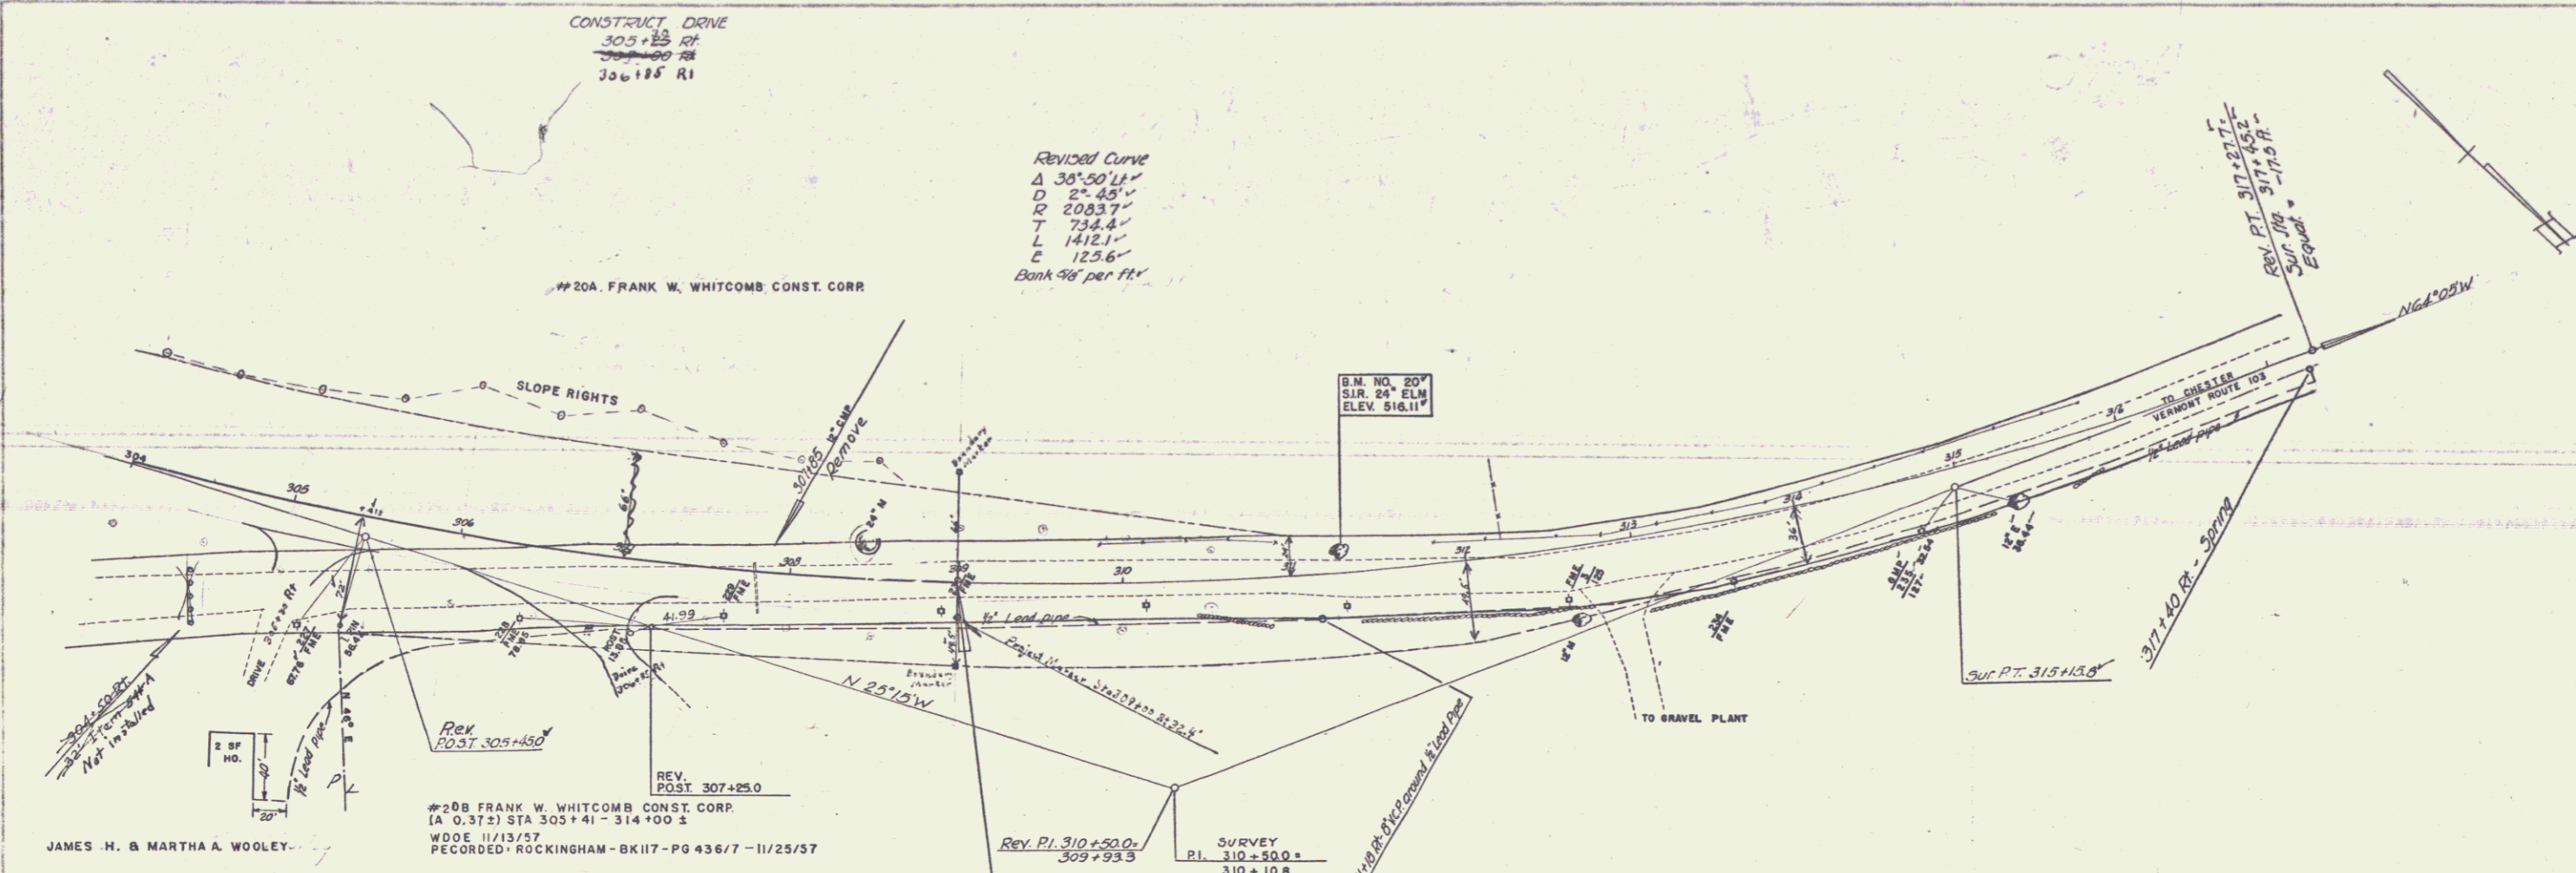

BM # 20 Spike in Root 24 Elm 15.4 Sta 311+31 El. 516.11'

5