
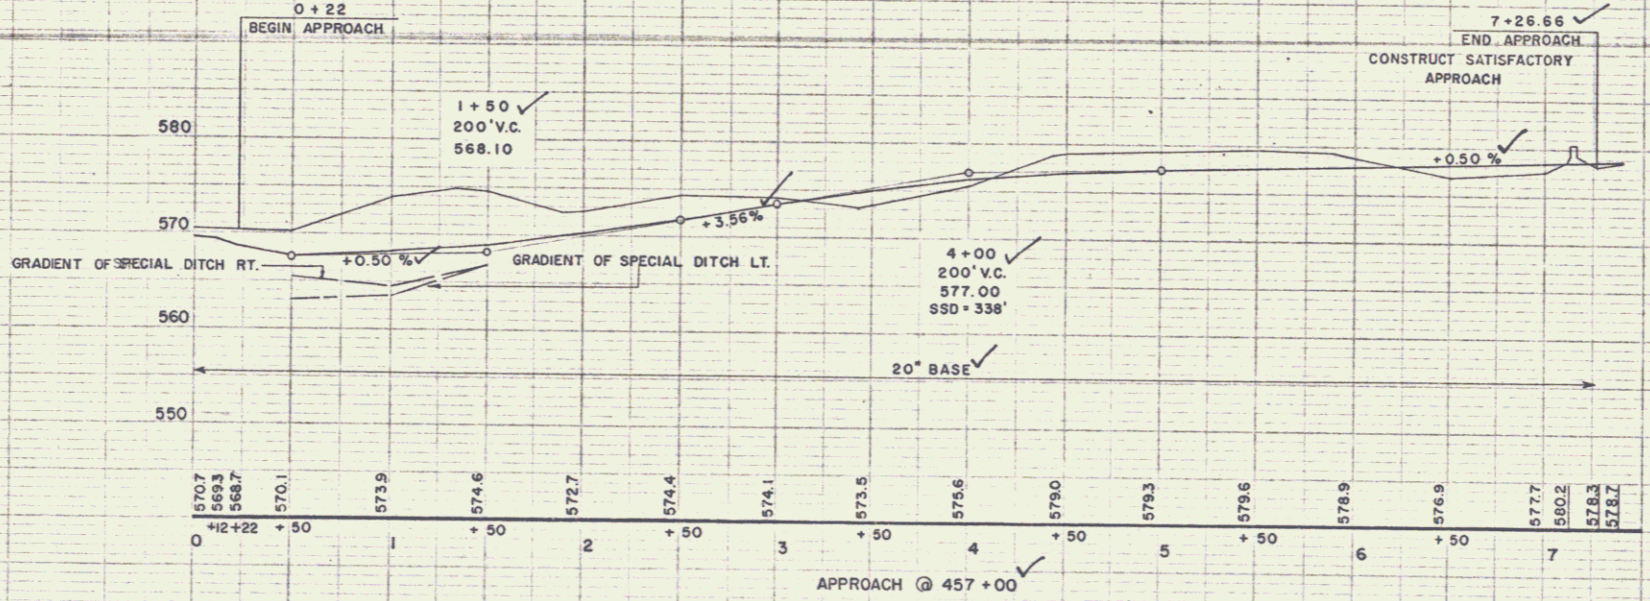


PLAN
 GORDON E. ANSWORTH & ASSOCIATES
 REGISTERED ENGINEERS, SURVEYORS
 and LANDSCAPE ARCHITECTS
 1072 BROAD ST. N.W. WASHINGTON, D.C. 20004

TITLE
 GORDON E. ANSWORTH & ASSOCIATES
 REGISTERED ENGINEERS, SURVEYORS
 and LANDSCAPE ARCHITECTS
 1072 BROAD ST. N.W. WASHINGTON, D.C. 20004

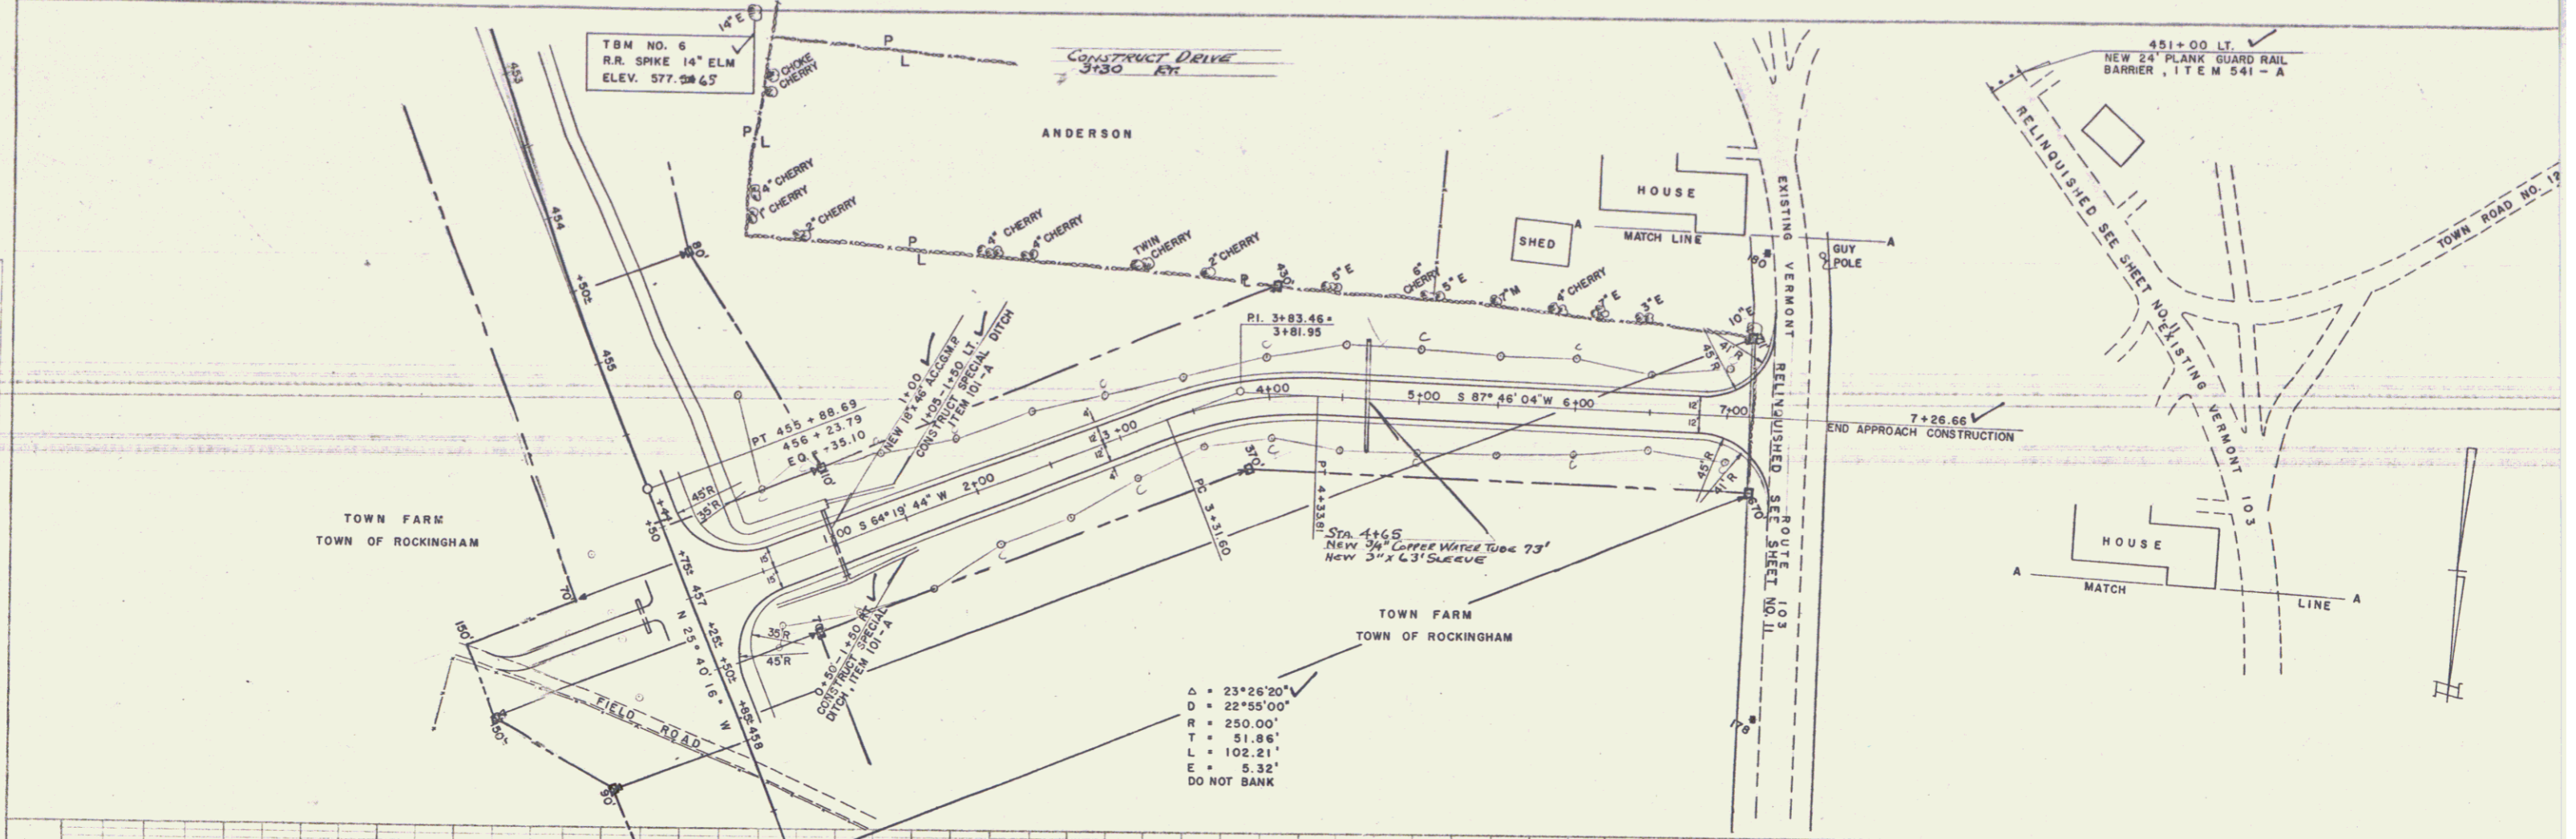

ROCKINGHAM-CHESTER
 PROJECT F No. 025-1(4)
 SHEET 14 OF 214
 GORDON E. ANSWORTH & ASSOCIATES
 REGISTERED ENGINEERS, SURVEYORS
 and LANDSCAPE ARCHITECTS

6