
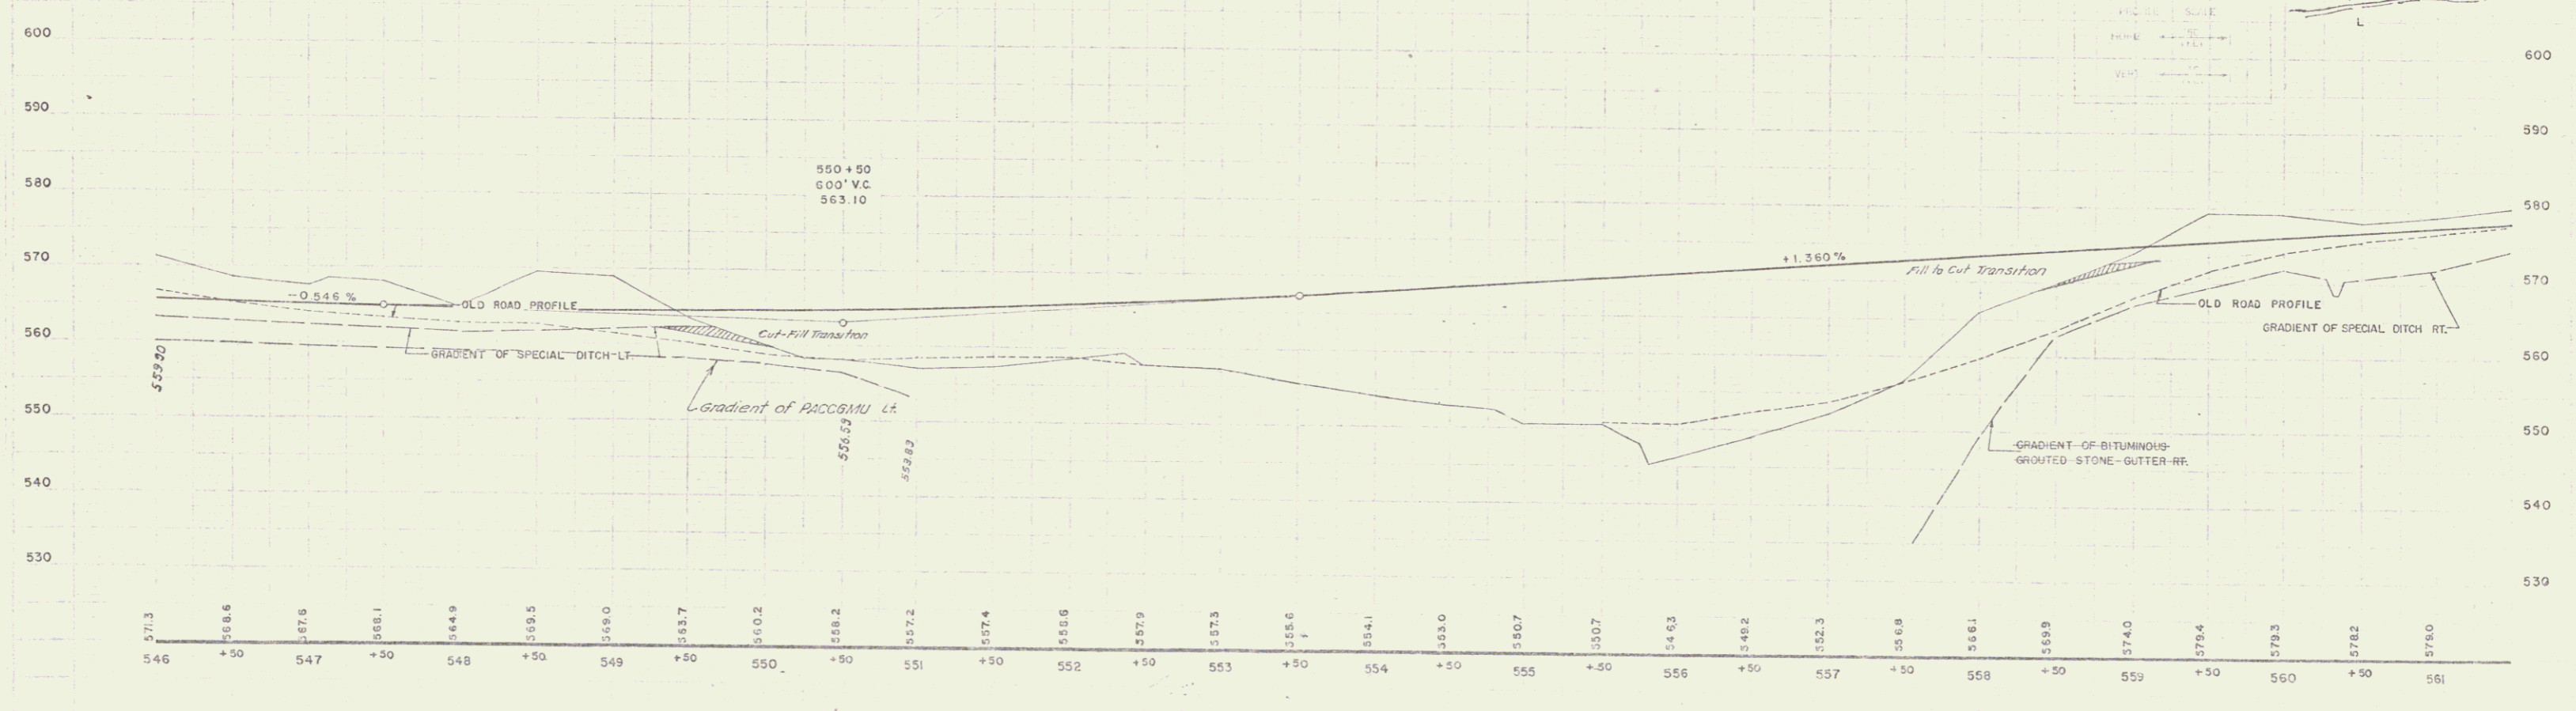


MUCK EXCAVATION ITEM 116
551+00 LT - 552+00 LT

Stone Fill for Slope Protection, Item 522
551+50 RT
557+00 RT
553+00 RT
553+00 RT

THREE CABLE GUARD RAIL	
W/STEEL POSTS	
548+00 - 548+96	RT
556+00 - 557+92	LT
549+25 - 557+00	RT
555+70 - 558+30	LT

CONSTRUCT DRIVE	
551+90	LT
553+80	LT
555+80	LT
558+80	LT
560+30	LT
559+00	RT

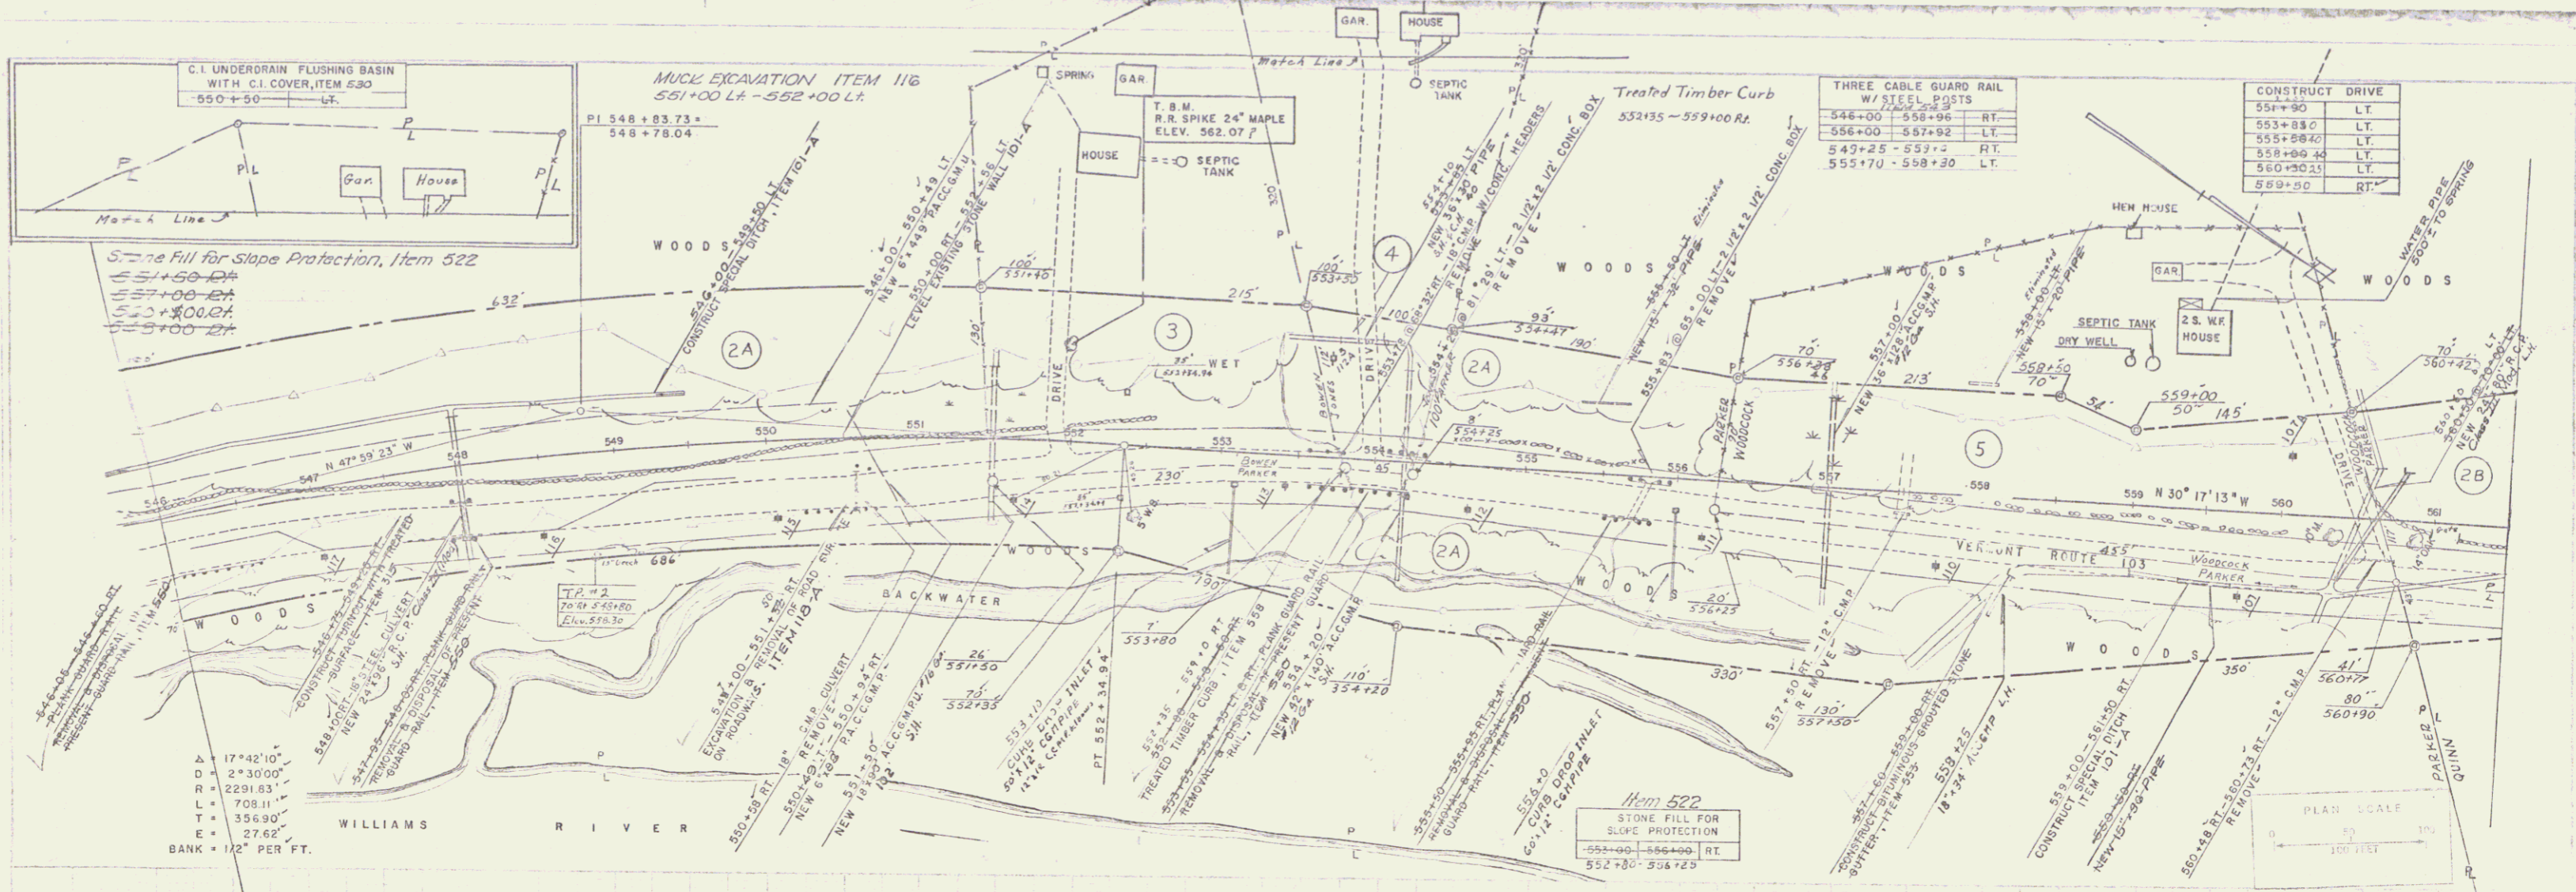

COURTESY OF THE NEW YORK STATE DEPARTMENT OF TRANSPORTATION

COURTESY OF THE NEW YORK STATE DEPARTMENT OF TRANSPORTATION