


PLAN
 DRAWN BY: [blank]
 CHECKED BY: [blank]
 DATE: [blank]

PROFILE
 DRAWN BY: [blank]
 CHECKED BY: [blank]
 DATE: [blank]

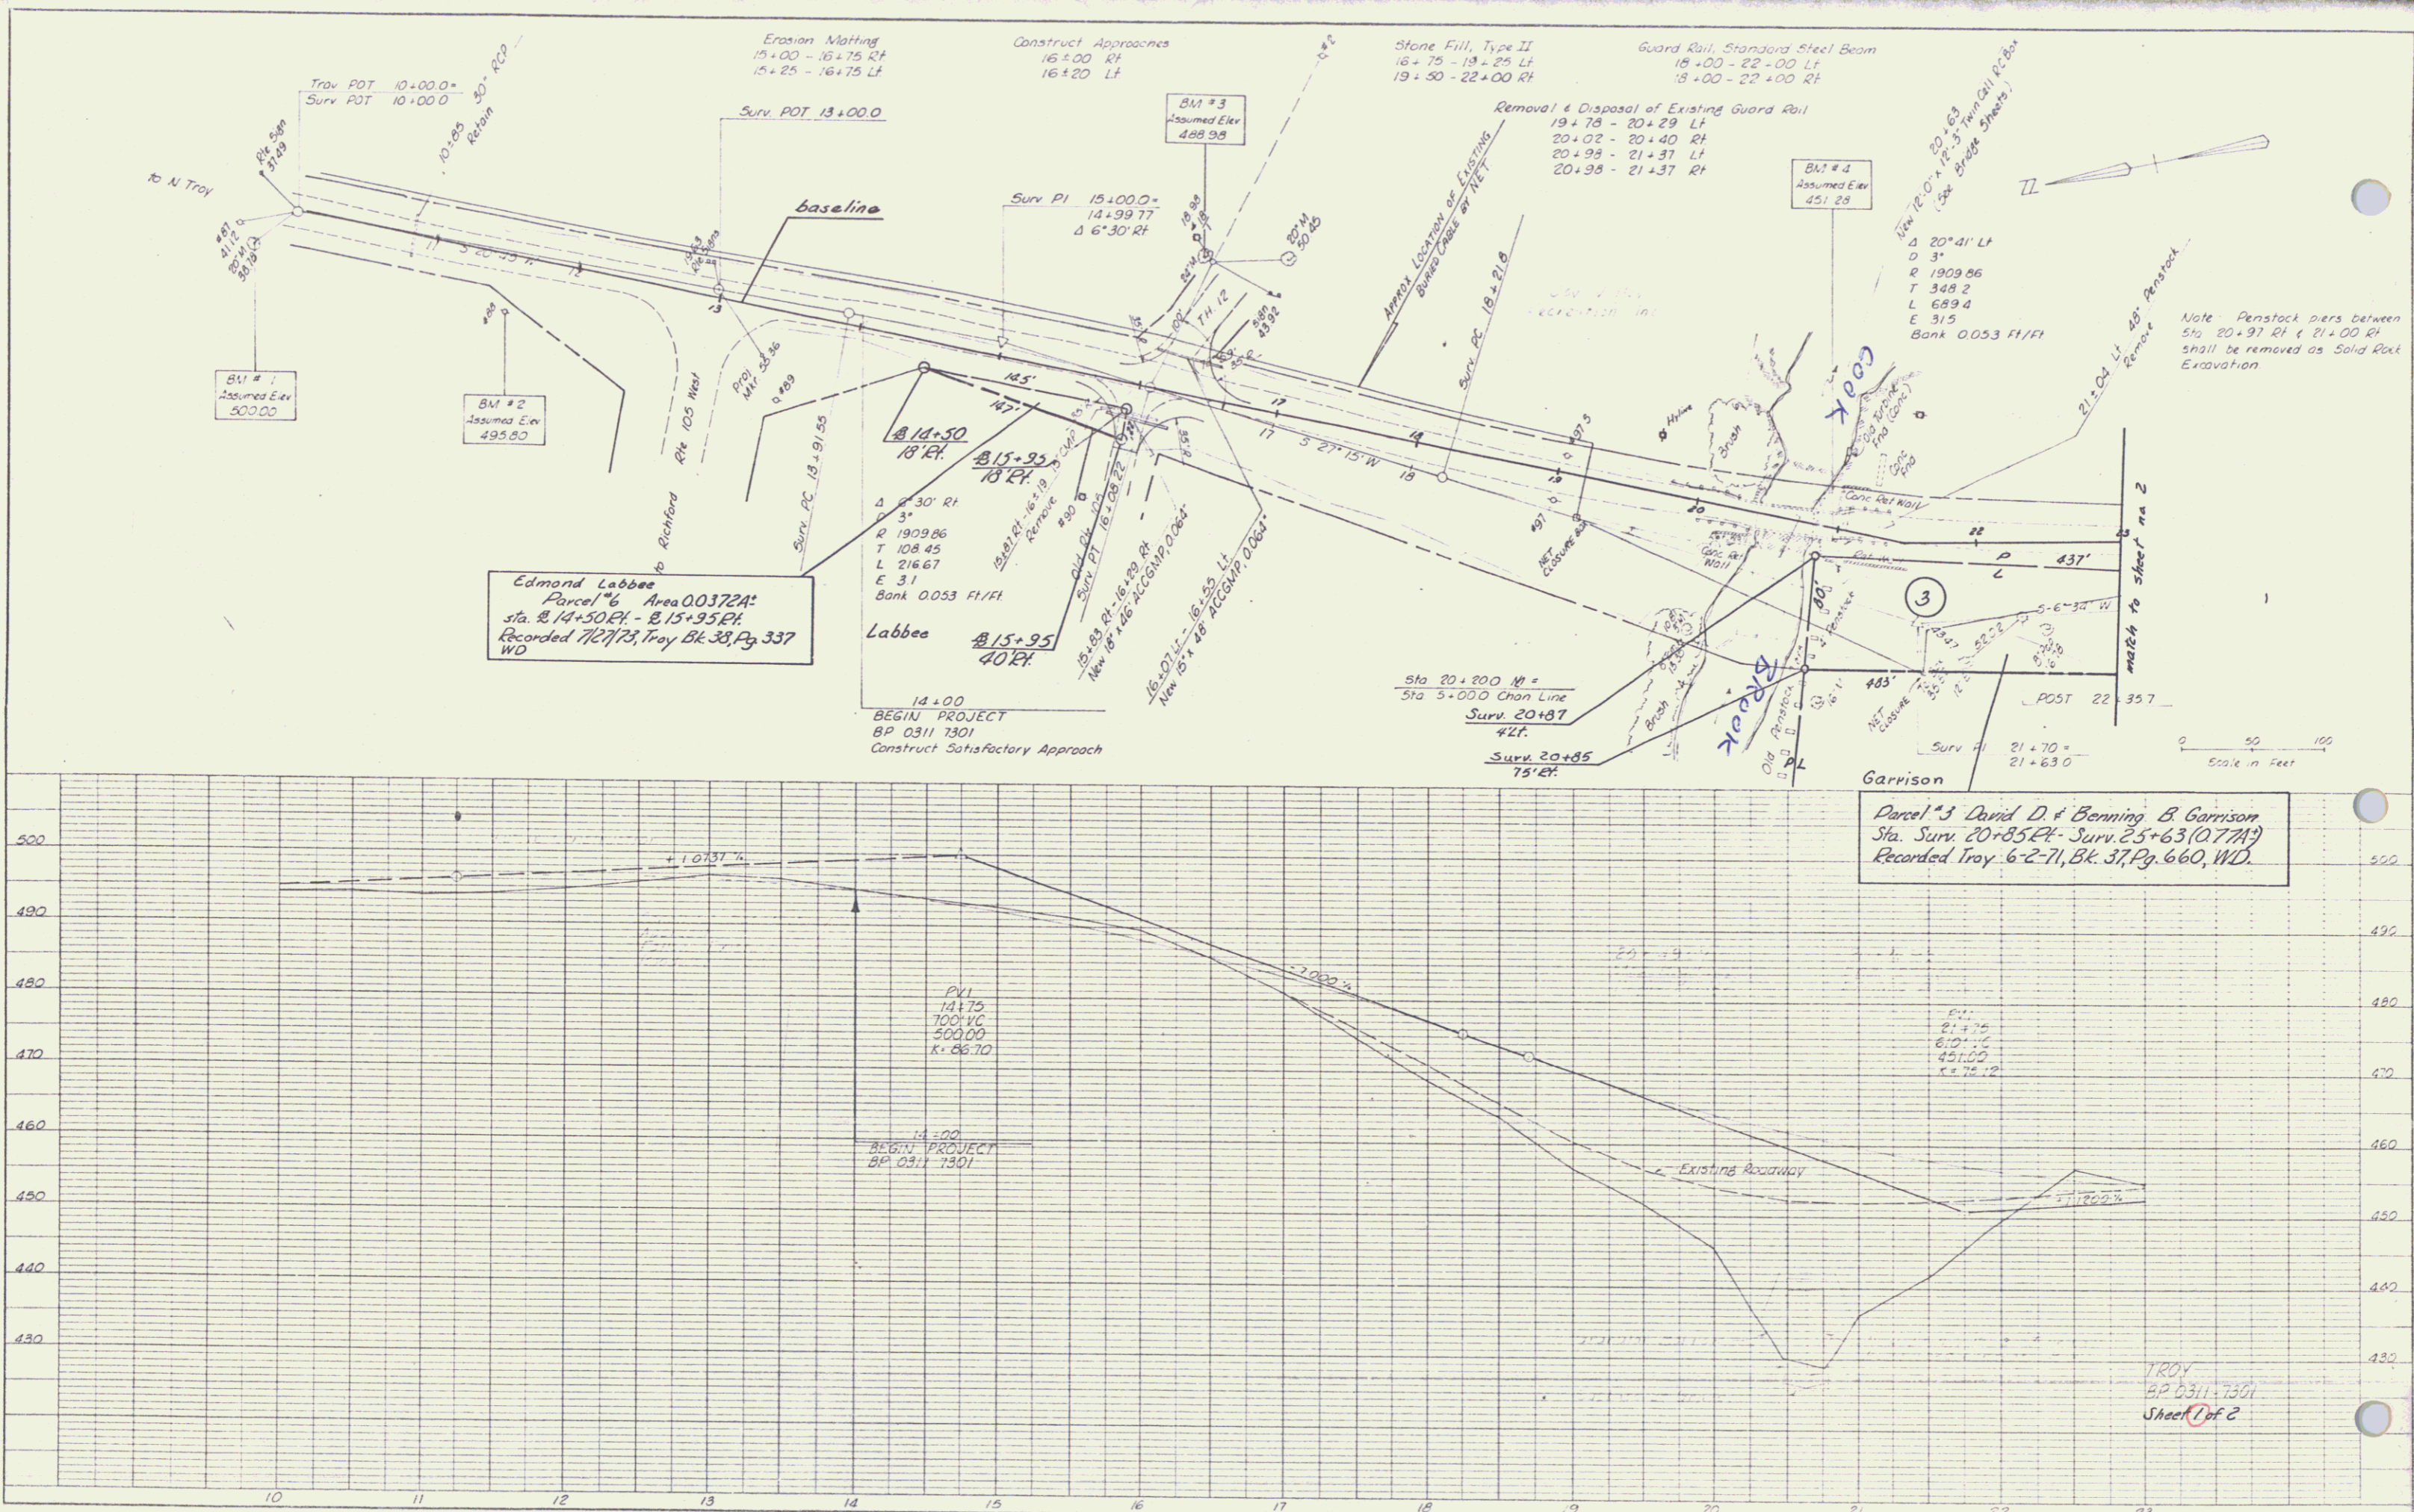

Edmond Labbee
 Parcel #6 Area 0.0372A
 Sta. 14+50.00 - 15+95.00
 Recorded 7/27/73, Troy, Bk. 38, Pg. 337
 WD

Parcel #3 David D & Benning & Garrison
 Sta. Surv. 20+85.00 - Surv. 25+63.00 (0.77A)
 Recorded Troy 6-2-71, Bk. 37, Pg. 660, WD