



PLAN
 SHEET NO. 66(3) 1947 5 36
 DATE 12-46
 DRAWN BY P. Barry
 CHECKED L. Jones

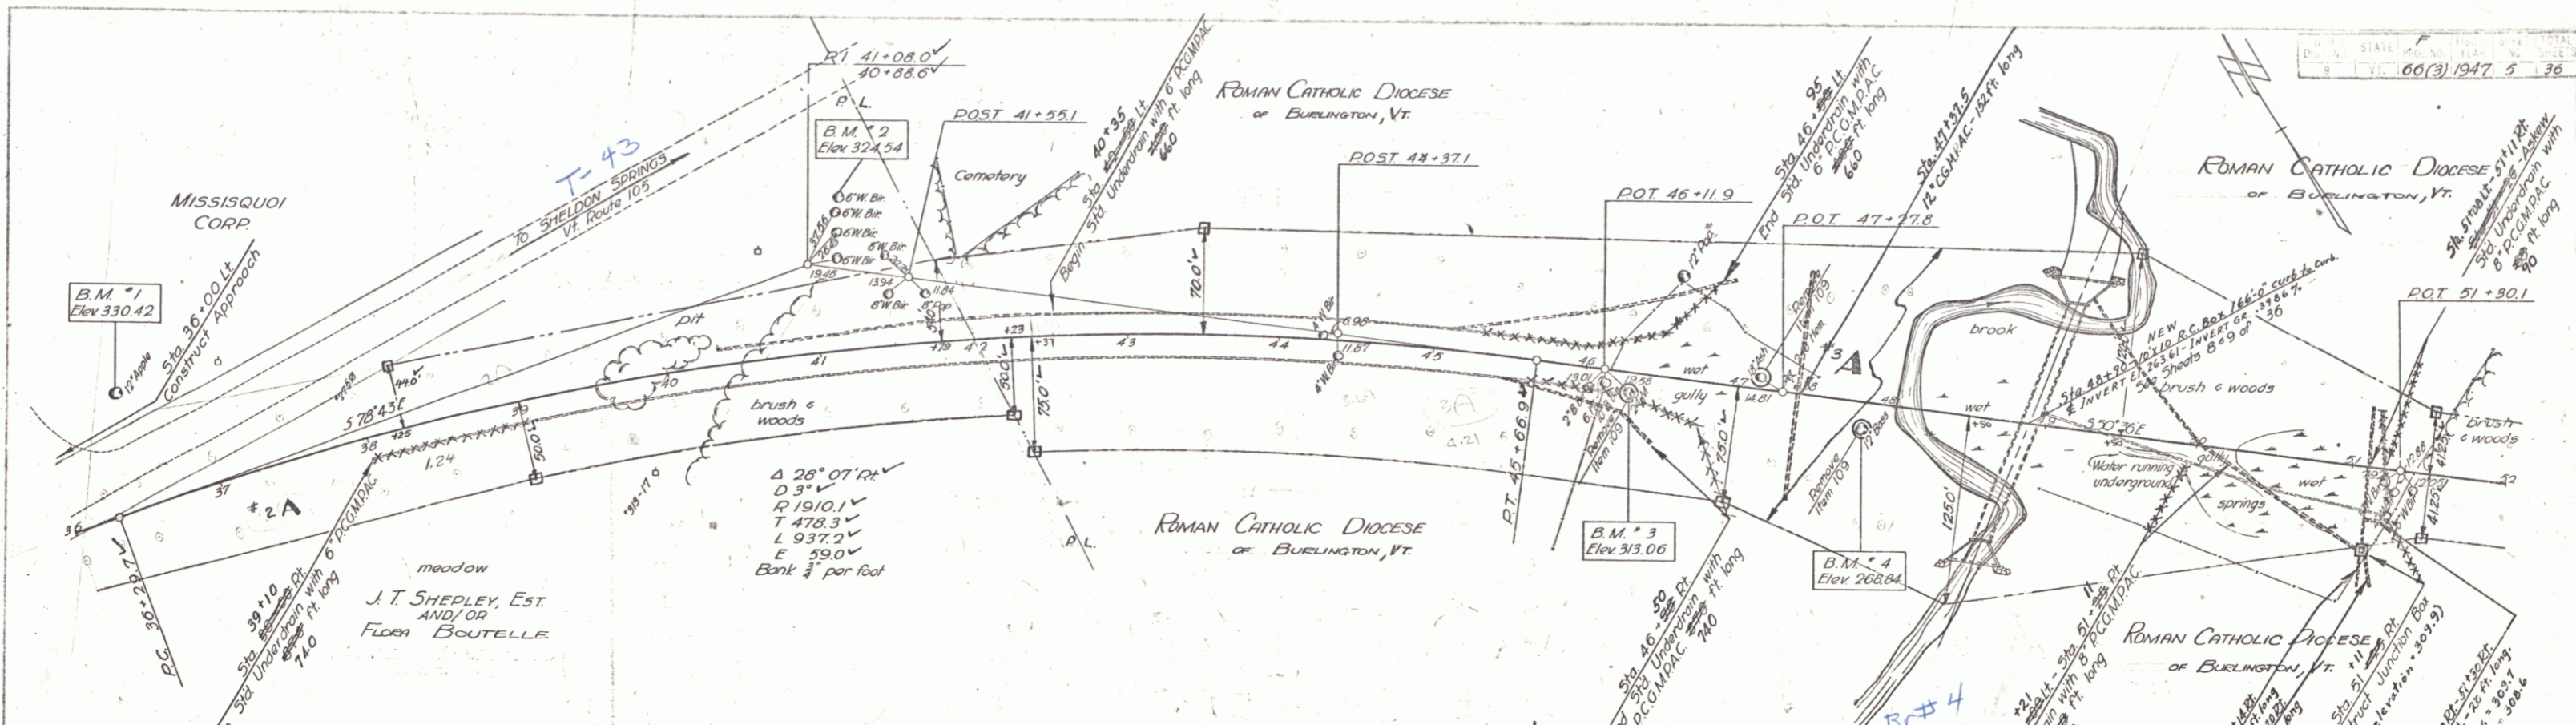

PARCEL	INSTRUMENT	DATE	GRANTOR	GRANTEE	RECORDED SHELDON	REMARKS
* 3 A	WARRANTY DEED II-4-47		ROMAN CATHOLIC DIOCESE OF BURLINGTON, VT.	ST. OF VT. 23	PAGE 23	314-15-16 11-13-47
* 4 A	Parcel on SHEET 'C'	COND.	CENTRAL VERMONT RAILWAY, INC.	ST. OF VT. 25	294-298	10-10-47

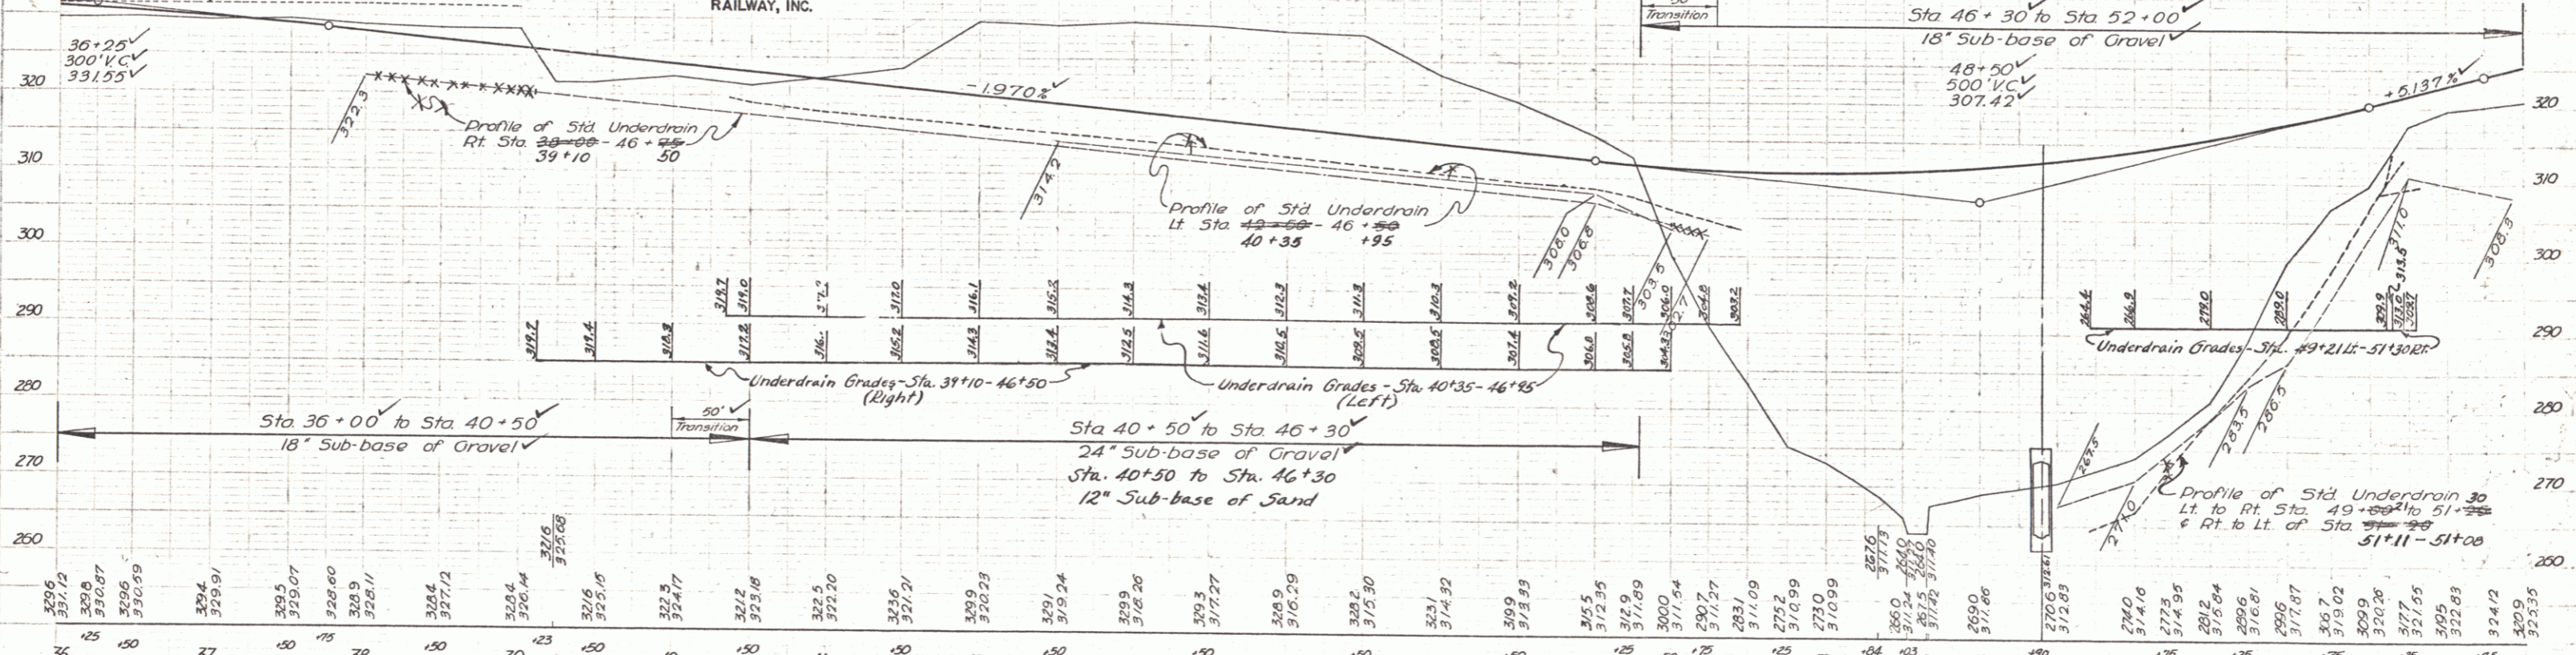

B.M. #1 Spike in root of 12' Apple 75 ft Lt Sta 36+56 Elev 330.42
 B.M. #2 Spike in trunk of 6' White Birch 98 ft Lt Sta 41+19 Elev 324.54
 B.M. #3 Spike in root of 24' Maple 9 ft Rt Sta 46+29 Elev 313.06
 B.M. #4 Spike in root of 12' Bass 13 ft Rt Sta 47+81 Elev 268.84

SHELDON Series F. No. 66(3) Sheet 5 of 36