


PLAN  
 SHELDON  
 DISTRICT OFFICE  
 1947  
 TRACED  
 L. GORAN

PLAN  
 SHELDON  
 DISTRICT OFFICE  
 1947  
 TRACED  
 L. GORAN

PARCEL	INSTRUMENT	GRANTOR	GRANTEE	RECORDED SHELDON	REMARKS
*5A	W.D.O.E.	GEORGE W. & HATTIE CANTELL	ST. OF VT.	23 312-313	11-13-47
*7A	WARRANTY DEED	MISSISQUI CORP.	" "	23 317-318	11-13-47
*4A	W.D.O.E.	STEPHEN B. COLLINS	" "	23 319-320	11-13-47
*4A	Retention Dam				+0.655%
*6A	COND.	ADLORE H. & DELLA A. MACIA	ST. OF VT.	23 294-298	10-10-47 SEE W.D.O.E.
*8A/B	WARRANTY DEED	PAUL M. & NELLIE M. GONYEAU	ST. OF VT.	23 321-322	11-13-47 11-22-50

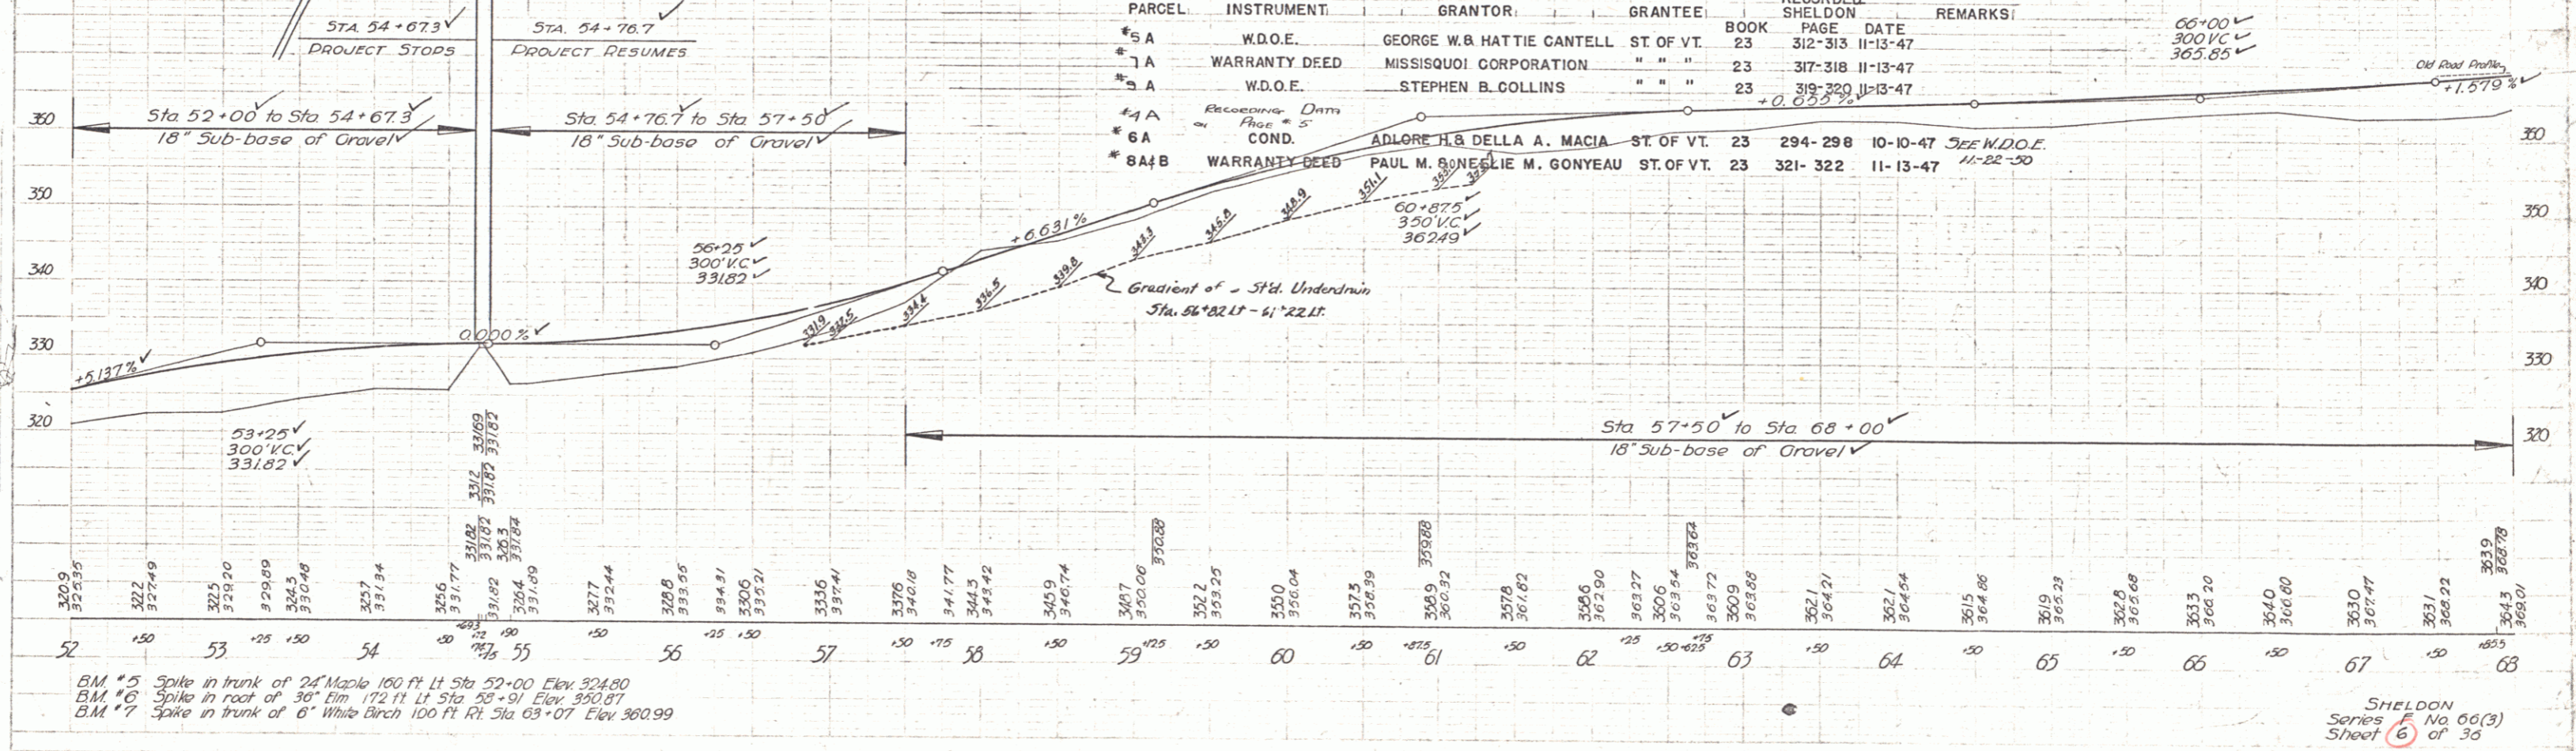

BM #5 Spike in trunk of 24" Maple 100 Ft Lt Sta 52+00 Elev. 324.80  
 BM #6 Spike in root of 30" Elm 172 Ft Lt Sta 58+91 Elev. 350.87  
 BM #7 Spike in trunk of 6" White Birch 100 Ft Rt Sta 63+07 Elev. 360.99