
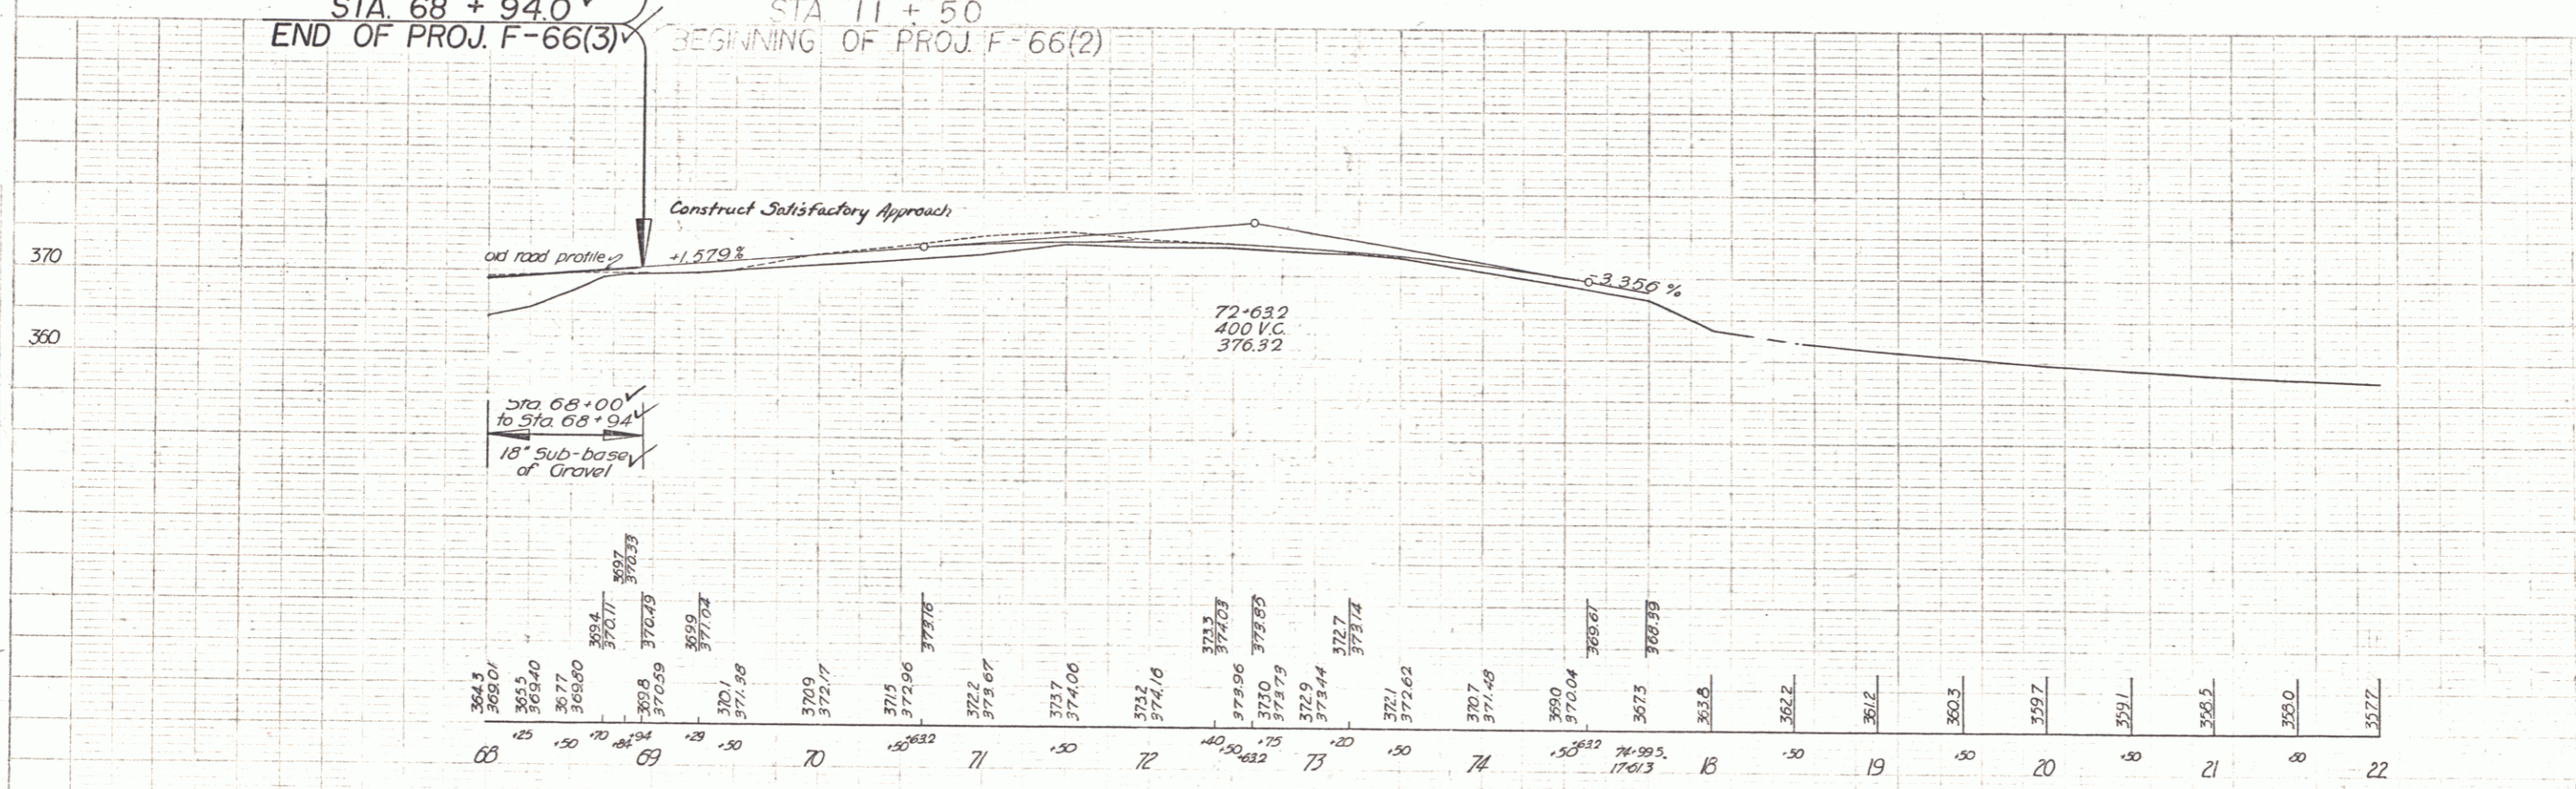


PARCEL	INSTRUMENT	DATE	GRANTOR	GRANTEE	RECORDED	REMARKS
#8 A & B	WARRANTY DEED	11-7-47	PAUL M. & NELLIE M. GONYEAU	ST. OF VT.	23	321-322 11-13-47

STATE	PROJ. NO.	YEAR	SHEET NO.	TOTAL SHEETS
VT.	66(3)	1947	7	36

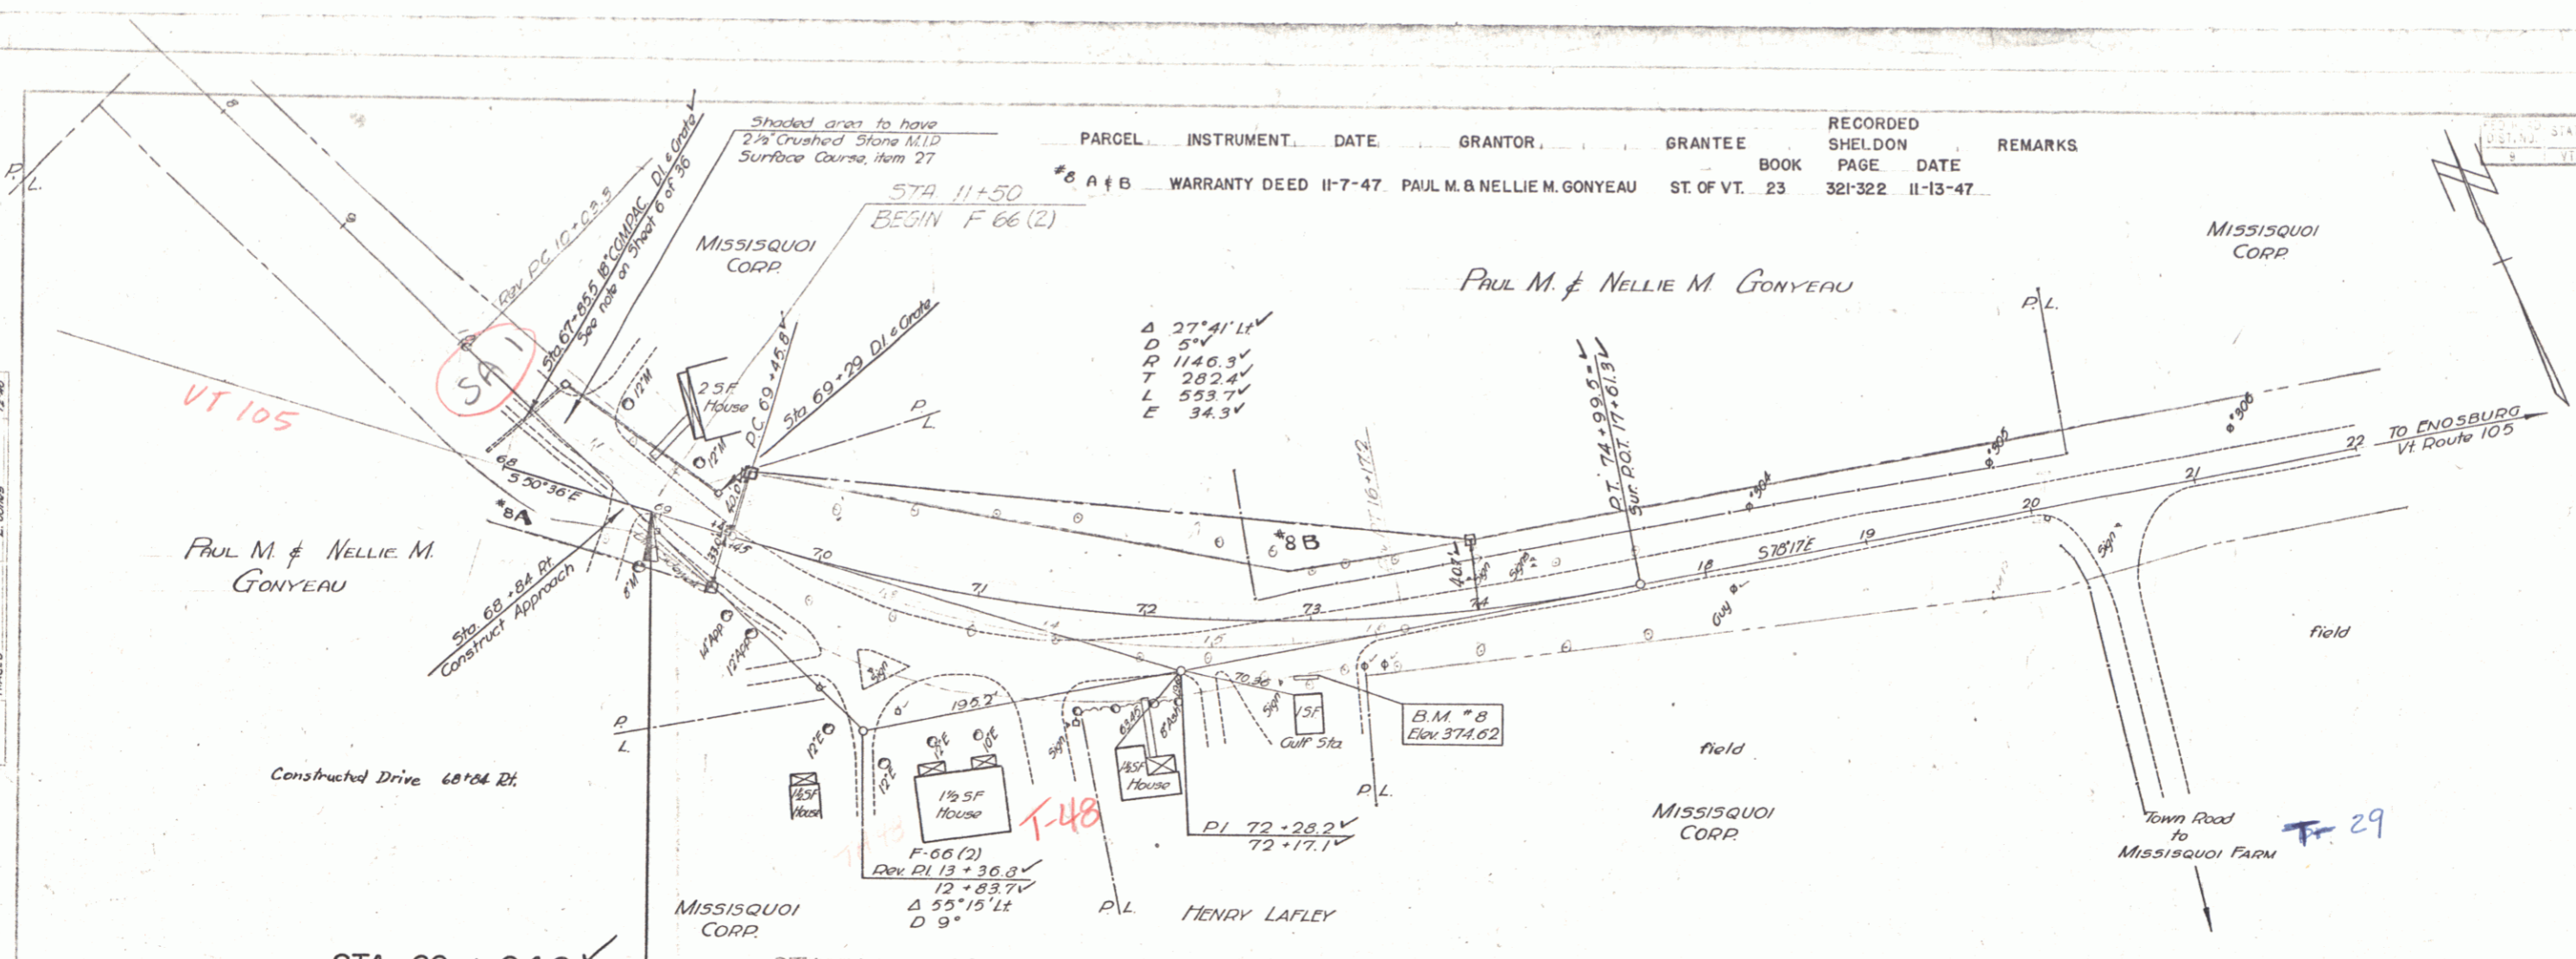

PLAN
DATE: 11-13-47
BY: B. B. B. / L. L. L.
CHECKED: /
NOTED: /

PROFILE
DATE: 11-13-47
BY: B. B. B. / L. L. L.
CHECKED: /
NOTED: /

SHELDON
Series F No. 66(3)
Sheet 7 of 36